



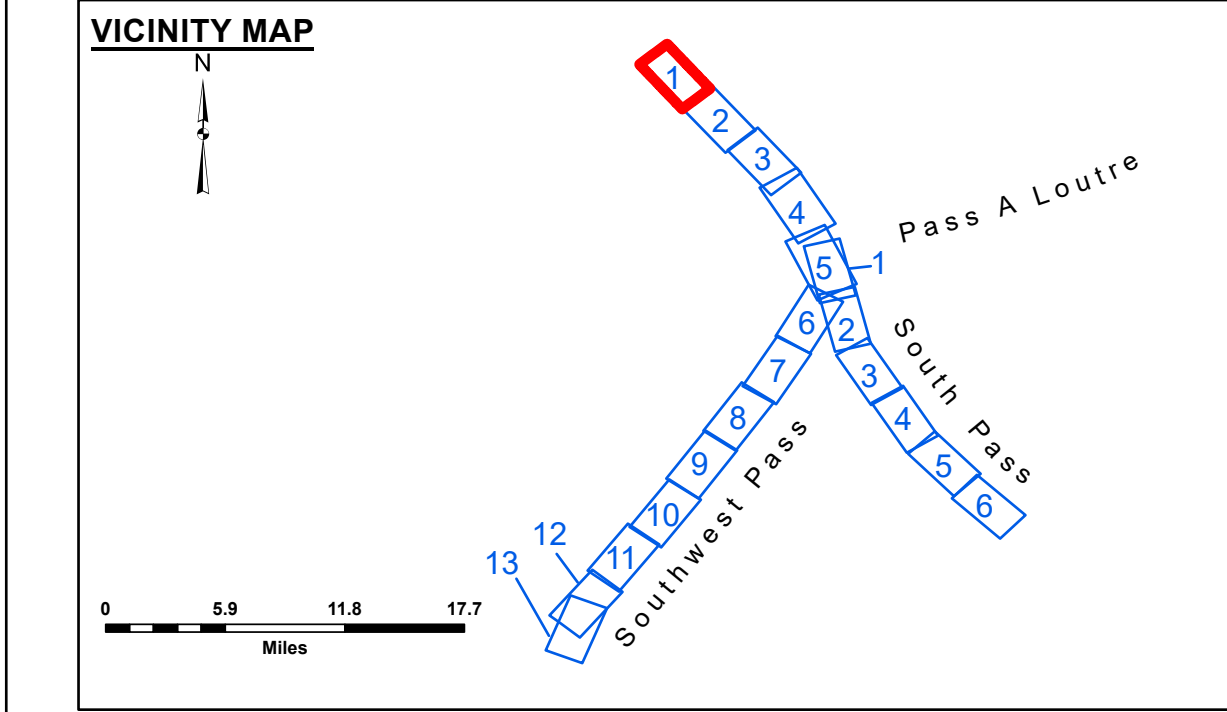

LEGEND

- Federal Navigation Channel
- Federal Navigation Center Line
- As-built Pipeline/Cable
- Unconfirmed Pipeline/Cable
- Project Depth Contour
- Cable Area
- Placement Area
- Anchorage Area
- ⊗ Obstruction Point
- ✱ Wrecks-Submerged
- 3 Fluff Thickness (feet)*
- Borrow Area
- Shoalest Sounding**
- ☆ Beacon, General
- ◆ Red Navigation Buoy
- ◆ Green Navigation Buoy
- -10' and above
- -10' to -20'
- -20' to -30'
- -30' to -40'
- -40' to -45'
- -45' to -50'
- -50' to -55'
- -55' and below

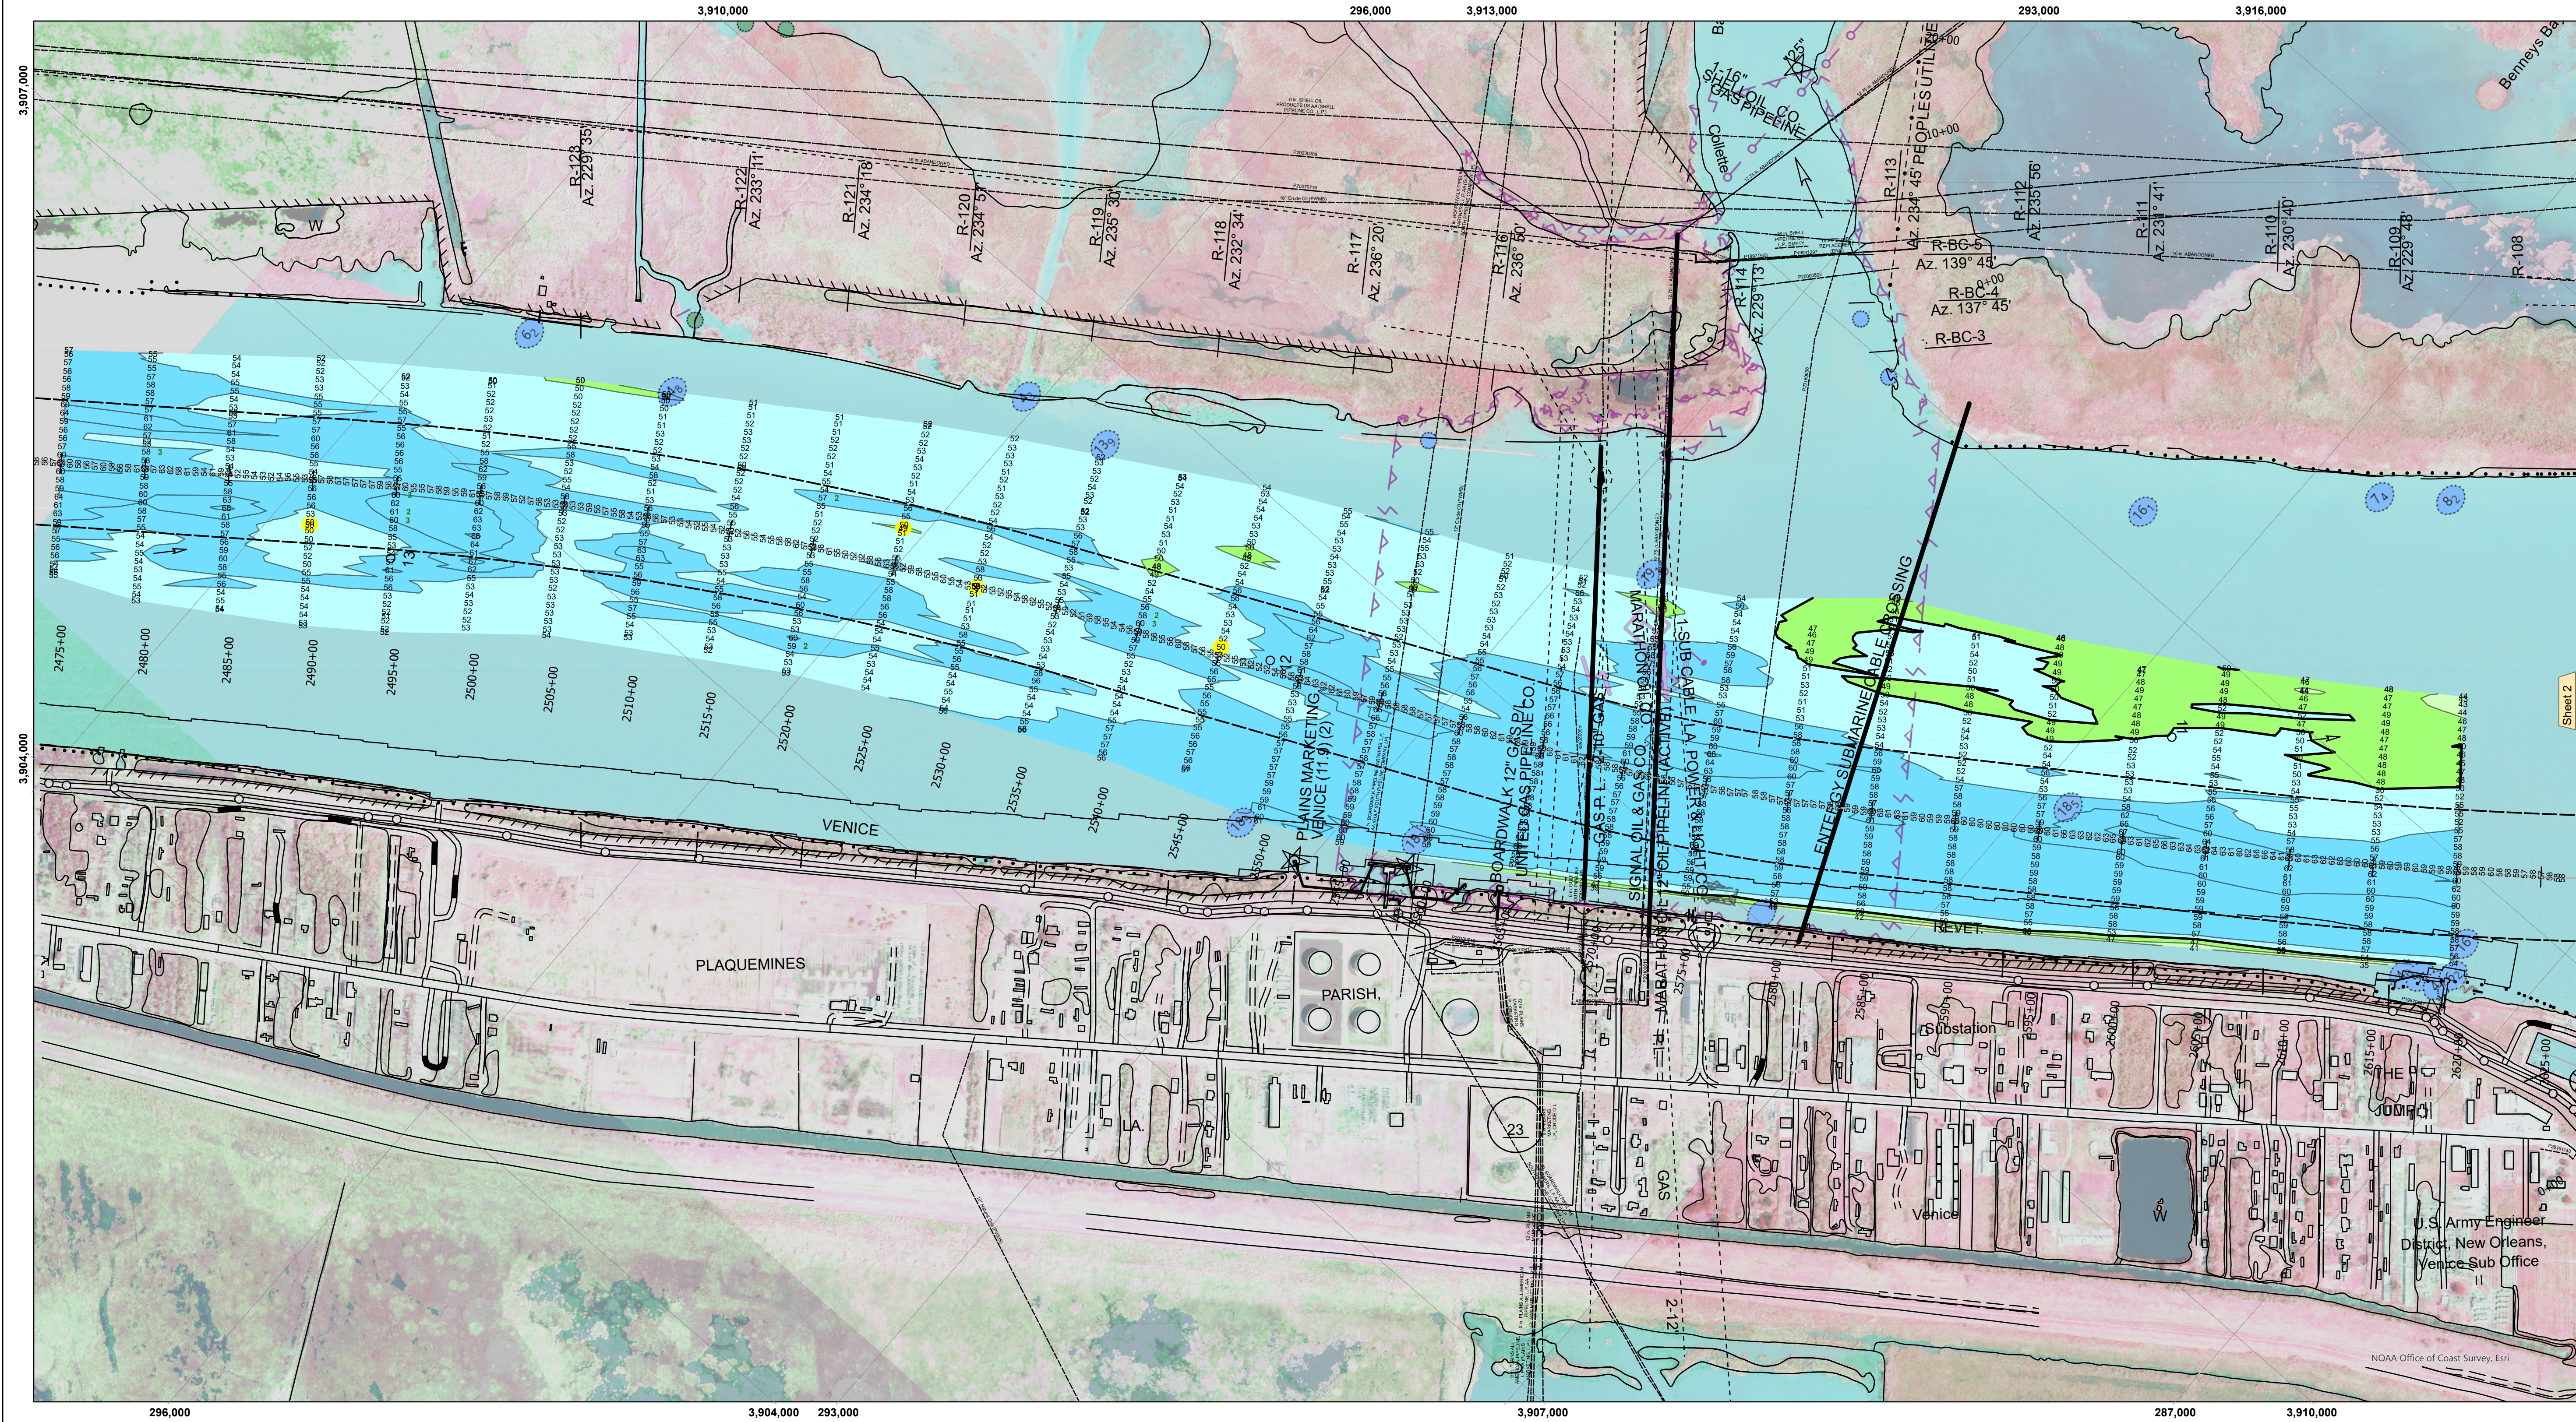

Gage Reading:
Sea Conditions:
Vessel Name:
Survey Type:
Sounding Frequency***:

2.4 MLLW @ VENICE (01480) @ 0825
CHOPPY
TOBIN
CONDITION, SB
LOW

Feet
0 500 1,000 1,500 2,000 2,500

NOTES:
Horizontal Coordinate System:
North American Datum of 1983 (NAD83), projected to the State Plane
Coordinate System (SPCS), Louisiana South Zone. Distance units in U.S. Survey Feet.
Vertical Datum:
Soundings are shown in feet and indicate depths below Mean Lower Low Water (MLLW, 12-16).
Datum Relationships for gage 01480 as of March 2020:
0.0' NAVD83, 2009.55 = -0.53' MLLW = 2.97' MLG
Distances on the Mississippi River, above and below Head of Passes are shown
at 1 mile intervals.
The location of navigation aids are base on and provided by the U.S. Coast Guard.
2024 Aerial Photography data source: Optimal GEO (1998 DOQQ in green)
Reference is N.O.A.A. Navigation Chart No. 11361.
** Shoalest Sounding per Quarter per Reach.
*** High frequency (200 kHz) survey data represents the first signal return at a sounding
location and will include suspended solids, known as "fluff", if present. Low frequency (24 kHz)
survey data normally penetrates through this "fluff" layer to depict elevations of consolidated bottom
material. Low frequency accuracies may vary depending on channel conditions and fathometer
settings.

U.S. ARMY CORPS OF ENGINEERS NEW ORLEANS DISTRICT			
Submitted:	Surveyed By: JTB & ROC	Plotted By: TSS	Checked By: MSK
Recommended:	Chief, Survey Section		Chief, Waterways Maintenance Section
Approved:			

MISSISSIPPI RIVER - B.R. TO GULF
SOUTHWEST PASS - SHEET 1
SW_01_SWPX_20250430_CS
30 April 2025

Sheet
Reference
Number
1 of 13

Revision Number:
5.23.12.5.23.12.3

**US Army Corps
of Engineers
District: CEMVN**

DISCLAIMER
Access Restrictions: The United States Government furnishes
these data and the recipient accepts and uses them with the express
understanding that they are not to be used for any purpose other than
that for which they were prepared, and that the user is responsible for the
reliability, usability or suitability for any particular purpose of the
information furnished. The user is responsible for the results of any
application of the data for other than its intended purpose.
Data Contents: Hydrographic survey data is subject to change
without notice. The data is not to be used for any purpose other than
that for which it was prepared. The U.S. Army Corps of Engineers
activity and natural availing and routing processes. The U.S. Army
Corps of Engineers does not warrant the accuracy of the data in the
hydrographic conditions which develop after the date of
publication. This data is intended for U.S. Army Corps of Engineers
internal use. Prudent mariners should not rely solely upon it.