

Accession: The United States Government furnishes these data and the recipient accepts and uses them with the express understanding that the data are not to be used for any purpose other than that for which they were originally collected, and that the data are not to be used for any purpose other than that for which they were originally collected.

Accuracy: The data are accurate to the nearest foot.

Vertical Datum: Mean Low Gulf Datum (MLG).

Horizontal Datum: North American Datum of 1983 (NAD83).


Scale: As shown.

Projection: State Plane Coordinate System (SPCS), Louisiana South Zone.

Units: Feet.

Disclaimer: The information depicted on this map represents the results of a survey conducted by the United States Army Corps of Engineers. The Corps of Engineers does not warrant the accuracy of the information depicted on this map. The recipient may not transfer these data to others without the written consent of the Corps of Engineers. The Corps of Engineers is not responsible for any errors or omissions in this map. The recipient is responsible for the accuracy of the information depicted on this map.

U.S. ARMY CORPS OF ENGINEERS NEW ORLEANS DISTRICT	
Submitted:	Surveyed By: RYLAND/SOUK
Recommended: Chief, Survey Section	Plotted By: JH
Approved: Chief, Waterways Maintenance Section	Checked By: JH

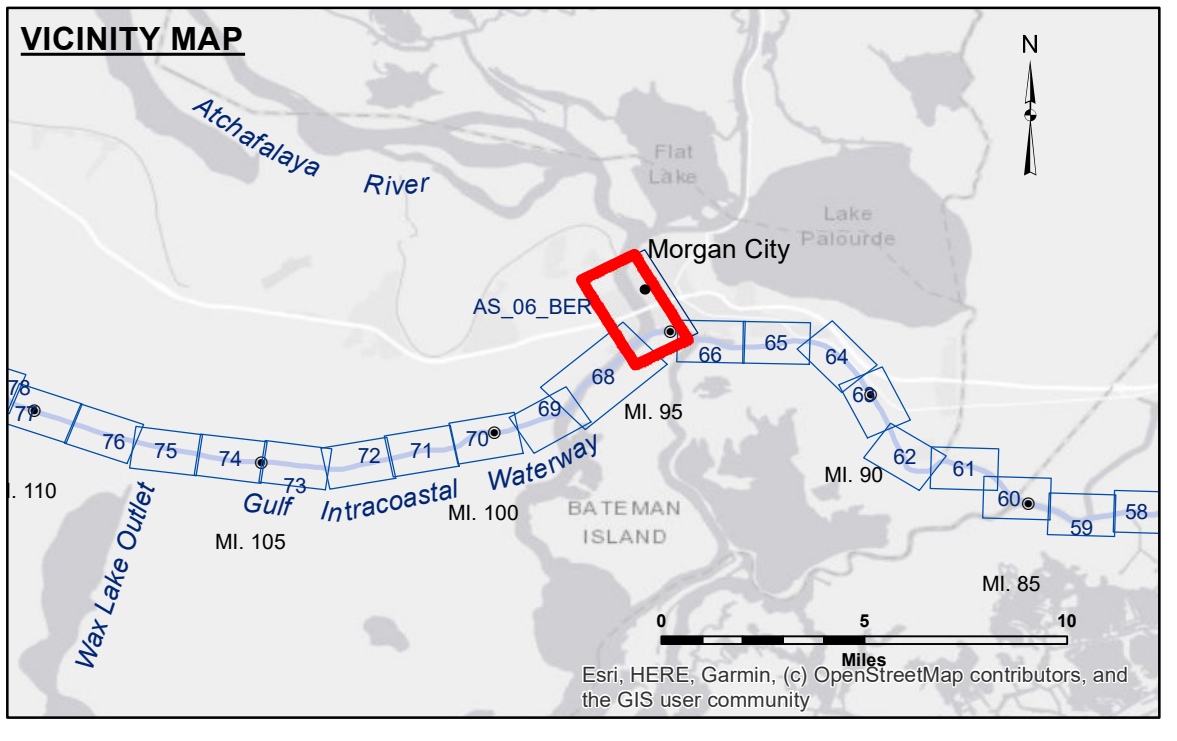

LEGEND

--- Federal Navigation Channel	○ Cable Area	□ Borrow Area	□ -6' and above
— Federal Navigation Center Line	■ Placement Area	● Shoalest Sounding**	■ -6 to -8
— As-built Pipeline/Cable	□ Anchorage Area	★ Beacon, General	■ -8 to -10
..... Unconfirmed Pipeline/Cable	⊗ Obstruction Point	◆ Red Navigation Buoy	■ -10 to -12
— Project Depth Contour	⚓ Wrecks-Submerged	◆ Green Navigation Buoy	■ -12' to -15'
			■ -15' to -18'
			■ -18' to -20'
			■ -20' and below

Notes:

Coordinate System: North American Datum of 1983 (NAD83), projected to the State Plane Coordinate System (SPCS), Louisiana South Zone. Distance units in U.S. Survey Feet.

Vertical Datum: Mean Low Gulf Datum (MLG).

Sounding Frequency***: HIGH

MC: 5.60 MLG

Sea Conditions: CALM

Vessel Name: M/V OB 189

Survey Type: CONDITION

Gage Reading: MC: 5.60 MLG

Scale: 0 to 2,000 Feet

NOTES: Coordinate System: North American Datum of 1983 (NAD83), projected to the State Plane Coordinate System (SPCS), Louisiana South Zone. Distance units in U.S. Survey Feet.

Vertical Datum: Mean Low Gulf Datum (MLG).

Sounding Frequency***: HIGH

MC: 5.60 MLG

Sea Conditions: CALM

Vessel Name: M/V OB 189

Survey Type: CONDITION

Gage Reading: MC: 5.60 MLG

Scale: 0 to 2,000 Feet

**ATCHAFALAYA RIVER
BERWICK HARBOR
AS_06_BER_20220529_AD
29 May 2022**

**Sheet
Reference
Number
6 of 66**