
CORPS OF ENGINEERS U.S. ARMY

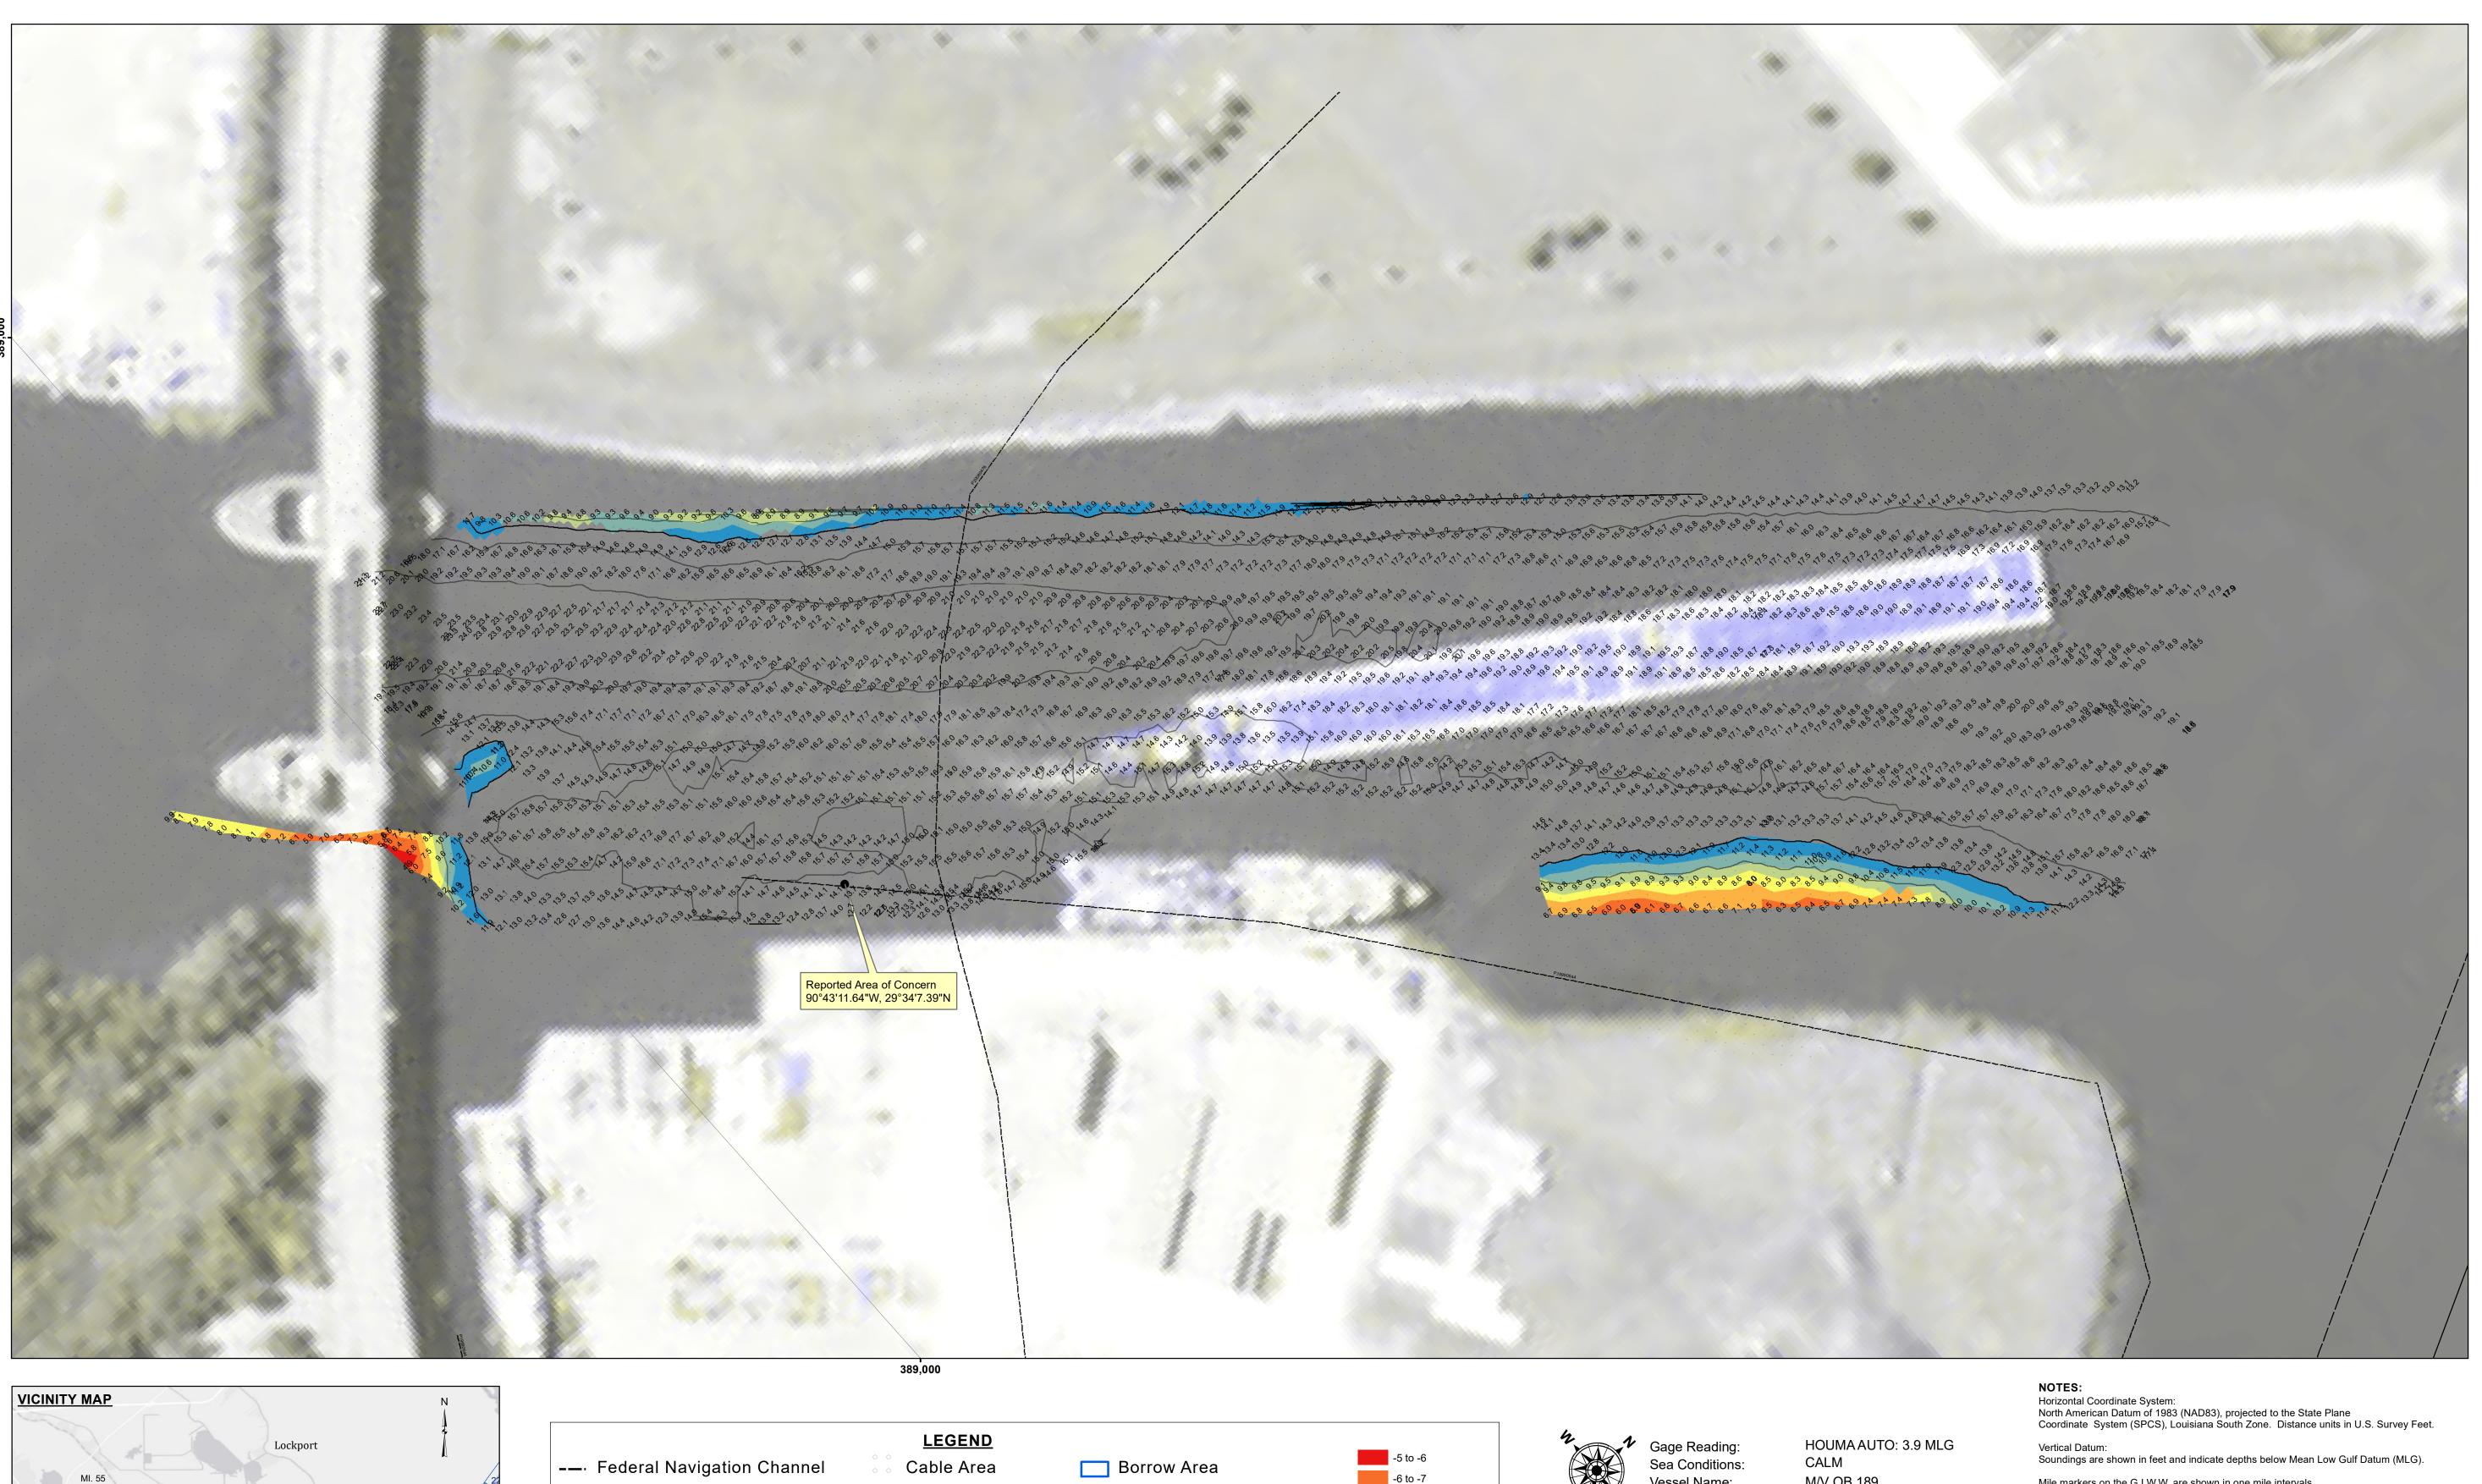

Shoalest Sounding**

Red Navigation Buoy

Green Navigation Buoy

Beacon, General

-7 to -8

-9 to -10

-10 to -11

-11 to -12

-12 and below

-8 to -9

— Federal Navigation Center Line Placement Area

As-built Pipeline/Cable

— Project Depth Contour

Esri, HERE, Garmin, (c) OpenStreetMap contributors, and

--- Unconfirmed Pipeline/Cable

Anchorage Area

∅ Obstruction Point

Wrecks-Submerged

Vessel Name:

Survey Type:

100

Sounding Frequency***: HIGH

Feet


M/V OB 189

CONDITION

200

HAH **US Army Corps** of Engineers

District: CEMVN

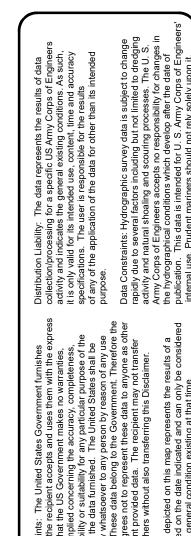

	Surveyed By: RYLAND/SOUKI	Plotted By: AO	Checked By: AO
U.S. ARMY COPRPS OF ENGINEERS NEW ORLEANS DISTRICT	Submitted:	Recommended: Chief, Survey Section	Approved: Chief, Waterways Maintenance Section

GULF INTRACOASTAL WATERWAY _20191017_ 17

Sheet Reference Number

42 **of** 191

Revison Number: 4.0-201907022

** Shoalest Sounding per Quarter per Reach. *** High frequency (200 kHz) survey data represents the first signal return at a sounding location and will include suspended solids, known as "fluff", if present. Low frequency (20 kHz) survey data normally penetrates through this "fluff" layer to depict elevations of consoldiated bottom material. Low frequency accuracies may vary depending on channel conditions and fathometer

Mile markers on the G.I.W.W. are shown in one mile intervals.

Reference is N.O.A.A. Navigation Chart No. 11355.

shown in green from USGS.

2010 Aerial Photography data source: NAIP. 1998 DOQQ imagery

The location of navigation aids are base on and provided by the U.S. Coast Guard.