
U.S. ARMY CORPS OF ENGINEERS

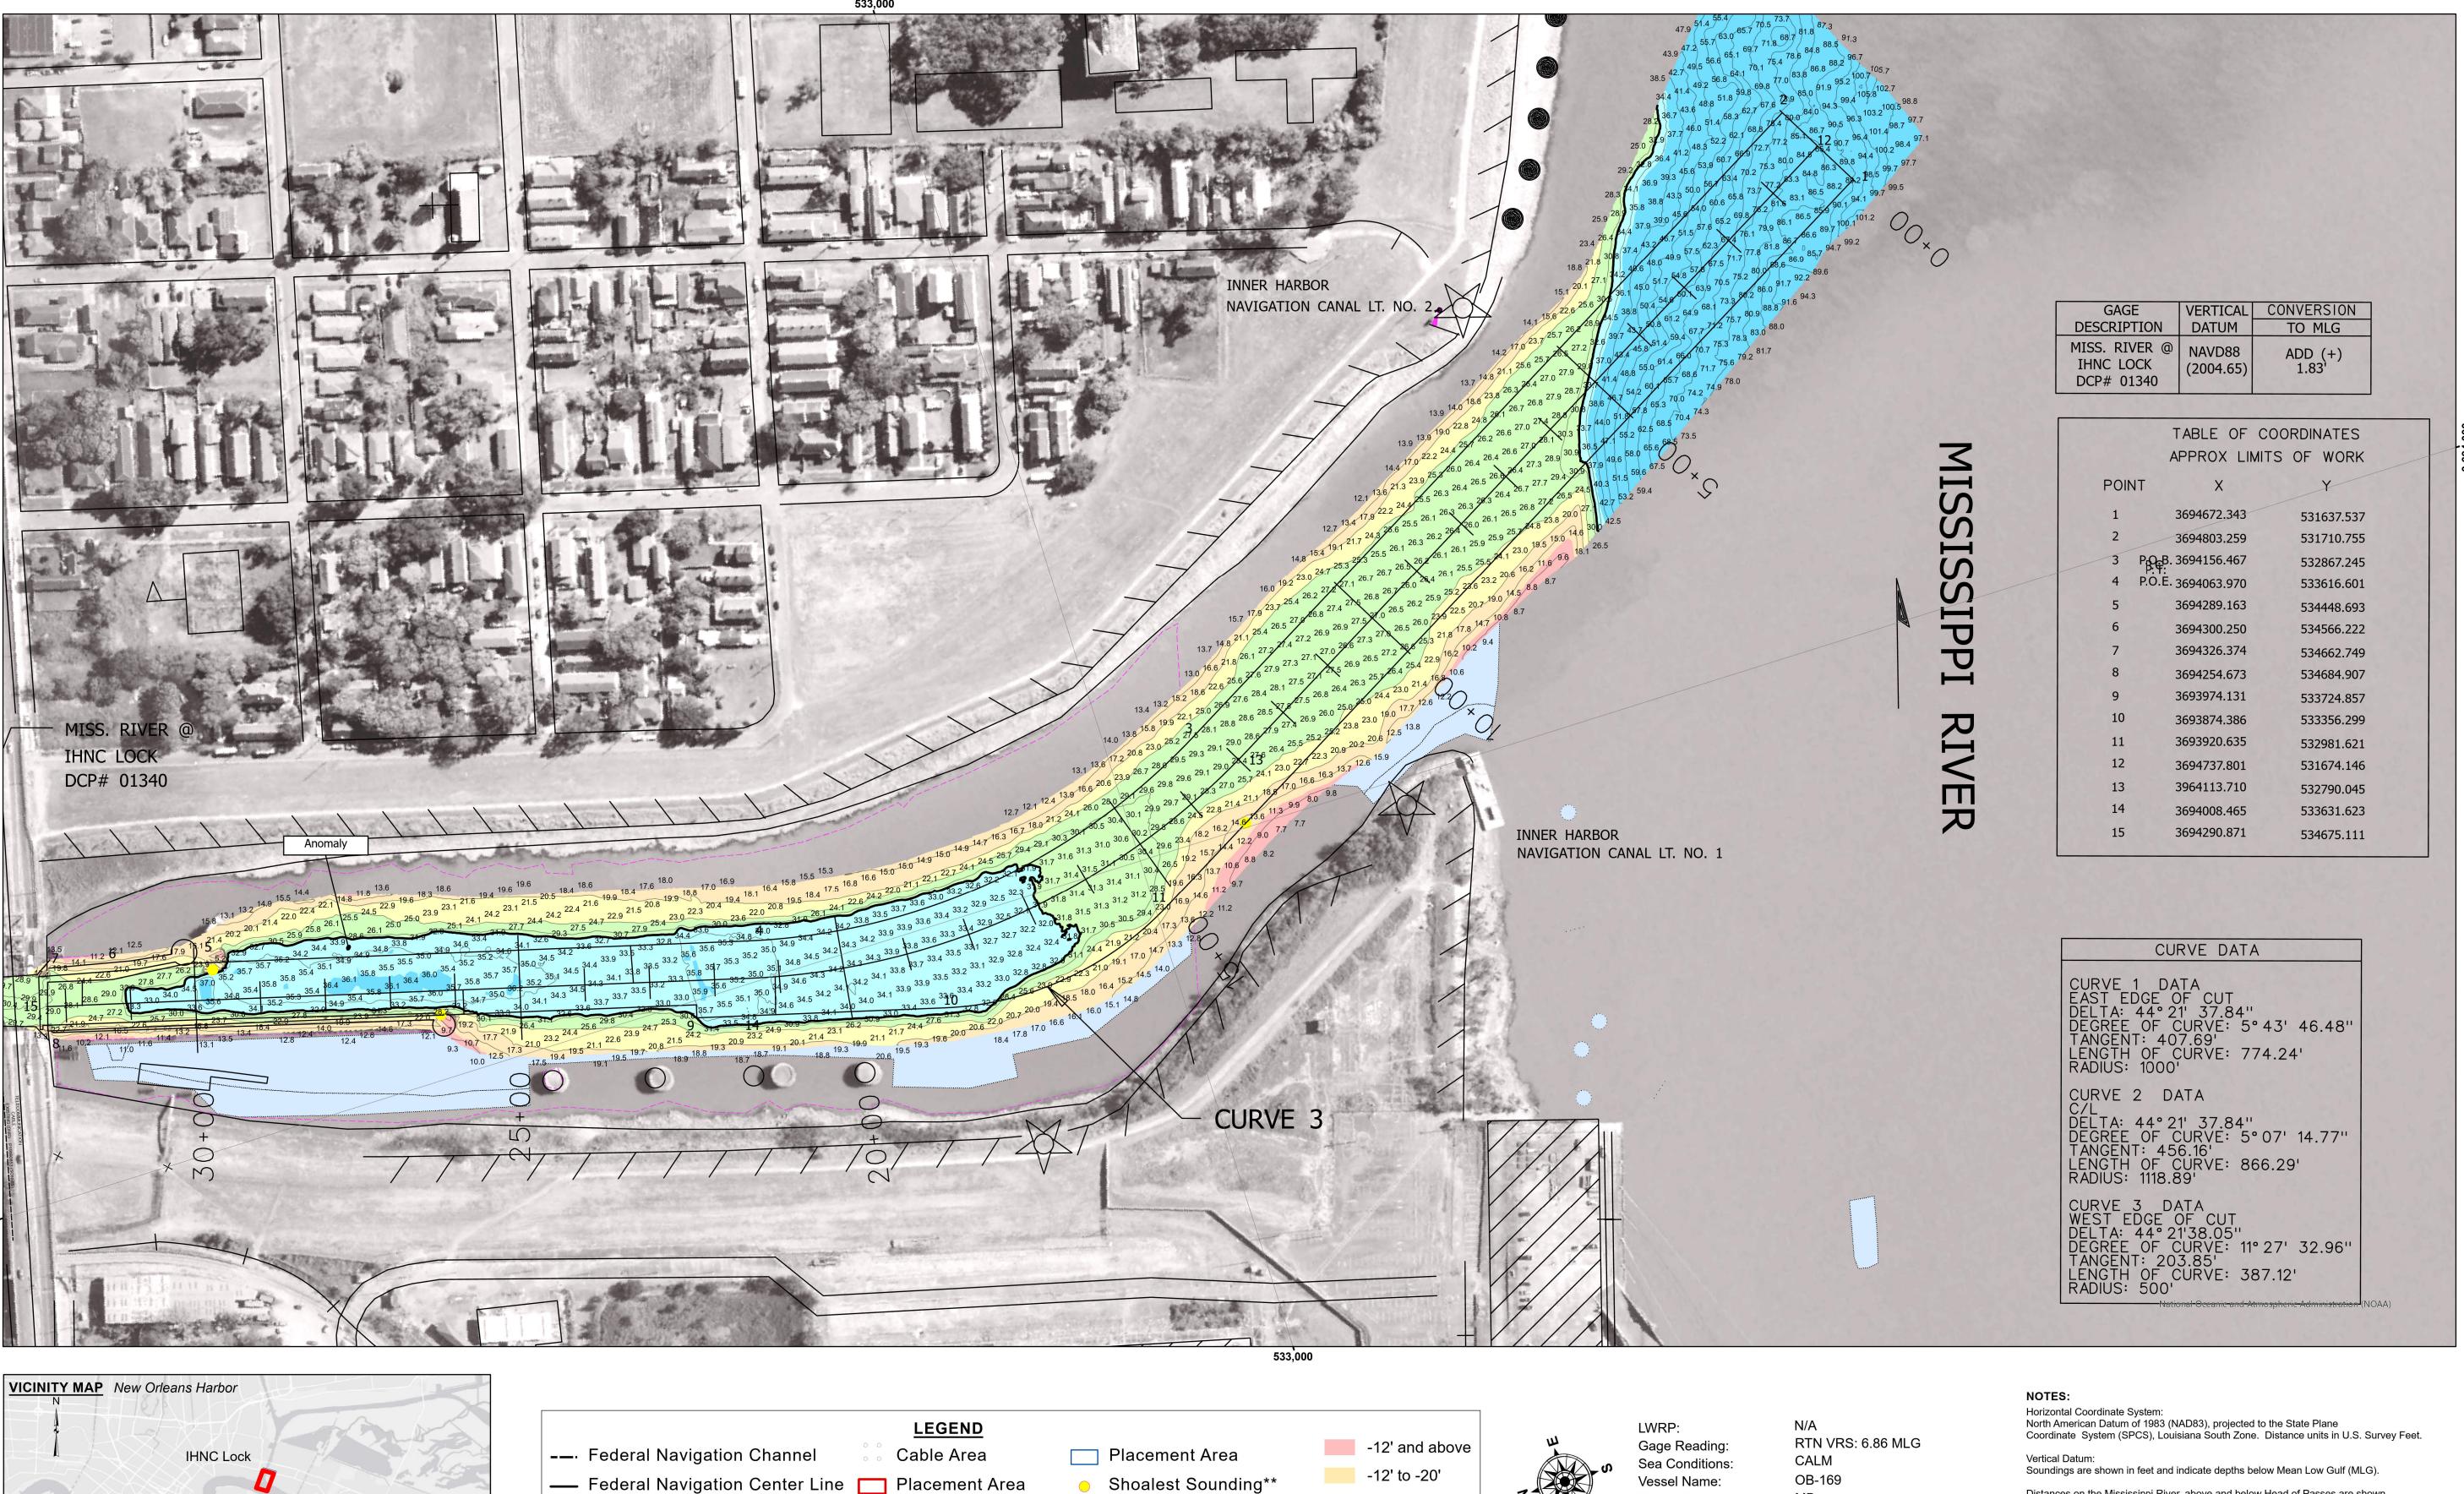

As-built Pipeline/Cable

— Project Depth Contour

Algiers Lock

the GIS user community

Harvey Lock

..... Unconfirmed Pipeline/Cable

[\_\_] Anchorage Area

∅ Obstruction Point

Wrecks-Submerged

Beacon, General

Red Navigation Buoy

Green Navigation Buoy

-20' to -25'

-32' to -36'

-36' and below

-25' to -32'

**US Army Corps** of Engineers **District: CEMVN** 

LOCK FOREBAY

| \_20250722\_CS\_3 ISSISSIPPI RIVER DEEP-DRAFT July 2025

Sheet Reference Number of 4

Distances on the Mississippi River, above and below Head of Passes are shown

Reference is N.O.A.A. Navigation Chart No. 11370.

\*\* Shoalest Sounding per Quarter per Reach.

The location of navigation aids are base on and provided by the U.S. Coast Guard and USACE crew.

2021 Aerial Photography data source: NAIP, USDA-FSA-APFO Aerial Photography Field Office.

\*\*\* High frequency (200 kHz) survey data represents the first signal return at a sounding location and will include suspended solids, known as "fluff", if present. Low frequency (20 kHz) survey data normally penetrates through this "fluff" layer to depict elevations of consoldiated bottom material. Low frequency accuracies may vary depending on channel conditions and fathometer

at 1 mile intervals.

MB

400

600

Survey Type:

Sounding Frequency\*\*\*: 400KHZ

Revison Number: 5.25.04.03-5.25.04.03