
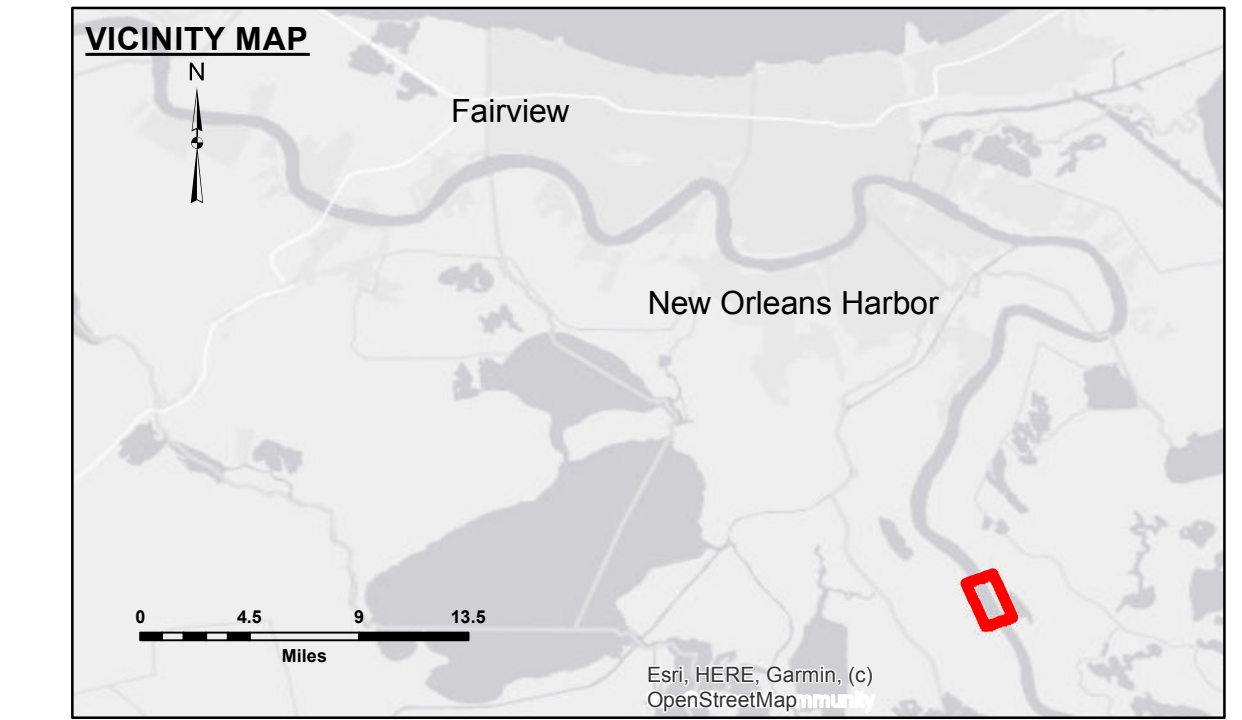


Legend

- 0 to -35
- 35 to -40
- 40 to -45
- 45 to -50
- 50 to -55
- 55 to -60
- 60 to -65
- 65 to -70
- 70 to -75
- 75 to -80
- 80 to -85
- 85 and below

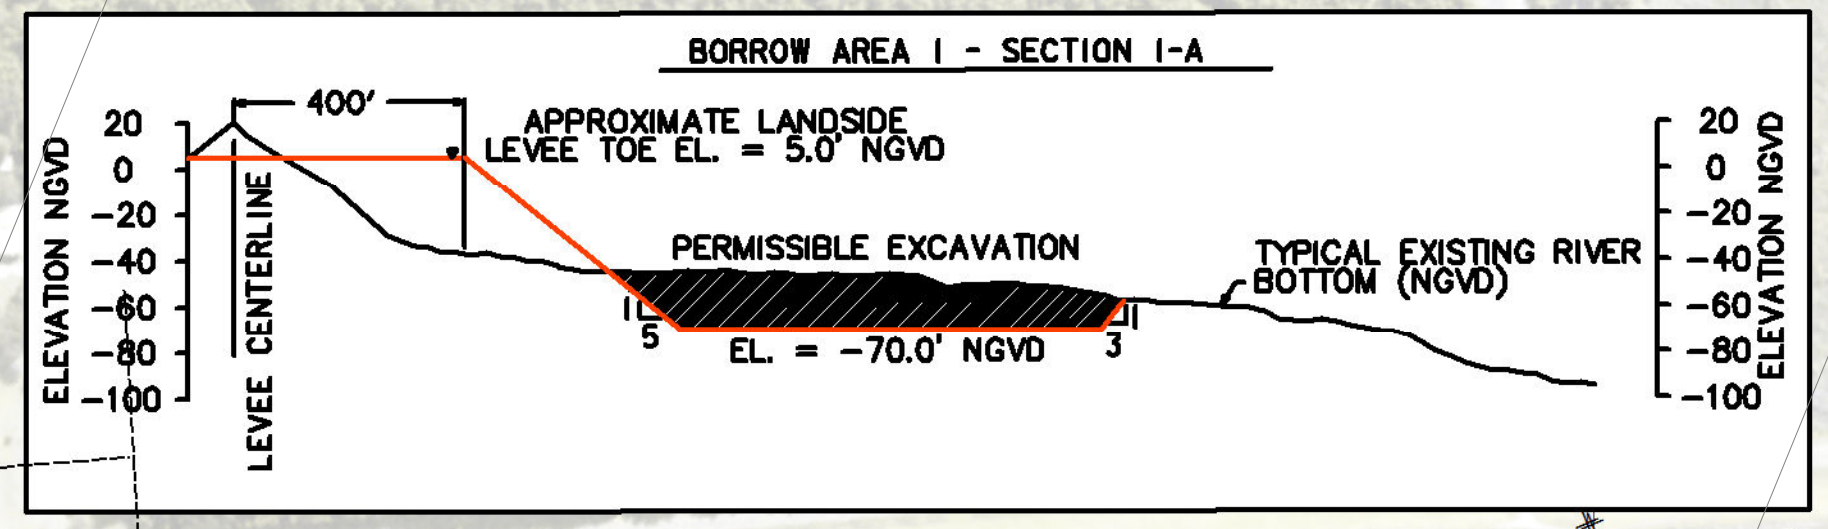

LEGEND

- Federal Navigation Channel
- Federal Navigation Center Line
- As-built Pipeline/Cable
- Unconfirmed Pipeline/Cable
- Project Depth Contour
- Cable Area
- Placement Area
- Anchorage Area
- Obstruction Point
- Wrecks-Submerged
- Shoaling Area
- Shoalest Sounding**
- Beacon, General
- Red Navigation Buoy
- Green Navigation Buoy

LWRP: 0.4
 Gage Reading: ALLIANCE: 1.1 NAVD
 Sea Conditions: CALM
 Vessel Name: OB-167
 Survey Type: PROGRESS
 Sounding Frequency***: 400KHZ

0 500 1,000 1,500
 Feet

NOTES:

Horizontal Coordinate System:
 North American Datum of 1983 (NAD83), projected to the State Plane Coordinate System (SPCS), Louisiana South Zone. Distance units in U.S. Survey Feet.

Vertical Datum:
 Soundings are shown in feet and indicate depths below Low Water Reference Plane 2007 (LWRP07).

Datum Relationships for Alliance (0.0' Gage Datum = 0.0' NAVD88 (2009.55) = 0.71' NGVD29 = -0.4' LWRP07)

Distances on the Mississippi River, above and below Head of Passes are shown at 1 mile intervals.

The location of navigation aids are base on and provided by the U.S. Coast Guard and USACE crew.

2015 Aerial Photography data source: NAIP, USDA-FSA-APFO Aerial Photography Field Office.

Reference is N.O.A. Navigation Chart No. 11370.

** Shoalest Sounding per Quarter per Reach.

*** High frequency (200 kHz) survey data represents the first signal return at a sounding location and will include suspended solids, known as "fluff", if present. Low frequency (20 kHz) survey data normally penetrates through this "fluff" layer to depict elevations of consolidated bottom material. Low frequency accuracies may vary depending on channel conditions and fathometer settings.



DISCLAIMER:

The information depicted on this map represents the results of a survey conducted for the purpose of engineering design. The data is not intended to be used for any purpose other than that for which it was collected. The user is responsible for the accuracy, completeness, and reliability of the data used in the design. The user is not to be held liable for any damage or injury resulting from the use of this data for any purpose other than that for which it was collected.

U.S. ARMY CORPS OF ENGINEERS
 NEW ORLEANS DISTRICT

Submitted:	Reviewed:	Checked:
SPPS	AO	AO
U.S. ARMY CORPS OF ENGINEERS DISTRICT: CEMVN PROJECT: MISSISSIPPI RIVER - B.R. TO GULF SHEET: SALT WATER BARRIER, BORROW 1 DATE: 13 October 2022		

**MISSISSIPPI RIVER - B.R. TO GULF
 SALT WATER BARRIER, BORROW 1
 MD_72_SB3_20221013_PR_5X5
 PROGRESS
 13 October 2022**

**Sheet Reference Number
 72 of 97**