


- LEGEND**
- Federal Navigation Channel
 - Federal Navigation Center Line
 - As-built Pipeline/Cable
 - Unconfirmed Pipeline/Cable
 - Project Depth Contour
 - Cable Area
 - Placement Area
 - Anchorage Area
 - ★ Beacon, General
 - ◆ Obstruction Point
 - ✖ Wrecks-Submerged
 - Borrow Area
 - Shoalest Sounding**
 - ⊗ Anchorage Point
 - ◆ Red Navigation Buoy
 - ◆ Green Navigation Buoy

- LWRP: 2.8
Gage Reading: BR:25.0D:16.1 USED:23.5 NGVD
Sea Conditions: CALM
Vessel Name: BURWOOD
Survey Type: CONDITION
Sounding Frequency***: HIGH

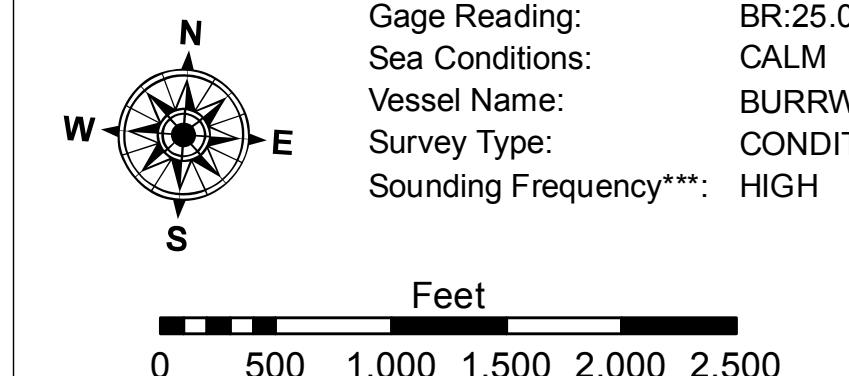

NOTES:
Horizontal Coordinate System:
North American Datum of 1983 (NAD83), projected to the State Plane
Coordinate System (SPCS), Louisiana South Zone. Distance units in U.S. Survey Feet.

Vertical Datum:
Soundings are shown in feet and indicate depths below Low Water Reference Plane 2007 (NGVD).
Distances on the Mississippi River, above and below Head of Passes are shown
at 1 mile intervals.

The location of navigation aids are base on and provided by the U.S. Coast Guard and USACE crew.
2010 Aerial Photography data source: NAIP, USDA-FSA-APFO Aerial Photography Field Office.
Reference is N.O.A.A. Navigation Chart No. 11370.

** Shoalest Sounding per Quarter per Reach.
*** High frequency (200 kHz) survey data represents the first signal return at a sounding
location and will include suspended solids, known as "fluff", if present. Low frequency (20 kHz)
survey data normally penetrates through this "fluff" layer to depict elevations of consolidated bottom
material. Low frequency accuracies may vary depending on channel conditions and fathometer
settings.

Sheet
Reference
Number
6 of 97

Revision Number:
312-20160811

**MISSISSIPPI RIVER - B.R. TO GULF
SARDINE POINT RECON
MR_06_SD_P_20170711_CS**
11 July 2017

US Army Corps of Engineers
District: CEMVN

Distribution Label: The data represents the results of data collection/processing for a specific US Army Corps of Engineers activity and indicates the general existing conditions. Such descriptions are not necessarily intended to be the results of any survey or measurement. The user is responsible for the results of any application of the data for other than its intended purpose.
Data Constraints: Hydrographic survey data is subject to change due to several factors including but not limited to dredging activities and natural shoaling and scouring processes. The U.S. Army Corps of Engineers does not warrant the data in the hydrographic conditions shown on this map. The data is intended for U.S. Army Corps of Engineers use only. The information depicted on this map represents the results of a survey conducted on the date indicated and can only be considered to represent the general condition existing at that time.

U.S. ARMY CORPS OF ENGINEERS NEW ORLEANS DISTRICT	
Surveyed By:	DS IA
Submitted:	
Protected By:	AO
Recommended:	One Survey Section
Approved:	One Waterways Maintenance Section
Checked By:	AO

**MISSISSIPPI RIVER - B.R. TO GULF
SARDINE POINT RECON
MR_06_SD_P_20170711_CS**
11 July 2017