
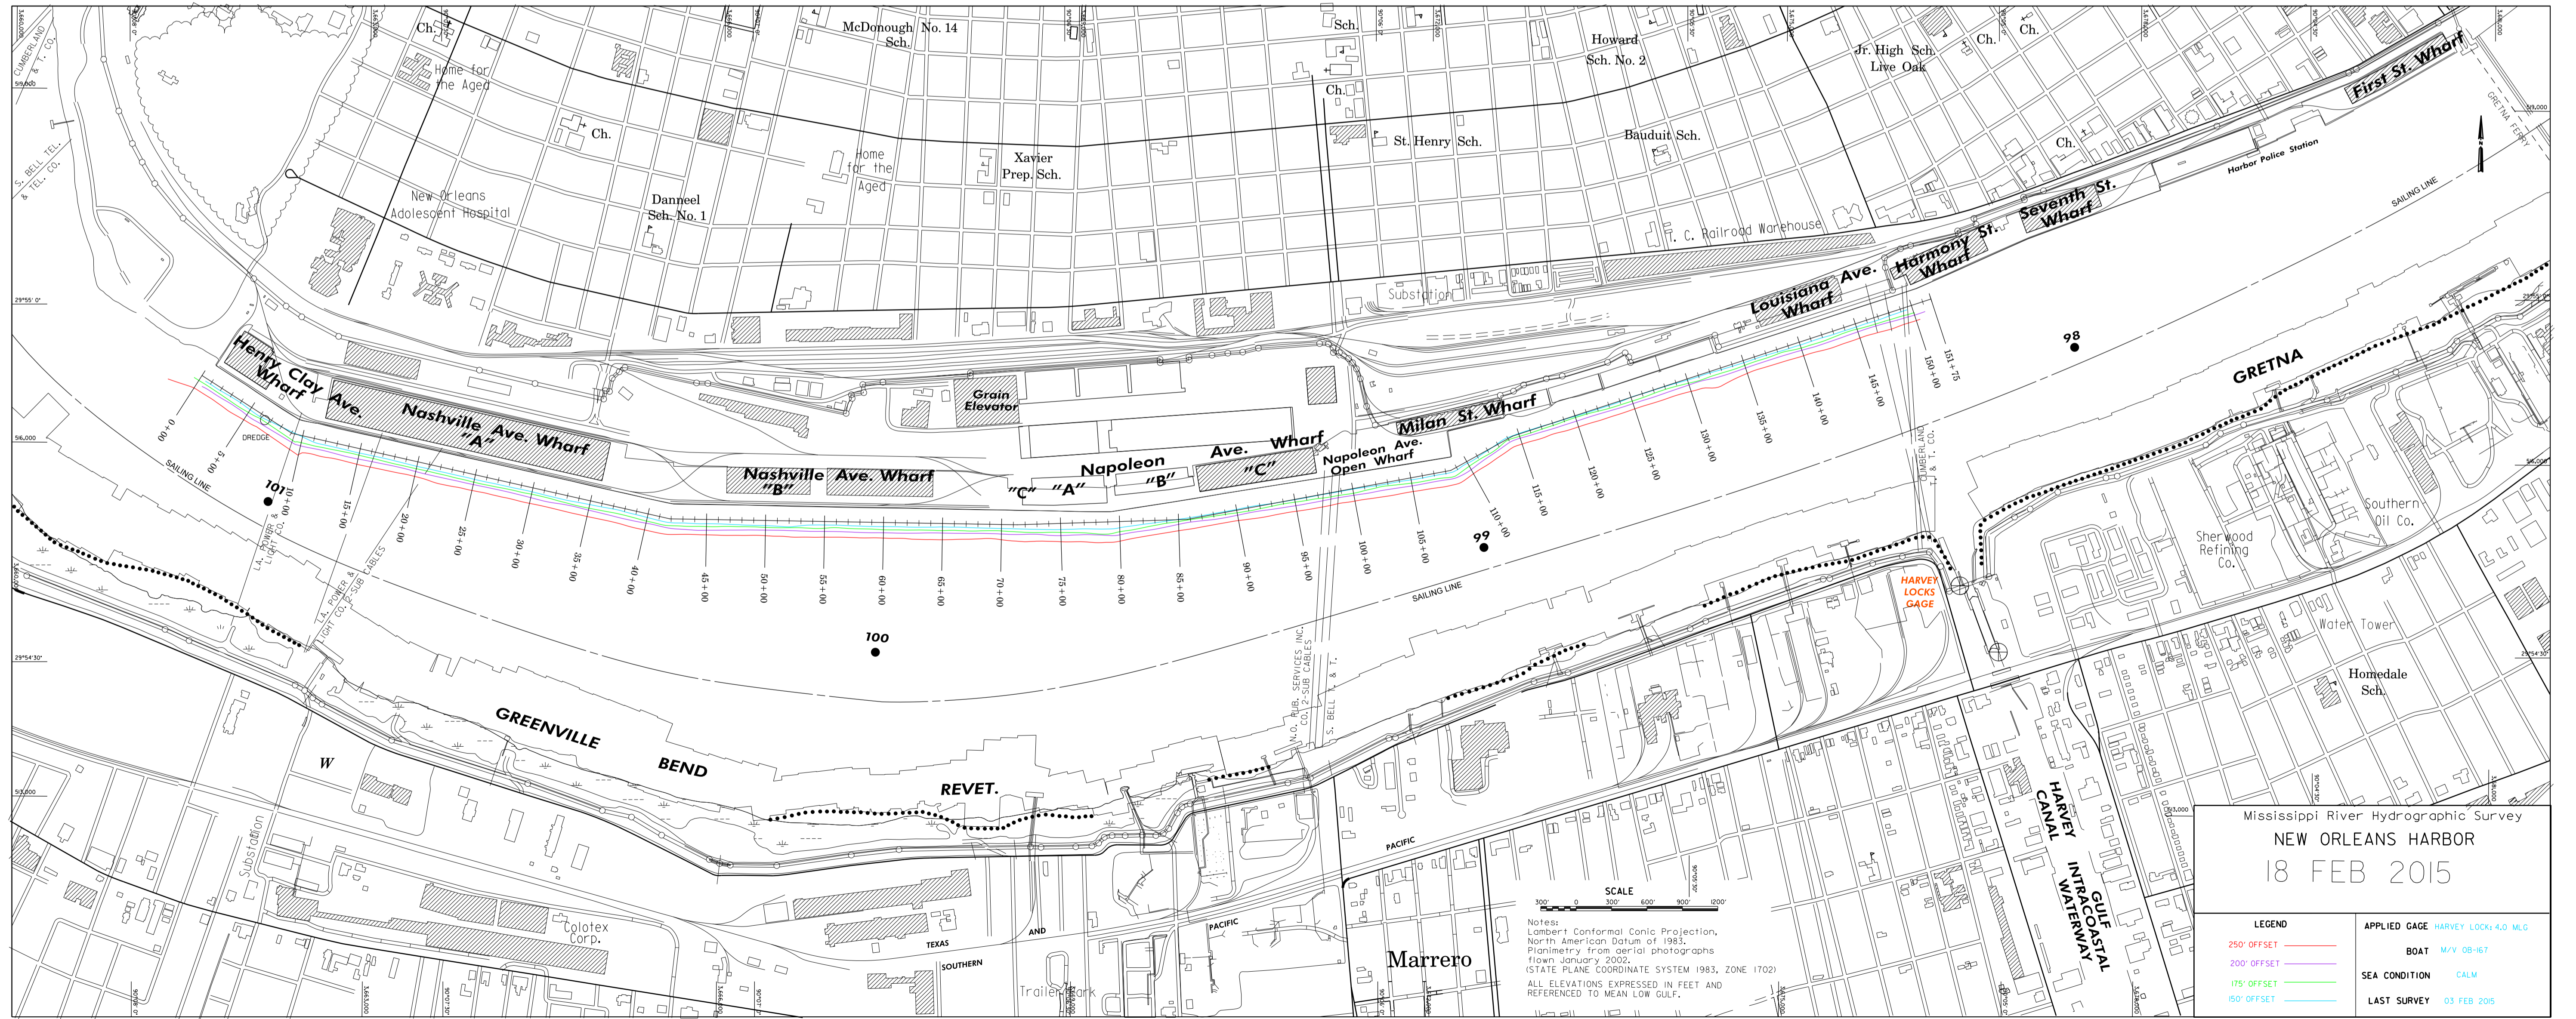


New Orleans Harbor 150', 175', 200' & 250' Offsets

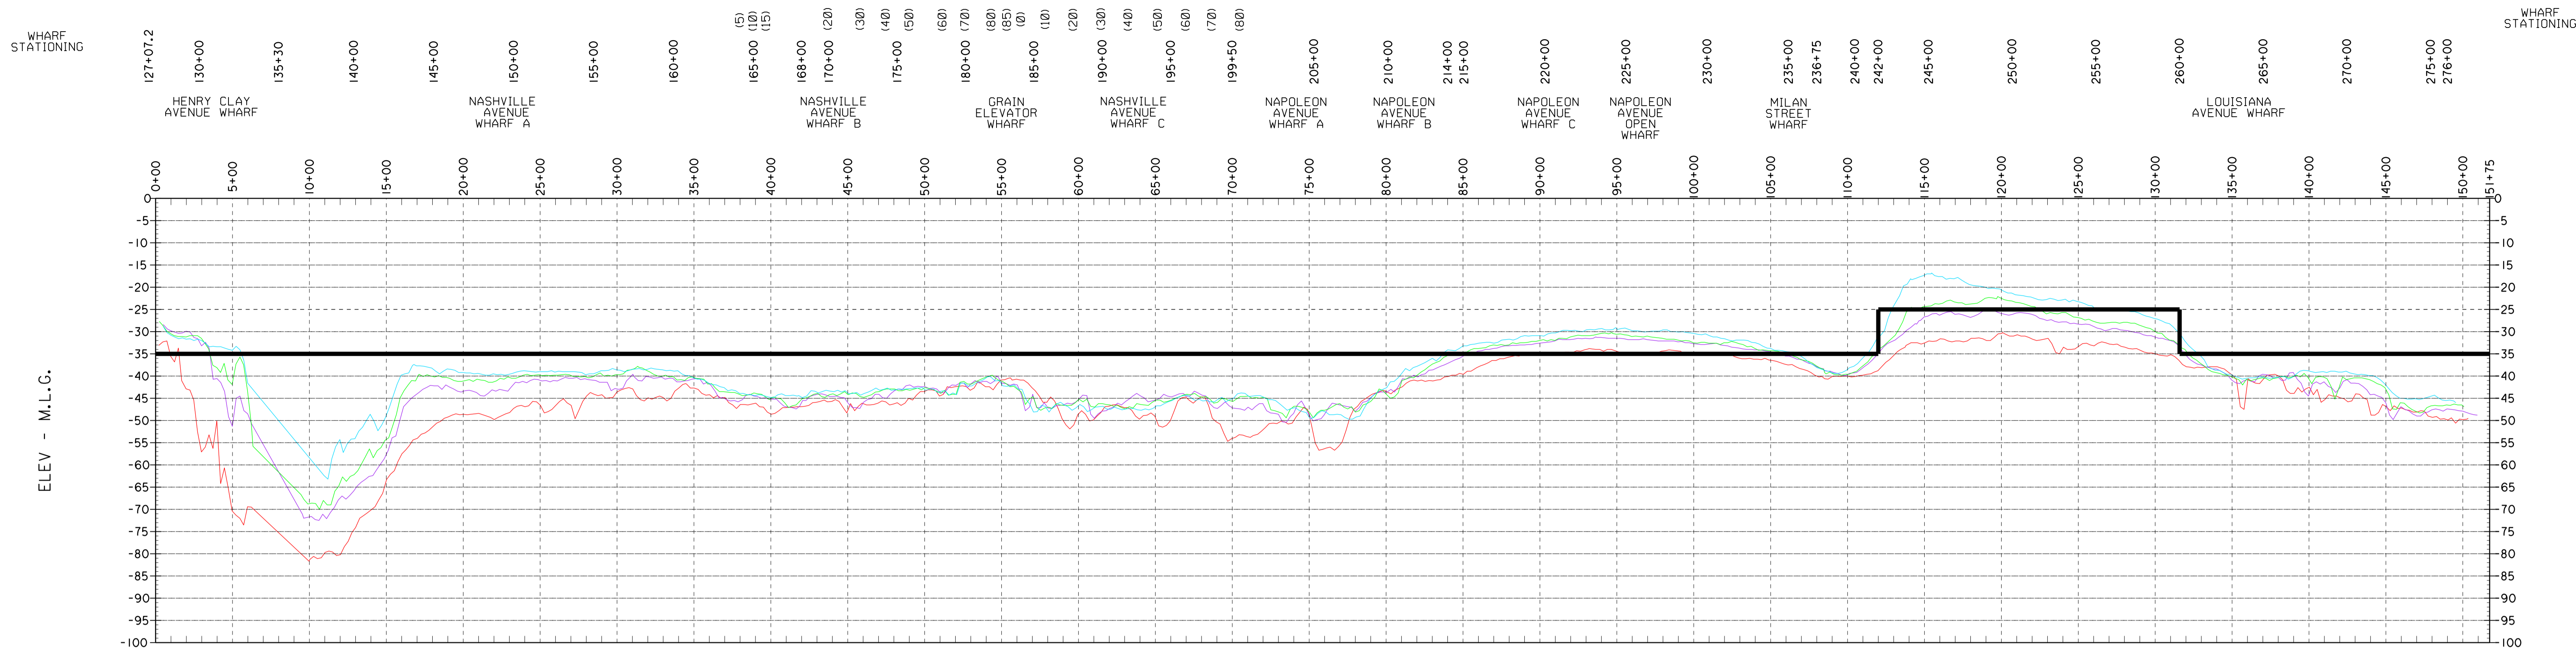

Mississippi River Hydrographic Survey
NEW ORLEANS HARBOR
 18 FEB 2015

LEGEND		APPLIED GAGE HARVEY LOCKS 4.0 M.L.C.	
250' OFFSET	(Red line)	BOAT	M/V OB-67
200' OFFSET	(Green line)	SEA CONDITION	CALM
175' OFFSET	(Blue line)	LAST SURVEY	03 FEB 2005
150' OFFSET	(Purple line)		

SCALE 1" = 200'

Notes:
 Lambert Conformal Conic Projection,
 North American Datum of 1983,
 Spheroid: GRS 1980
 Datum: NAD 83
 Projection: Lambert Conformal Conic
 Zone: 17N
 State Plane Coordinate System 1983, Zone 17(2)
 ALL ELEVATIONS EXPRESSED IN FEET AND
 REFERENCED TO MEAN LOW GULF.