
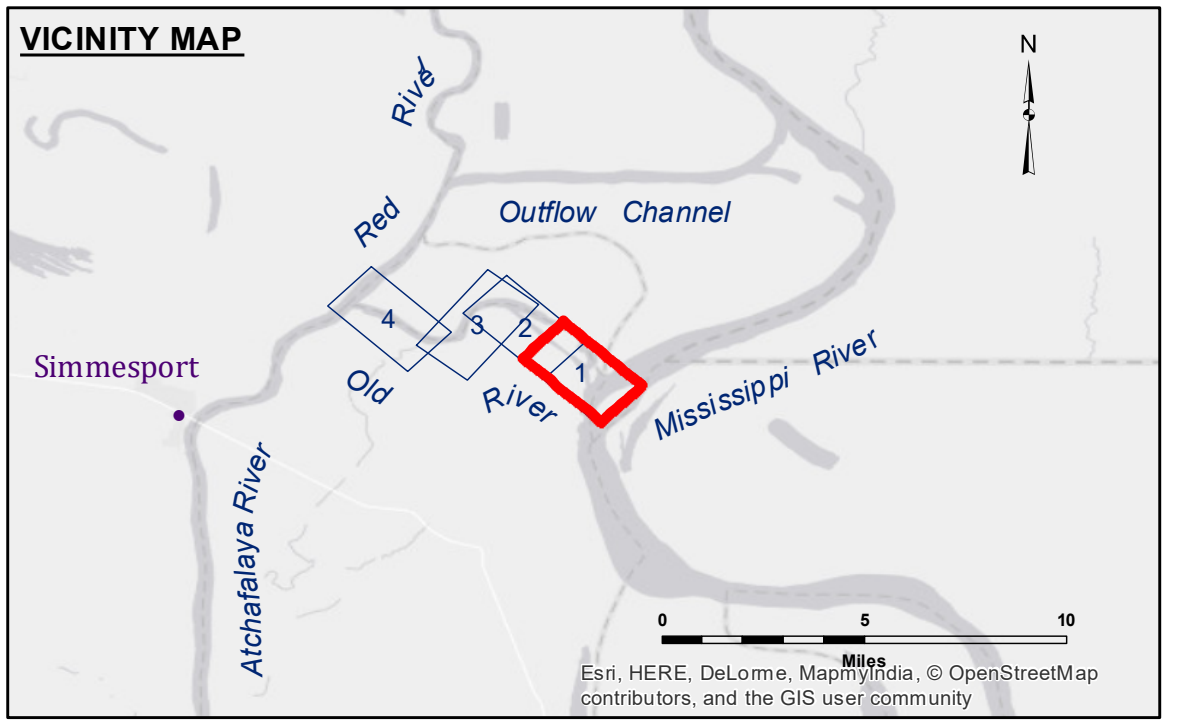


TABLE OF COORDINATES

POINT NO.	X	Y
1	3177319.136	905485.019
2	3177078.443	907480.021
3	3176613.880	908417.707
4	3175807.880	909200.672
5	3175359.699	909636.057

CURVE #1 DATA
 $\Delta = 38^\circ 58' 46.430''$
 $D = 3^\circ 39' 00''$
 $R = 1569.53$
 $T = 555.00$
 $L = 1066.87$
 $LC = 1046.46$

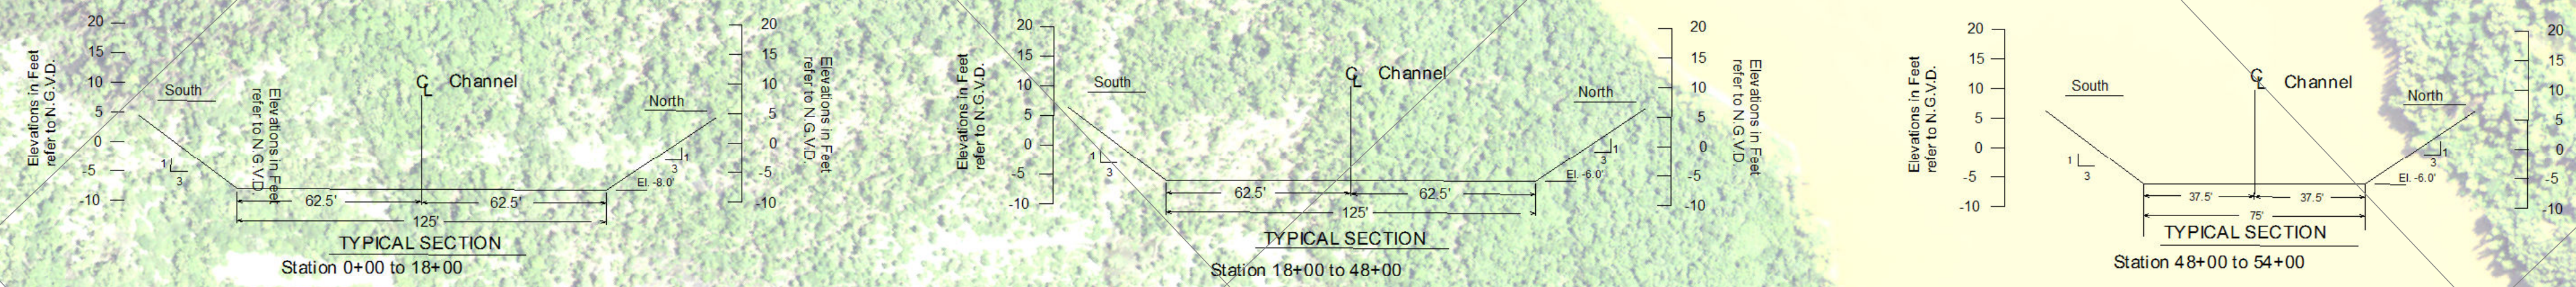

LEGEND

- Federal Navigation Channel
- Federal Navigation Center Line
- As-built Pipeline/Cable
- Unconfirmed Pipeline/Cable
- Project Depth Contour
- Cable Area
- Placement Area
- Anchorage Area
- ⊗ Obstruction Point
- ✶ Wrecks-Submerged
- Borrow Area
- Shoalest Sounding**
- ☆ Beacon, General
- ◆ Red Navigation Buoy
- ◆ Green Navigation Buoy
- -8' and above
- -8' to -10'
- -10' to -12'
- -12' and below

NOTES:
 Horizontal Coordinate System: North American Datum of 1983 (NAD83), projected to the State Plane Coordinate System (SPCS), Louisiana South Zone. Distance units in U.S. Survey Feet.
 Vertical Datum: Soundings are shown in feet and indicate depths below National Geodetic Vertical Datum of 1929 (NGVD29).
 The location of navigation aids are based on and provided by the U.S. Coast Guard. Positions of navigation aids shown may also have been surveyed in the field by USACE.
 2010 Aerial Photography data source: NAIP, 1998 DOQQ imagery shown in green from USGS.
 Reference is N.O.A.A. Navigation Chart No. 11354.
 ** Shoalest Sounding per Quarter per Reach.
 *** High frequency (200 kHz) survey data represents the first signal return at a sounding location and will include suspended solids, known as "fluff", if present. Low frequency (20 kHz) survey data normally penetrates through this "fluff" layer to depict elevations of consolidated bottom material. Low frequency accuracies may vary depending on channel conditions and fathometer settings.

ORL FB: 19.90 NGVD
 CALM
 OB-189
 Vessel Name:
 Survey Type: CONDITION
 Sounding Frequency***: HIGH

Scale: 0 to 1,500 Feet

US Army Corps of Engineers
 District: CEMVN

ACCESSORIES:
 The United States Government furnishes these data and the recipient accepts and uses them with the express understanding that the Government makes no warranty, either expressed or implied, concerning the accuracy, completeness, reliability, usability or suitability for any particular purpose of the data. The user shall be responsible for the results obtained from the application of the data for other than its intended purpose. Data Contaminants: Hydrographic survey data is subject to change rapidly due to several factors including but not limited to dredging, channel changes, and the presence of obstructions. The user shall be responsible for changes in the hydrographic conditions when developing after the date of the survey. The information depicted on this map represents the results of a survey conducted under the general conditions stated on this title. Considered to represent the general condition existing at that time.

Submitted:	Surveyed By: RYLAND/ADAMS
Recommended:	Plotted By: BD
Approved:	Checked By: AC

U.S. ARMY CORPS OF ENGINEERS
 NEW ORLEANS DISTRICT

OLD RIVER LOCK VICINITY
OLD RIVER LOCK FOREBAY
OR_01_LFB_20171220_CS
20 December 2017

Sheet Reference Number
1 of 4

Revision Number:
 3.13-20160811