


TABLE OF COORDINATES

POINT NO.	X	Y
1	3160729.903	911765.022
2	3160120.449	911697.669
3	3159401.048	911823.878
4	3158068.092	912453.314
5	3157265.795	912997.188
6	3155331.319	914800.430
7	3154295.135	915466.061
8	3152502.488	916195.316
9	3151447.847	916490.361
10	3151271.506	916518.500

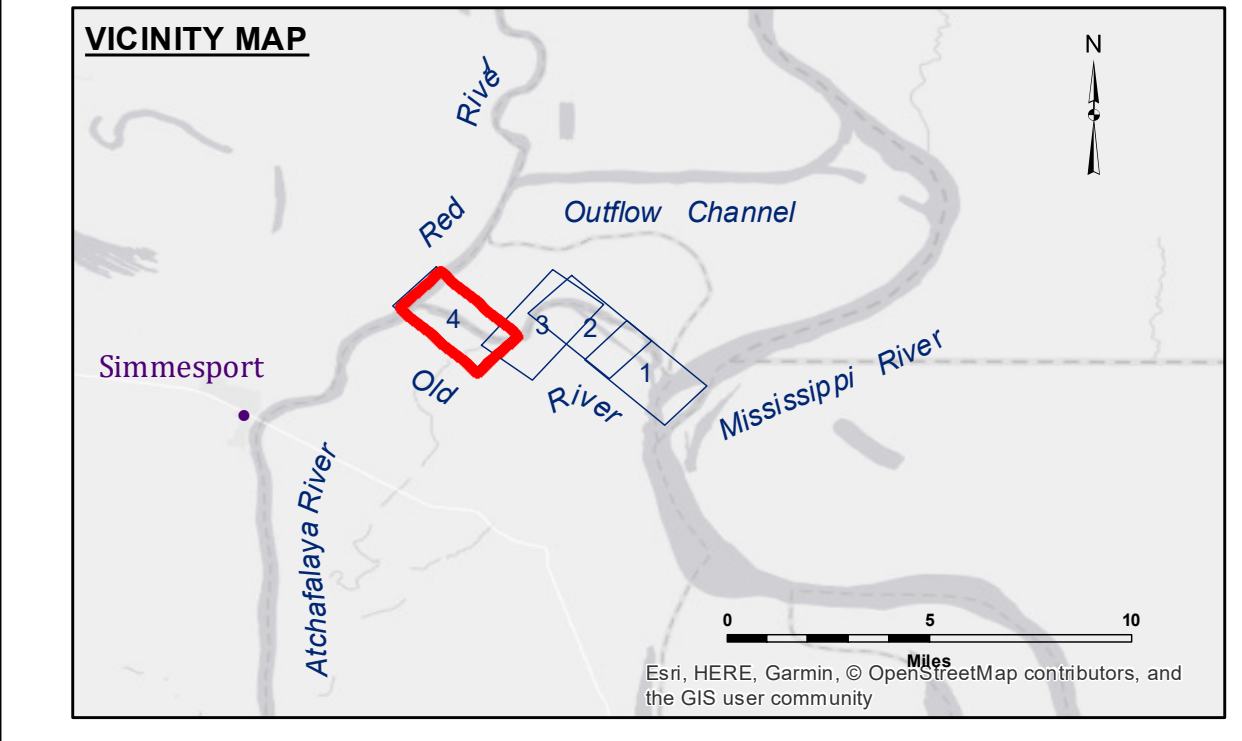

LEGEND

- Federal Navigation Channel
- Federal Navigation Center Line
- As-built Pipeline/Cable
- Unconfirmed Pipeline/Cable
- Project Depth Contour
- Cable Area
- Placement Area
- Anchorage Area
- Obstruction Point
- Wrecks-Submerged
- Borrow Area
- Shoalest Sounding**
- Beacon, General
- Red Navigation Buoy
- Green Navigation Buoy
- 8' and above
- 8' to -10'
- 10' to -12'
- 12' and below

NOTES:

- Horizontal Coordinate System: North American Datum of 1983 (NAD83), projected to the State Plane Coordinate System (SPCS), Louisiana South Zone. Distance units in U.S. Survey Feet.
- Vertical Datum: Soundings are shown in feet and indicate depths below National Geodetic Vertical Datum of 1929 (NGVD29).
- The location of navigation aids are based on and provided by the U.S. Coast Guard. Positions of navigation aids shown may also have been surveyed in the field by USACE.
- 2015 Aerial Photography data source: NAIP, 1998 DOQQ imagery shown in green from USGS.
- Reference is N.O.A.A. Navigation Chart No. 11354.
- ** Shoalest Sounding per Quarter per Reach.
- *** High frequency (200 kHz) survey data represents the first signal return at a sounding location and will include suspended solids, known as "fluff", if present. Low frequency (20 kHz) survey data normally penetrates through this "fluff" layer to depict elevations of consolidated bottom material. Low frequency accuracies may vary depending on channel conditions and fathometer settings.

Gage Reading: OLD RIVER TB: 37.6 NGVD
 Sea Conditions: CALM
 Vessel Name: OB-189
 Survey Type: CONDITION
 Sounding Frequency***: HIGH



DISCLAIMER: The United States Government furnishes these data and the recipient accepts and uses them with the express understanding that the Government makes no warranty, either expressed or implied, concerning the accuracy, completeness, reliability, usability or suitability for any particular purpose of the data. The recipient shall be responsible for determining the purpose for which the data is used and for ensuring that the data is used only for that purpose. The information depicted on this map represents the results of a survey conducted on or about the date of the survey and is not intended to represent the general condition existing at that time.

U.S. ARMY CORPS OF ENGINEERS
NEW ORLEANS DISTRICT

Submitted:	Surveyed By: RYLAND HOSHMAN
Recommended:	Plotted By: BD
Approved:	Checked By: AC

**OLD RIVER LOCK VICINITY
THREE RIVERS 2
OR_04_3R2_20190723_CS
23 July 2019**

**Sheet Reference Number
4 of 4**