
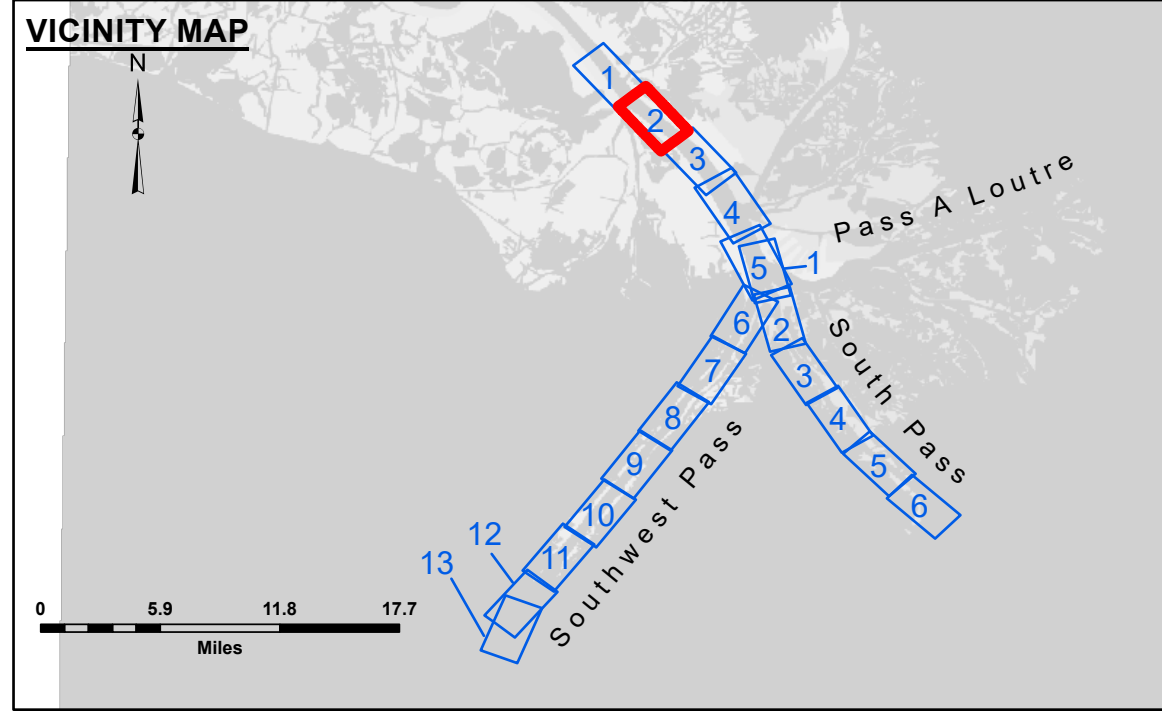


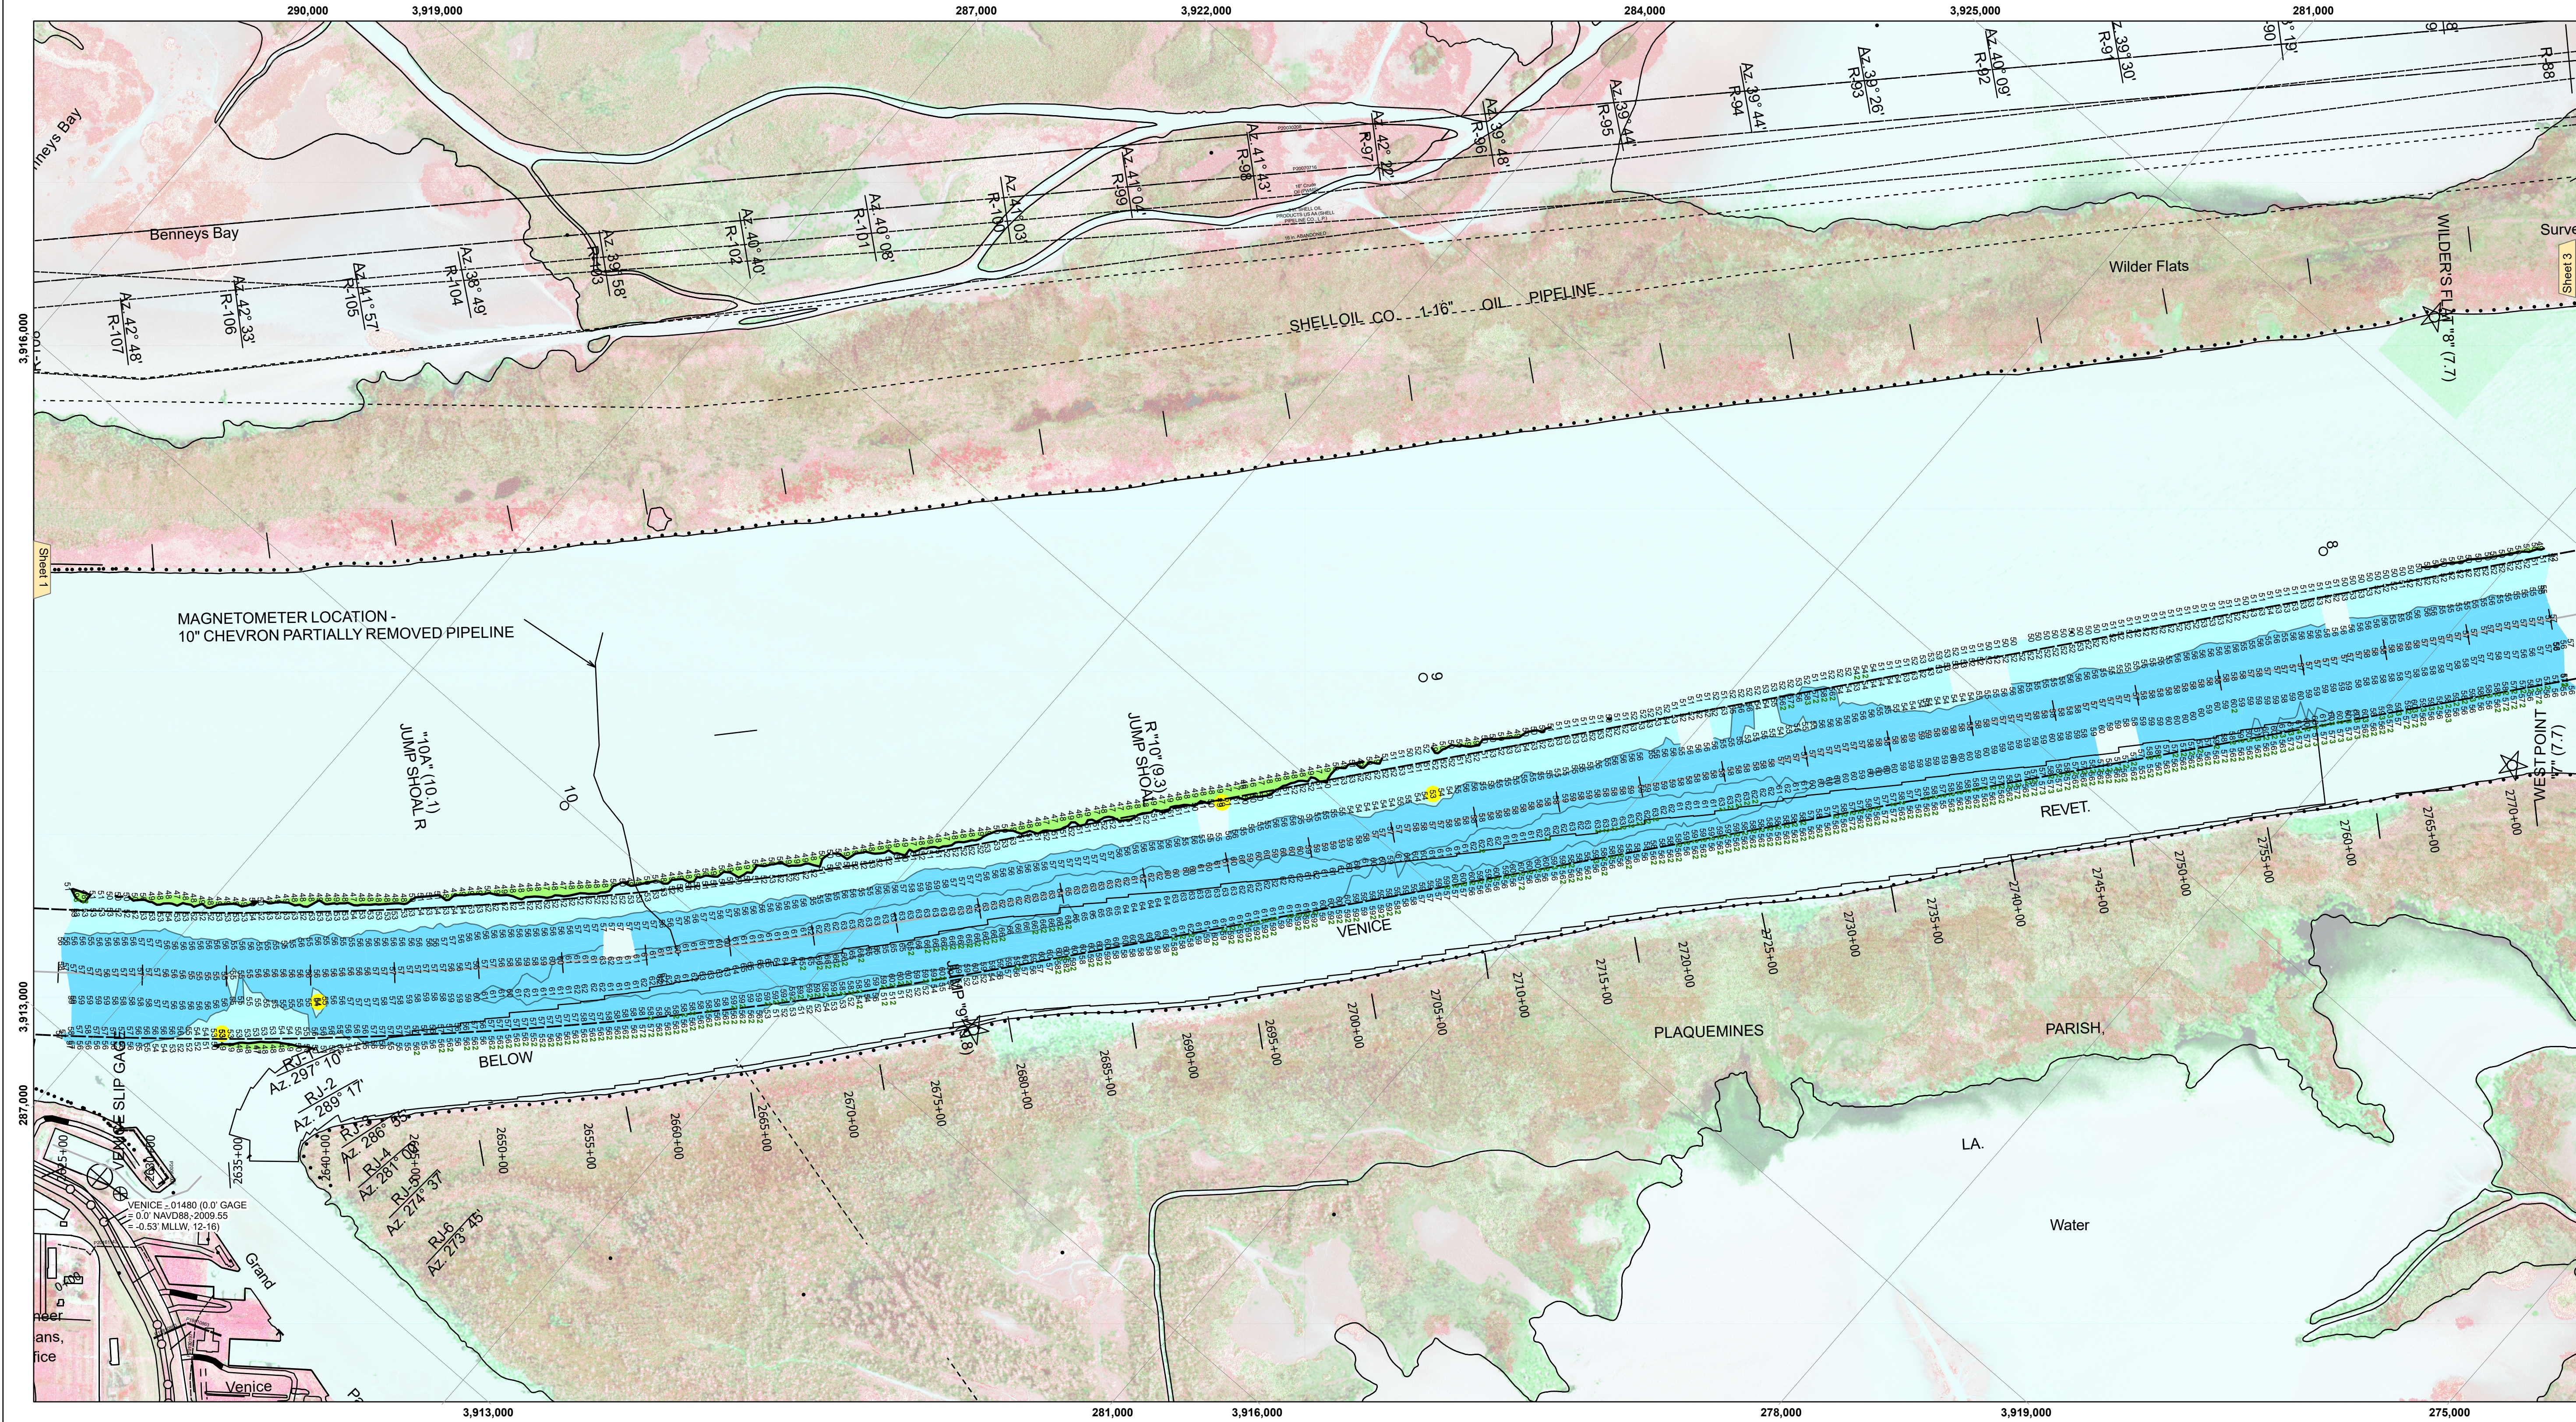

LEGEND

- Federal Navigation Channel
- Federal Navigation Center Line
- As-built Pipeline/Cable
- Unconfirmed Pipeline/Cable
- Project Depth Contour
- Cable Area
- Placement Area
- Anchorage Area
- Obstruction Point
- Wrecks-Submerged
- Fluff Thickness (feet)*
- Borrow Area
- Shoalest Sounding**
- Beacon, General
- Red Navigation Buoy
- Green Navigation Buoy
- 10' and above
- 10' to -20'
- 20' to -30'
- 30' to -40'
- 40' to -45'
- 45' to -50'
- 50' to -55'
- 55' and below

Gage Reading: 0.1 MLLW @ VENICE (01480) @ 0930

Sea Conditions: CALM

Vessel Name: OB-173

Survey Type: CONDITION, SB

Sounding Frequency***: LOW

Vertical Datum: 0.0' NAVD88, 2009.55 = -0.53' MLLW = 2.97' MLC

Datum Relationships for gage 01480 as of February 2021:

Distances on the Mississippi River, above and below Head of Passes are shown at 1 mile intervals.

The location of navigation aids are base on and provided by the U.S. Coast Guard.

2024 Aerial Photography data source: Optimal GEO (1998 DOQQ in green)

Reference is N.O.A.A. Navigation Chart No. 11361.

** Shoalest Sounding per Quarter per Reach.

*** High frequency (200 kHz) survey data represents the first signal return at a sounding location and will include suspended solids, known as "fluff", if present. Low frequency (24 kHz) survey data normally penetrates through this "fluff" layer to depict elevations of consolidated bottom material. Low frequency accuracies may vary depending on channel conditions and fathometer settings.

US Army Corps of Engineers

District: CEMVN

DISCLAIMER

Acme Consultants, The United States Government furnishes these data and the recipient accepts and uses them with the express understanding that the data are not to be used for any purpose other than that for which they were originally collected, and that the data are not to be used for any purpose other than that for which they were originally collected, and that the data are not to be used for any purpose other than that for which they were originally collected.

The information depicted on this map represents the results of a survey conducted by the U.S. Army Corps of Engineers, and is not to be used for any purpose other than that for which it was originally collected.

U.S. ARMY CORPS OF ENGINEERS NEW ORLEANS DISTRICT	
Submitted	Surveyed By: RCB & JJC
Recommended	Plotted By: TSS
Approved	Checked By: MSK

MISSISSIPPI RIVER - B.R. TO GULF

SOUTHWEST PASS - SHEET 2

SW_02_SWP_20250924_CS

24 September 2025

Sheet Reference Number

2 of 13

Revision Number:

5.23.12.3-5.23.12.3