


VICINITY MAP

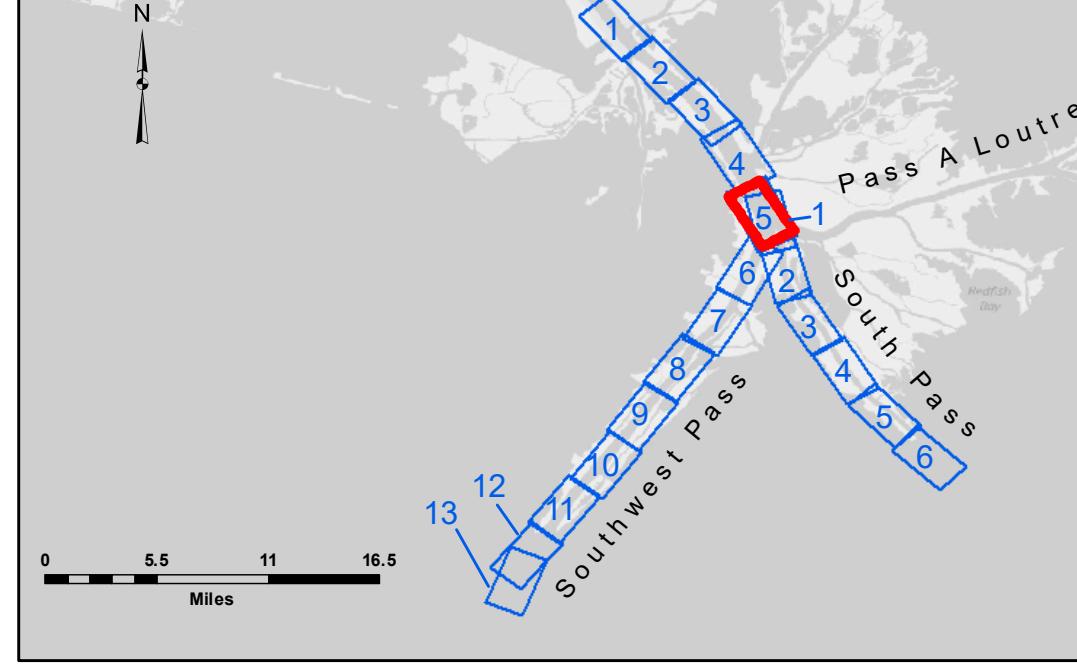


For more information about the study, please contact the study team at 1-800-258-4929 or visit www.cancer.gov.


- Federal Navigation Channel
 - Federal Navigation Center Line
 - As-built Pipeline/Cable
 - Unconfirmed Pipeline/Cable
 - Project Depth Contour



-  Borrow Area
 -  Shoalest Sounding*
 -  Beacon, General
 -  Red Navigation Buoy
 -  Green Navigation Buoy

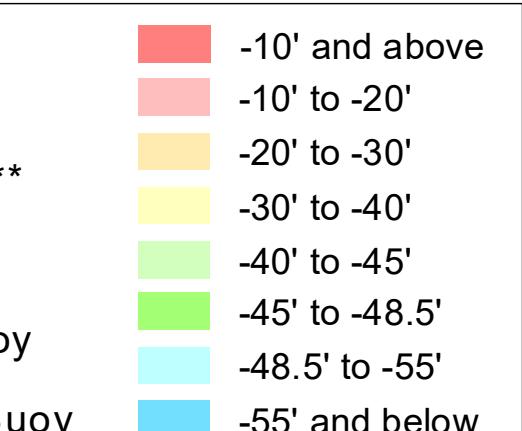

 Gage Reading: 0.6 MLLW @ PILOT TOWN @ 1010
Sea Conditions: CALM, FLUFF
Vessel Name: JOHN BOPP
Survey Type: CONDITION, SB
Sounding Frequency***: LOW

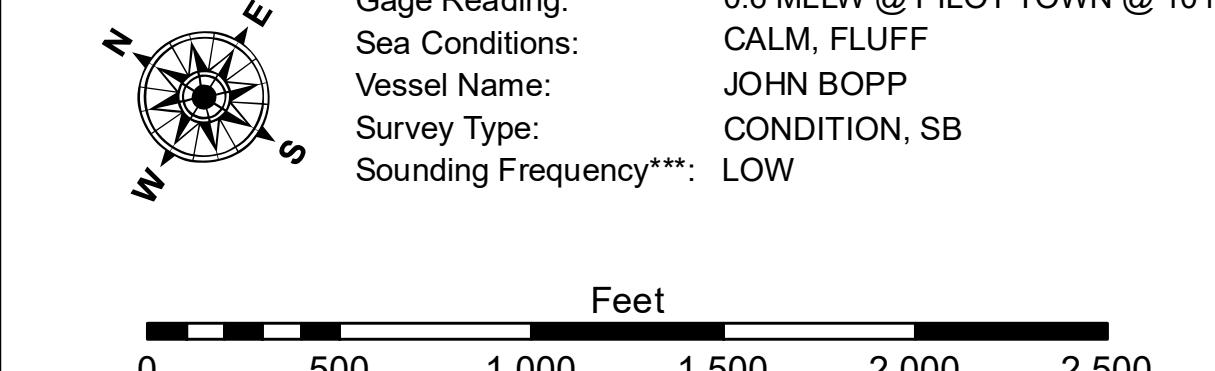

NOTES:

Coordinate System:
Datum of 1983 (NAD83), projected to the State Plane
Coordinate System (SPCS), Louisiana South Zone. Distance units in U.S. Survey Feet.

shown in feet and indicate depths below Mean Lower Low Water (MLLW, 07-11).

Town in feet and indicate depths below Mean Lower Low Water (MLLW).
Elevations for gage 01525 as of July 2015:
0.3' MLLW = 3.20' MLG

• Mississippi River, above and below Head of Passes are shown

navigation aids are base on and provided by the U.S. Coast Guard.

Topography data source: Precision Aerial Reconnaissance

D.A.A. Navigation Chart No. 11361.
Endings per Quarter per Reach.

Sheet
Reference
Number

Revision Number: