

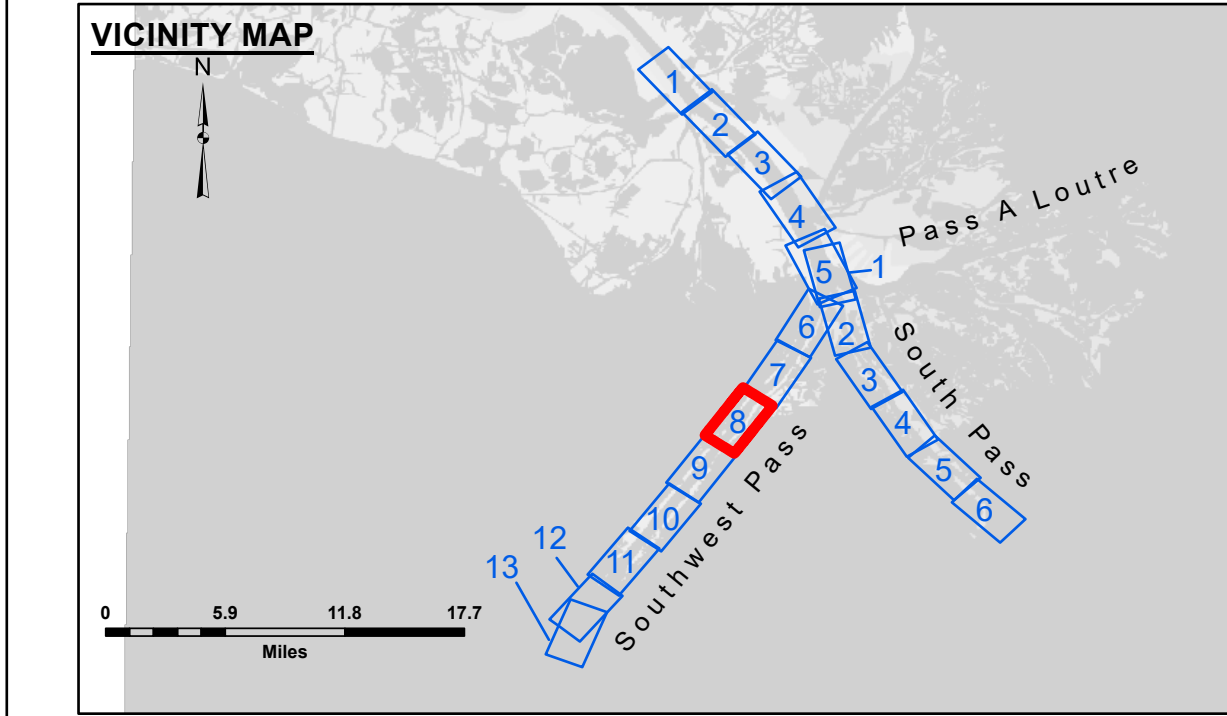


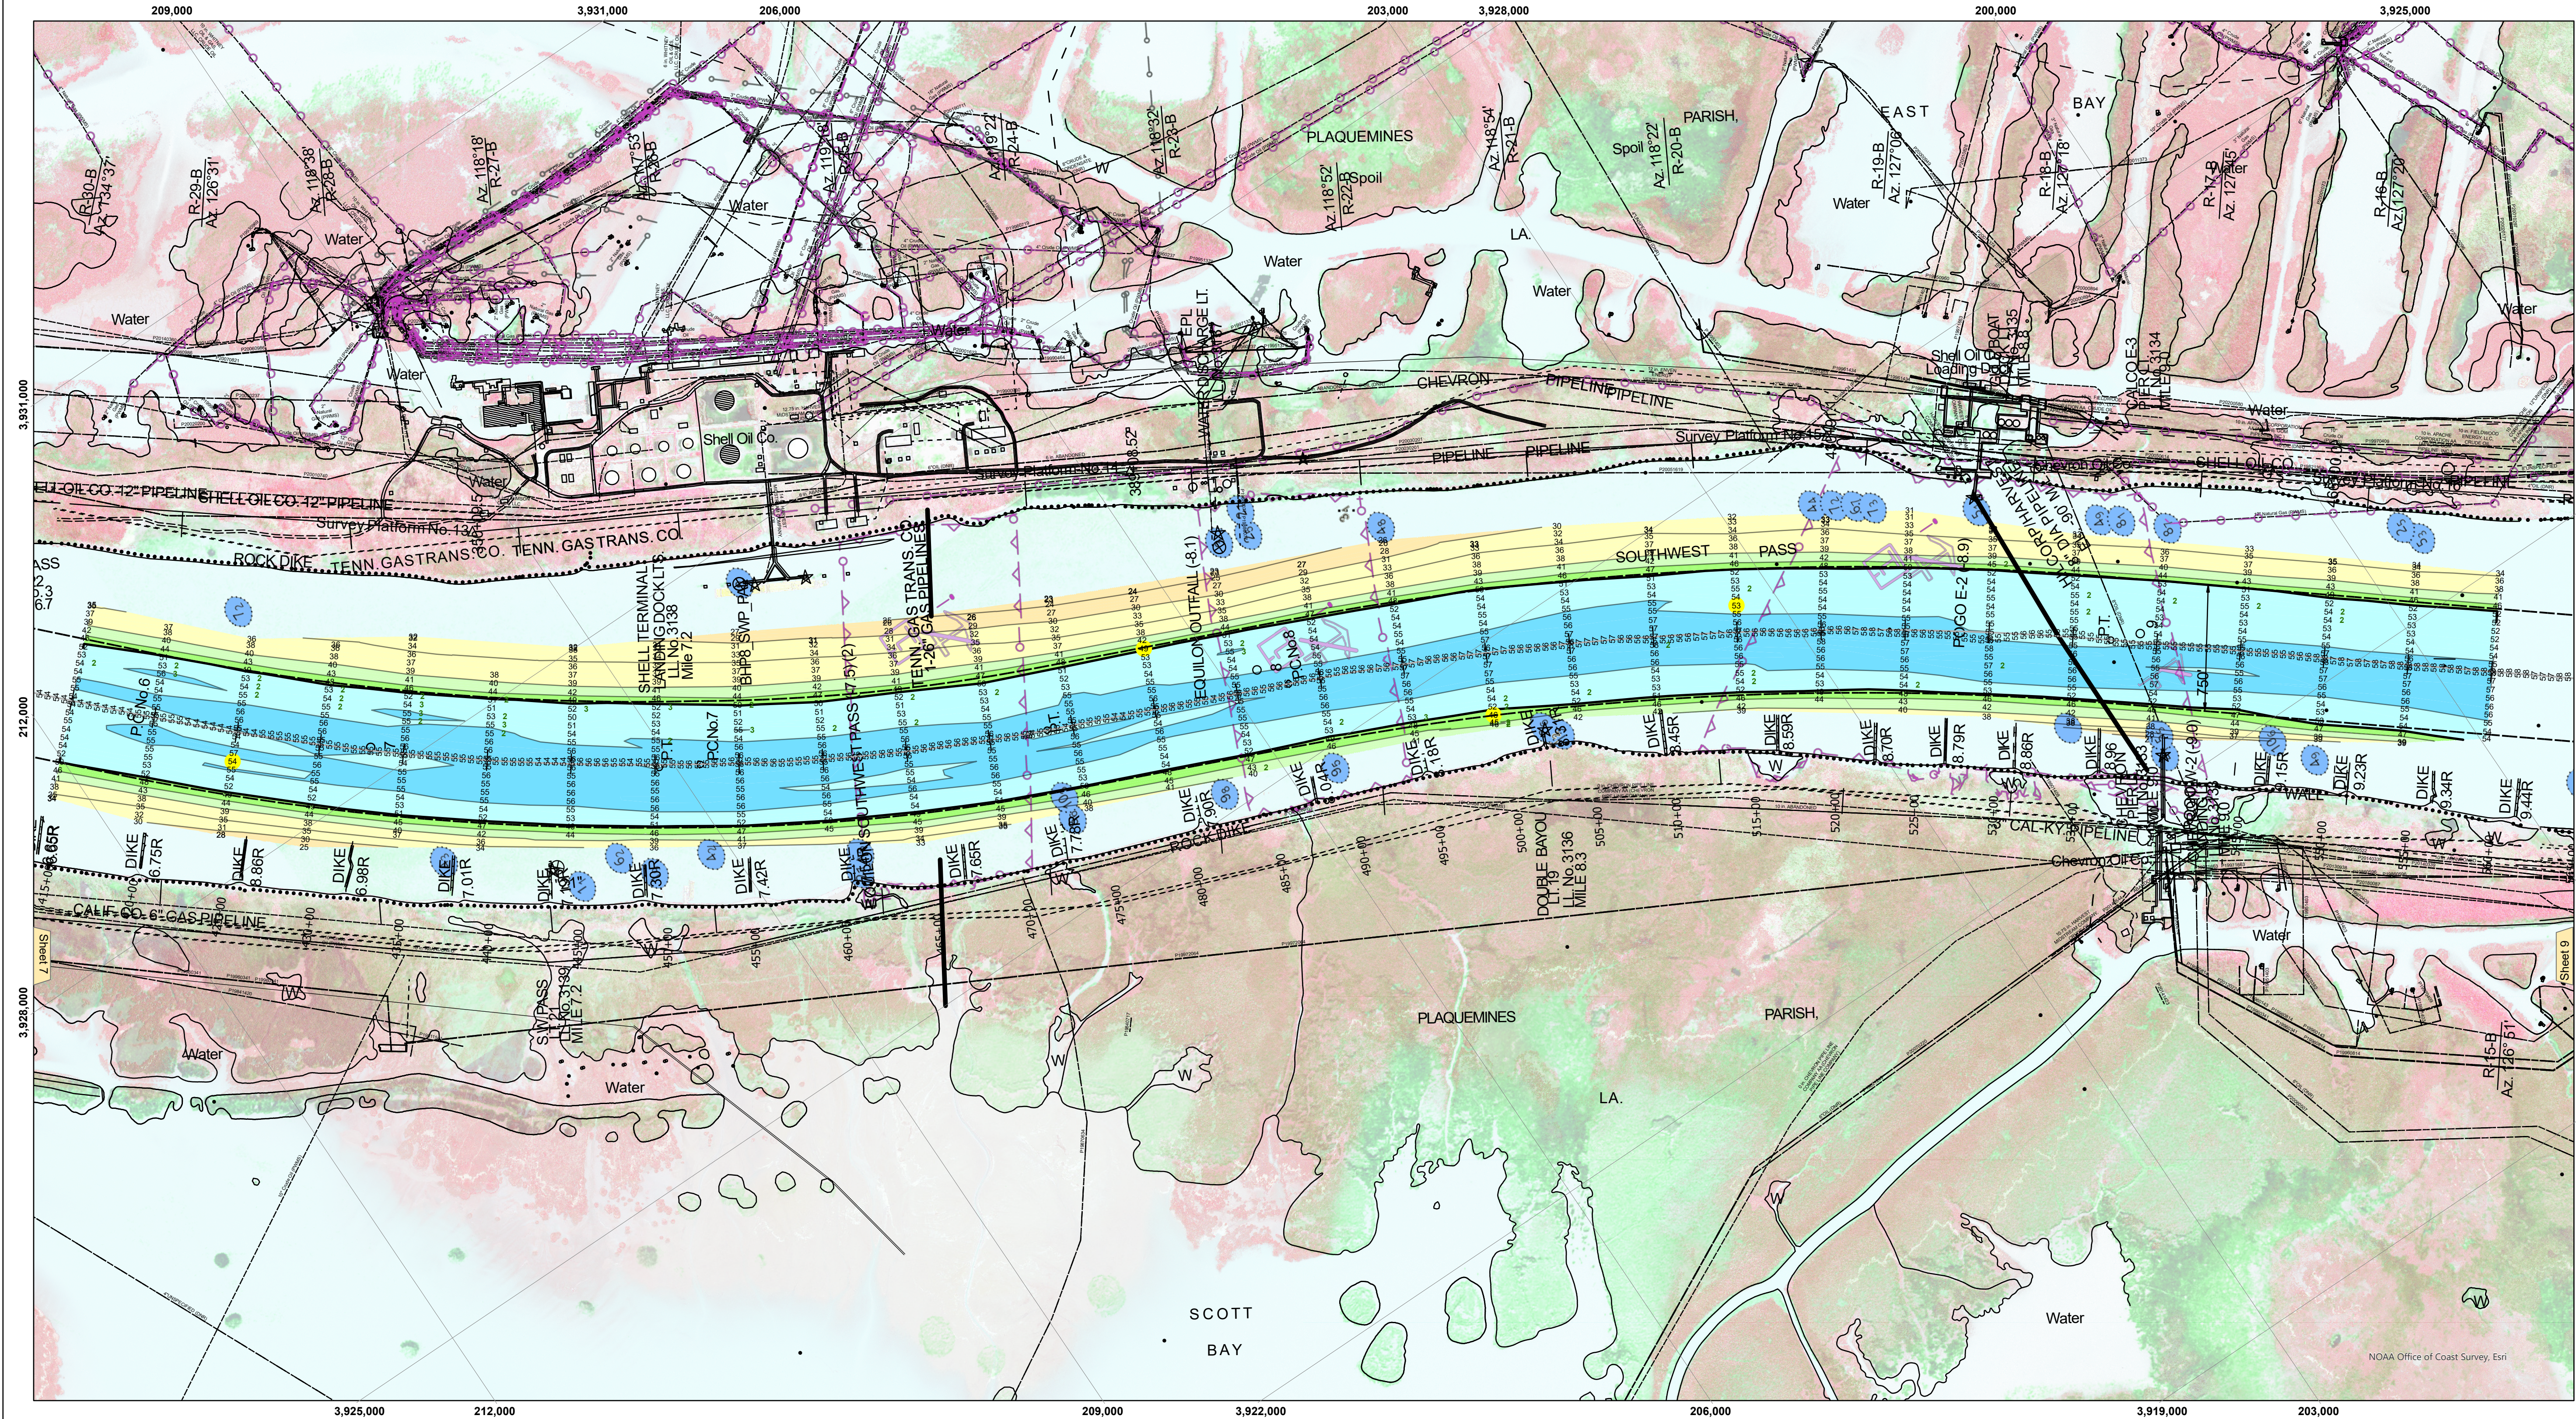

LEGEND

- Federal Navigation Channel
- Federal Navigation Center Line
- As-built Pipeline/Cable
- Unconfirmed Pipeline/Cable
- Project Depth Contour
- Cable Area
- Placement Area
- Anchorage Area
- ⊗ Obstruction Point
- ★ Wrecks-Submerged
- 3 Fluff Thickness (feet)*
- Borrow Area
- Shoalest Sounding**
- ★ Beacon, General
- ◆ Red Navigation Buoy
- ◆ Green Navigation Buoy
- -10' and above
- -10' to -20'
- -20' to -30'
- -30' to -40'
- -40' to -45'
- -45' to -50'
- -50' to -55'
- -55' and below

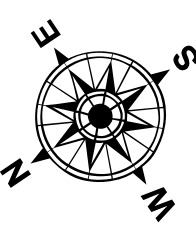

Gage Reading:
Sea Conditions:
Vessel Name:
Survey Type:
Sounding Frequency***:

-0.1 MLLW @ MM 7.2 LT 21 (01575) @ 1030
CHOPPY
TOBIN
CONDITION, SB
LOW

Feet
0 500 1,000 1,500 2,000 2,500

NOTES:
Horizontal Coordinate System:
North American Datum of 1983 (NAD83), projected to the State Plane
Coordinate System (SPCS), Louisiana South Zone. Distance units in U.S. Survey Feet.
Vertical Datum:
Soundings are shown in feet and indicate depths below Mean Lower Low Water (MLLW, 12-15).
Datum Relationships for gage 01575 as of February 2021:
0.0' NAVD83, 2009.55 = 0.10' MLLW = 3.60' MLG
Distances on the Mississippi River, above and below Head of Passes are shown
at 1 mile intervals.
The location of navigation aids are base on and provided by the U.S. Coast Guard.
2024 Aerial Photography data source: Optimal GEO (1998 DOQQ in green)
Reference is N.O.A.A. Navigation Chart No. 11361.
** Shoalest Sounding per Quarter per Reach.
*** High frequency (200 kHz) survey data represents the first signal return at a sounding
location and will include suspended solids, known as "fluff", if present. Low frequency (24 kHz)
survey data normally penetrates through this "fluff" layer to depict elevations of consolidated bottom
material. Low frequency accuracies may vary depending on channel conditions and fathometer
settings.

U.S. ARMY CORPS OF ENGINEERS NEW ORLEANS DISTRICT			
Submitted:	Surveyed By: RCB & RCC	Plotted By: TSS	Checked By: MSK
Recommended:	Chief, Survey Section		Chief, Waterways Maintenance Section
Approved:			

MISSISSIPPI RIVER - B.R. TO GULF
SOUTHWEST PASS - SHEET 8
SW_08_SWPX_20260115_CS
15 January 2026

Sheet
Reference
Number
8 of 13

Revision Number:
5.23.12.3-5.23.12.3

US Army Corps
of Engineers
District: CEMVN

Disclaimer: The data represented by the results of data collection and processing for a specific US Army Corps of Engineers activity and indicates the general existing conditions. As such, the Corps does not warrant the accuracy, completeness, or reliability of the data for any purpose other than the intended use. The user is responsible for the results of any application of the data for other than the intended use. The Corps does not warrant the accuracy, completeness, or reliability of the data for any purpose other than the intended use. The user is responsible for the results of any application of the data for other than the intended use. The Corps does not warrant the accuracy, completeness, or reliability of the data for any purpose other than the intended use. The user is responsible for the results of any application of the data for other than the intended use.