

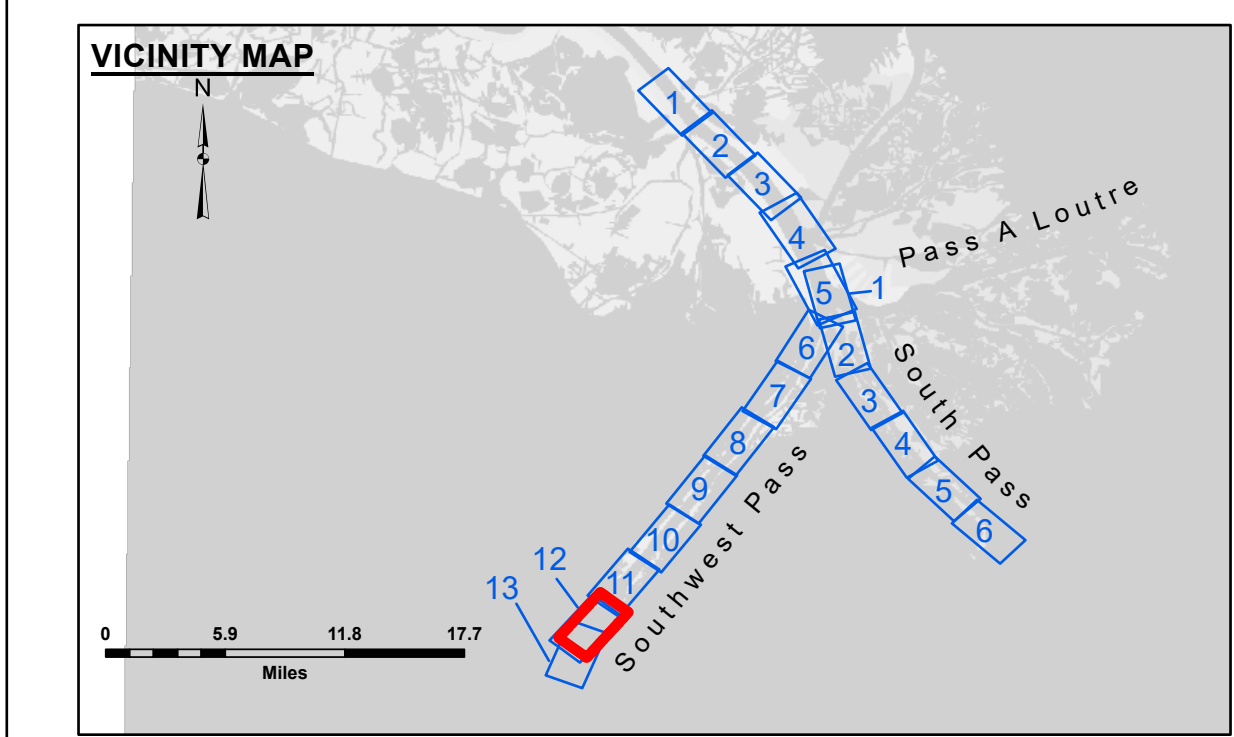


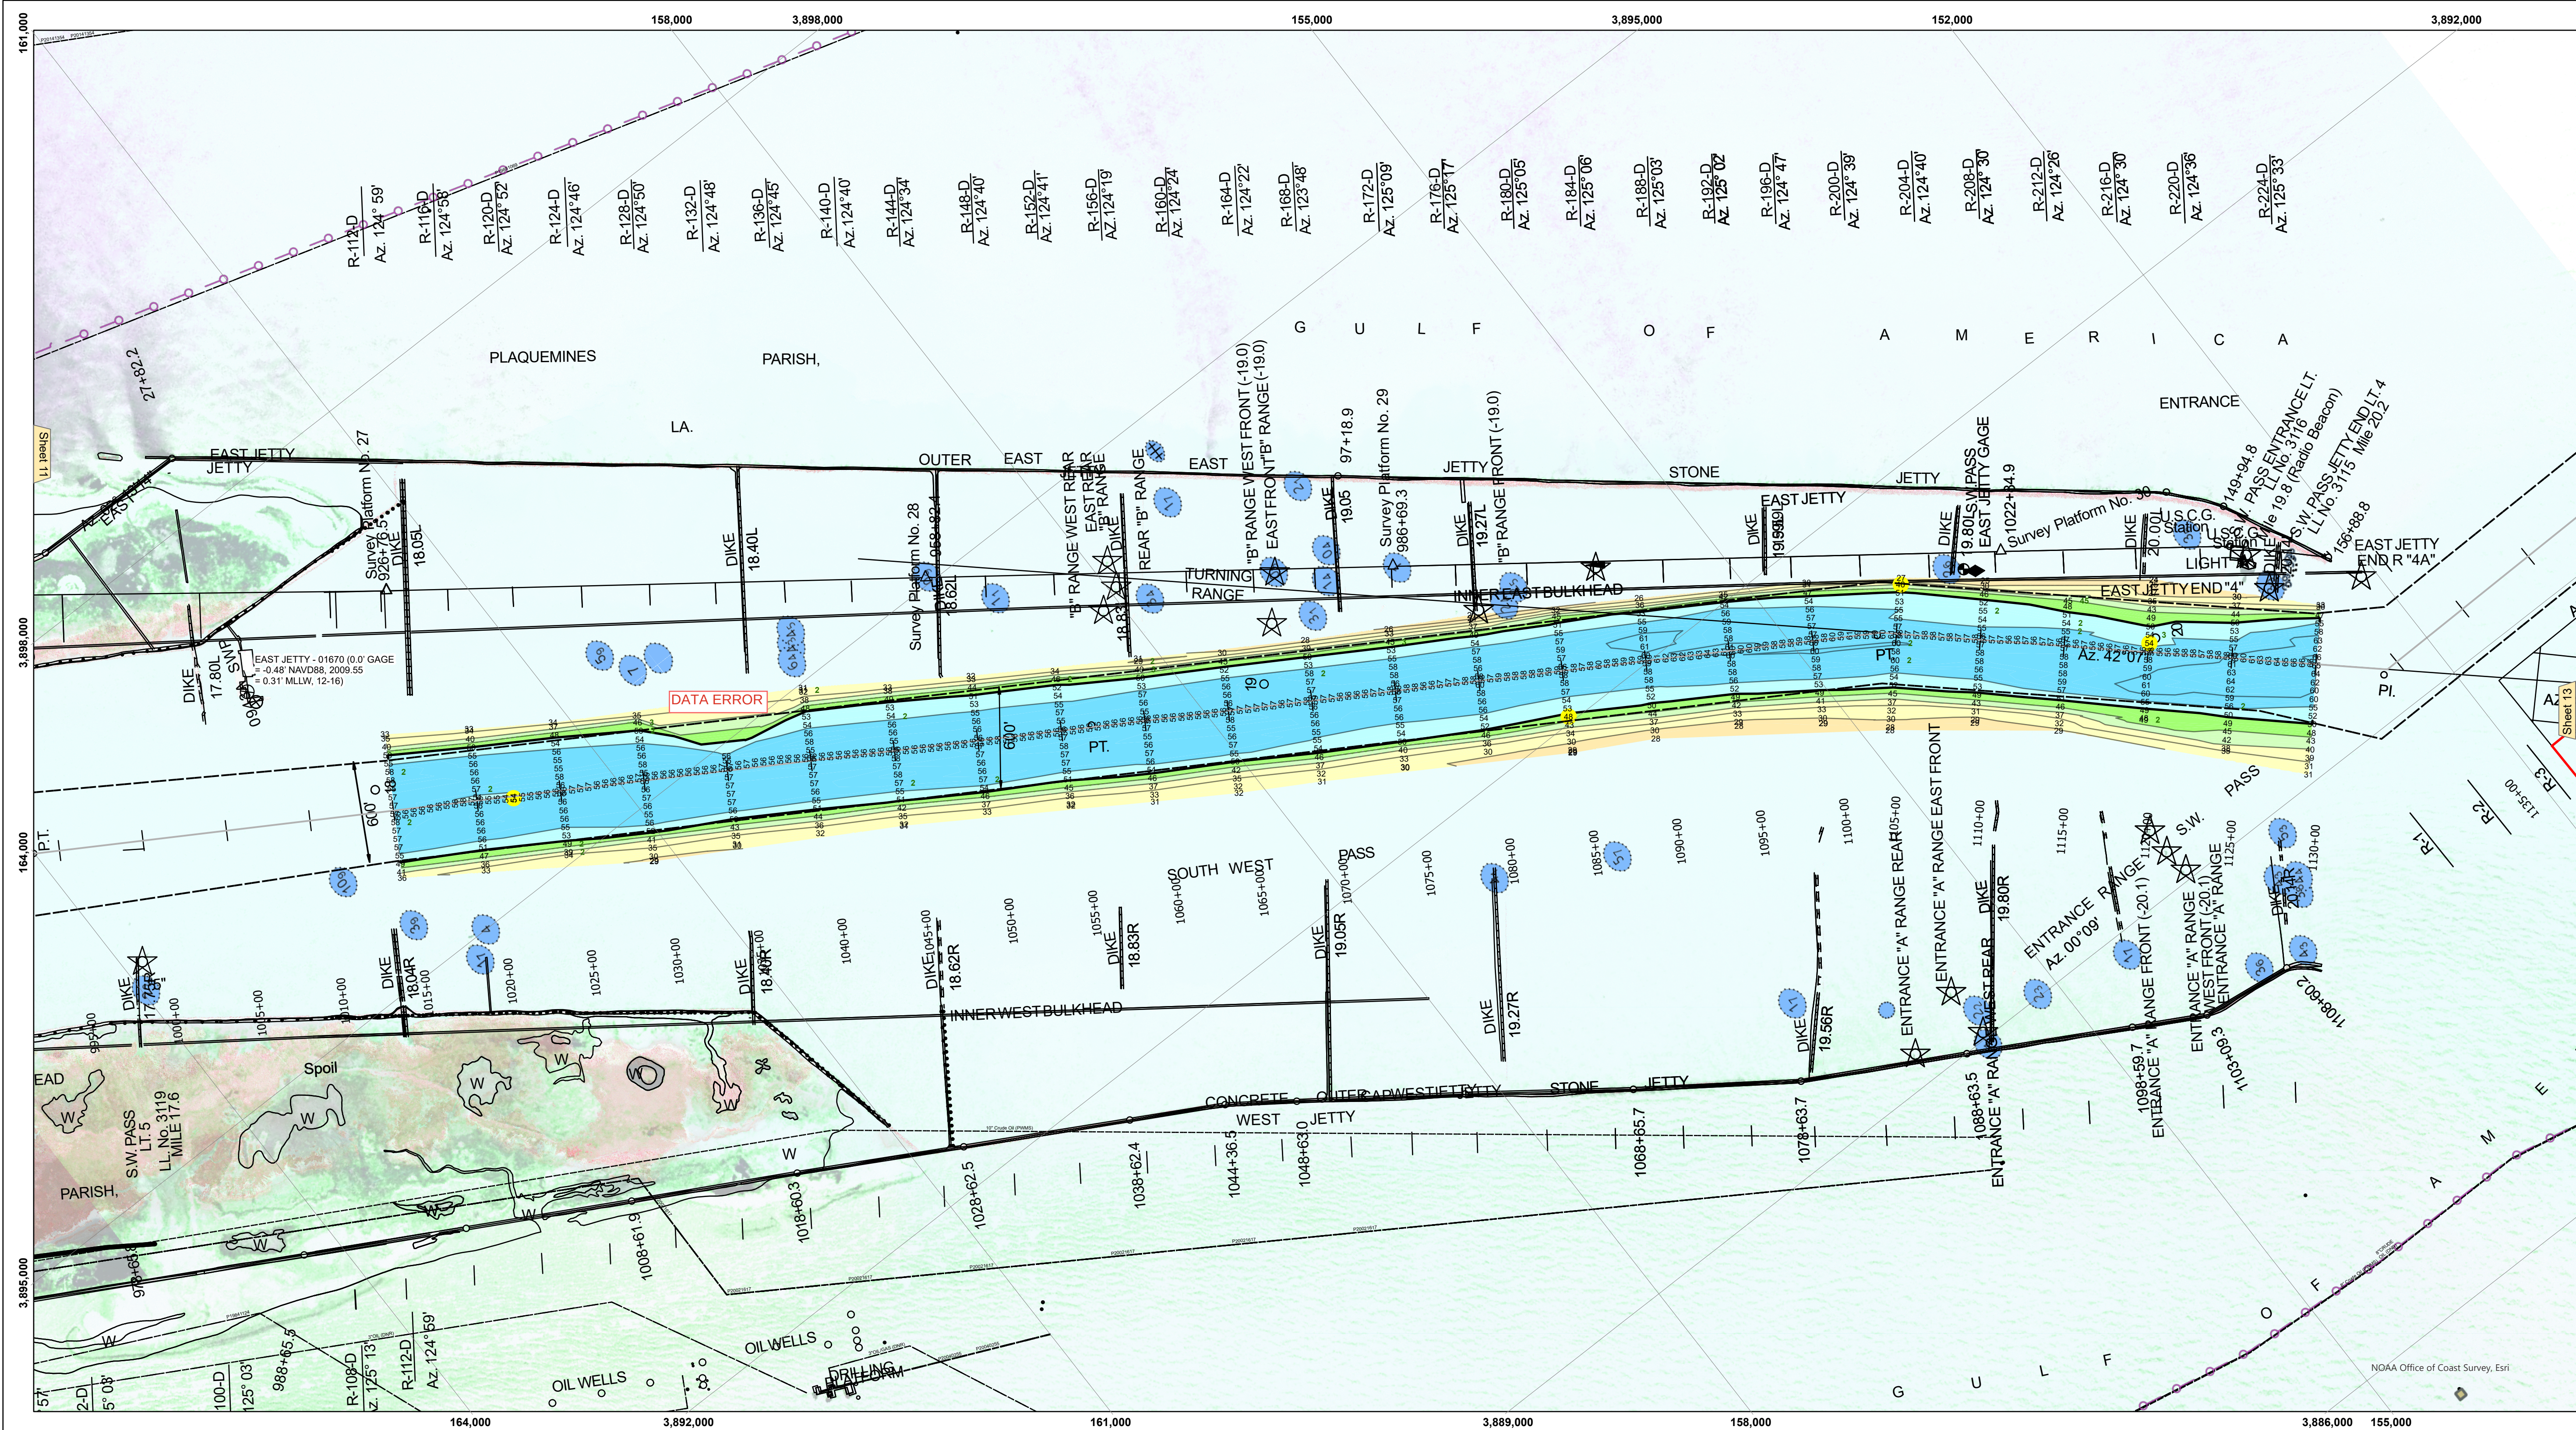

LEGEND

- Federal Navigation Channel
- Federal Navigation Center Line
- As-built Pipeline/Cable
- Unconfirmed Pipeline/Cable
- Project Depth Contour
- Cable Area
- Placement Area
- Anchorage Area
- ⊗ Obstruction Point
- ★ Wrecks-Submerged
- 3 Fluff Thickness (feet)*
- Borrow Area
- Shoalest Sounding**
- ★ Beacon, General
- ◆ Red Navigation Buoy
- ◆ Green Navigation Buoy
- -10' and above
- -10' to -20'
- -20' to -30'
- -30' to -40'
- -40' to -45'
- -45' to -50'
- -50' to -55'
- -55' and below

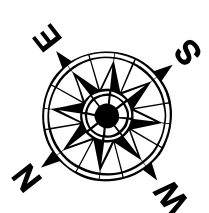

Gage Reading:
Sea Conditions:
Vessel Name:
Survey Type:
Sounding Frequency***:

0.3 MLLW @ EAST JETTY (01670) @ 1240
CALM
BLANCHARD
CONDITION, SB
LOW

Feet
0 500 1,000 1,500 2,000 2,500

NOTES:
Horizontal Coordinate System:
North American Datum of 1983 (NAD83), projected to the State Plane
Coordinate System (SPCS), Louisiana South Zone. Distance units in U.S. Survey Feet.
Vertical Datum:
Soundings are shown in feet and indicate depths below Mean Lower Low Water (MLLW, 12-16).
Datum Relationships for gage 01670 as of February 2021:
0.0' NAVD88, 2009.55 = 0.79' MLLW = 4.29' MLG
Distances on the Mississippi River, above and below Head of Passes are shown
at 1 mile intervals.
The location of navigation aids are base on and provided by the U.S. Coast Guard.
2024 Aerial Photography data source: Optimal GEO (1998 DOQQ in green)
Reference is N.O.A.A. Navigation Chart No. 11361.
** Shoalest Sounding per Quarter per Reach.
*** High frequency (200 kHz) survey data represents the first signal return at a sounding
location and will include suspended solids, known as "fluff", if present. Low frequency (24 kHz)
survey data normally penetrates through this "fluff" layer to depict elevations of consolidated bottom
material. Low frequency accuracies may vary depending on channel conditions and fathometer
settings.

U.S. ARMY CORPS OF ENGINEERS NEW ORLEANS DISTRICT			
Submitted:	Surveyed By: JUC & DED	Plotted By: TSS	Checked By: MSK
Recommended:	Chief, Survey Section	Chief, Waterways Maintenance Section	
Approved:			

MISSISSIPPI RIVER - B.R. TO GULF
SOUTHWEST PASS - SHEET 12
SW_12_SWPX_20260122_CS
22 January 2026

Sheet
Reference
Number
12 of 13

Revision Number:
5.23.12.5.3.23.12.3

**US Army Corps
of Engineers
District: CEMVN**

DISCLAIMER
The information depicted on this map represents the results of a
survey conducted by the U.S. Army Corps of Engineers. The U.S. Army Corps of Engineers
does not warrant the accuracy or completeness of the information depicted on this map.
The user is responsible for the results of any application of the data for other than its intended
purpose. The U.S. Army Corps of Engineers is not responsible for any errors or omissions in the
information depicted on this map. The U.S. Army Corps of Engineers is not responsible for any
damages or losses resulting from the use of the information depicted on this map. The U.S. Army Corps of Engineers
is not responsible for any damages or losses resulting from the use of the information depicted on this map.
The U.S. Army Corps of Engineers is not responsible for any damages or losses resulting from the use of the information depicted on this map.