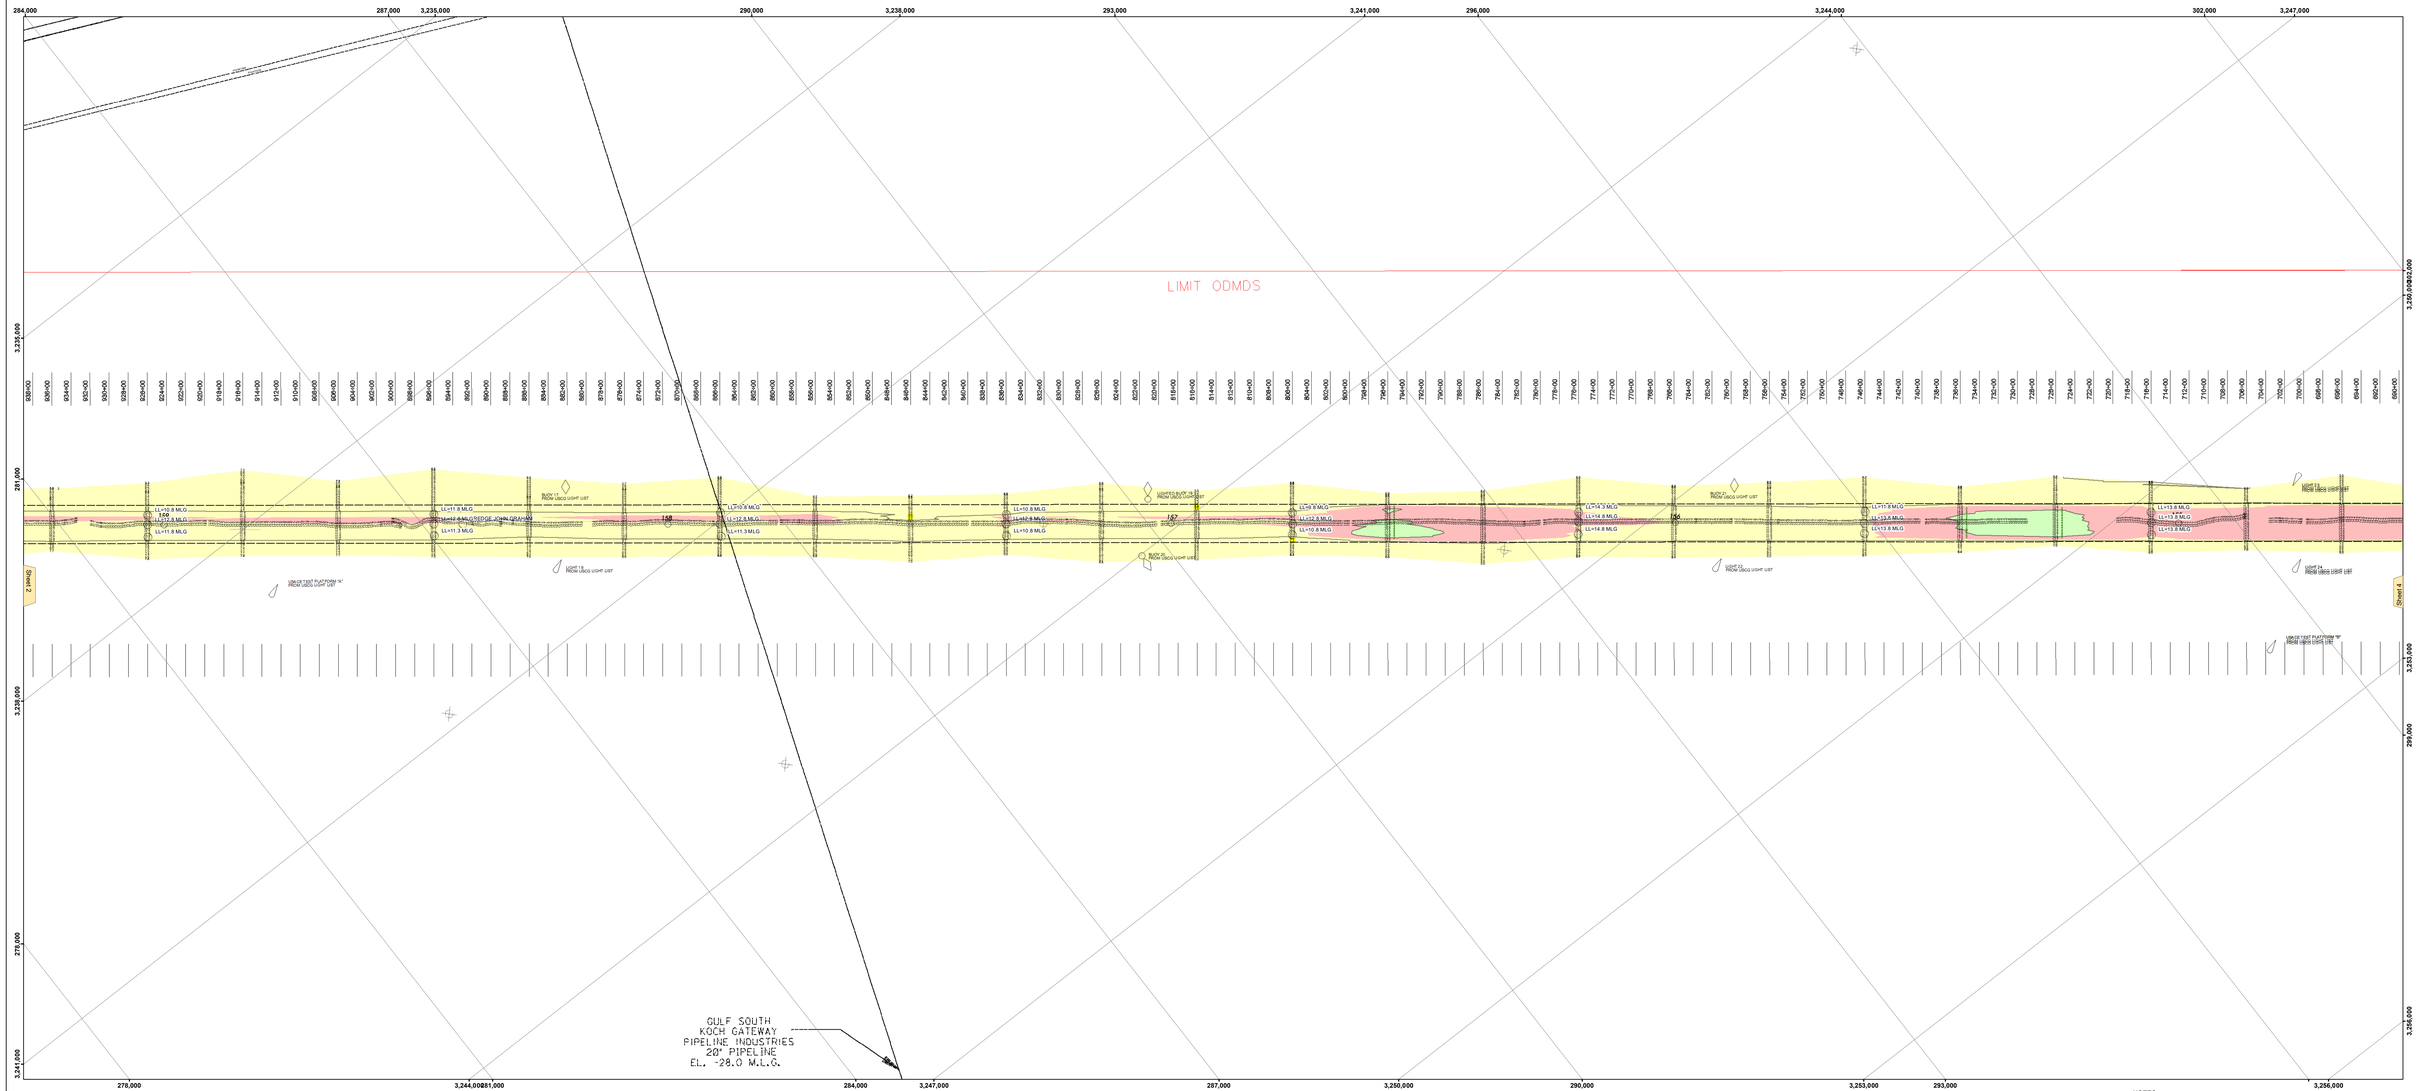

VICINITY MAP

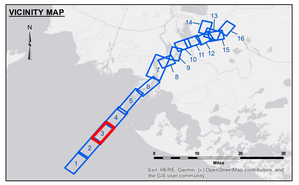

LEGEND

- Federal Navigation Channel
- Federal Navigation Center Line
- As-built Pipeline/Cable
- Unconfirmed Pipeline/Cable
- Project Depth Contour
- Cable Area
- Placement Area
- Anchorage Area
- Obstruction Point
- Wrecks-Submerged
- Borrow Area
- Shoalest Sounding**
- Beacon, General
- Red Navigation Buoy
- Green Navigation Buoy
- -12' and above
- -12' to -15'
- -15' to -18'
- -18' to -20'
- -20' and below
- 3 Fluff Thickness*

Gage Reading: B-17: 2.15 MLG AVG.
Sea Conditions: 1-3 FT
Vessel Name: M/V VALENTOUR
Survey Type: CONDITION
Sounding Frequency***: LOW

Feet
0 800 1,600 2,400 3,200

NOTES:
Horizontal Coordinate System:
North American Datum of 1983 (NAD83), projected to the State Plane Coordinate System (SPCS), Louisiana South Zone. Distance units in U.S. Survey Feet.

Vertical Datum:
Soundings are shown in feet and indicate depths below Mean Low Gulf Datum (MLG).
Datum Relationships for the gage 8860I as of August 2013:
0.0' NAVD88 = 0.6' MLLW = 1.5' MLG

Distances on the Atchafalaya River are shown at 1 mile intervals.

The location of navigation aids are base on and provided by the U.S. Coast Guard.

2013 Aerial Photography data source: GEOCLIP, Atlantic Group, LLC. (1998 DOQQ imagery in green).

Reference is N.O.A.A. Navigation Chart No. 11354.

* Difference between high and low frequency elevations where greater than 1.0'.

** Shoalest Sounding per Quarter per Reach.

*** High frequency (200 kHz) survey data represents the first signal return at a sounding location and will include suspended solids, known as "fluff", if present. Low frequency (20 kHz) survey data normally penetrates through this "fluff" layer to depict elevations of consolidated bottom material. Low frequency accuracies may vary depending on channel conditions and fathometer settings.

US Army Corps of Engineers
District: CEMVN

DISCLAIMER
Access Constraints: This data contains the records of data collected by the United States Government for its own use. Its accuracy is only as accurate as the government working measures its own needs. The United States Government does not guarantee the accuracy of any information contained in this data set. The United States Government does not assume any liability for any use of the information contained in this data set.

Data Constraints: Hydrographic survey data is subject to change due to natural and man-made events. Depths are measured at the time of survey and are not guaranteed to be the same at any other time or place. Navigation aids are subject to change or discontinuance without notice. Data is provided "as is" without warranty of any kind, either expressed or implied. The data is provided for navigational purposes only. Navigation charts should be used in conjunction with the data. Contact the U.S. Army Corps of Engineers, New Orleans District, Channel Improvement Section for more information.

Distribution Limits: The data contained in this set of data is intended for use by the United States Government. Use of this data by other parties than the government working measures is only at their own risk. The United States Government does not assume any liability for any use of the information contained in this data set by other than the intended audience.

Data Limitations: The data contained in this set of data is intended for use by the United States Government for its own use. Its accuracy is only as accurate as the government working measures its own needs. The United States Government does not guarantee the accuracy of any information contained in this data set. The United States shall not be liable for any damages suffered as the result of using, modifying, contributing, or distributing this data set. 

U.S. ARMY CORPS OF ENGINEERS
NEW ORLEANS DISTRICT

Surveyed By: RV/LAADCANAS	Plotted By: BD	Checked By: AO	
Submitted:	Recommended: Chief, Survey Section	Approved: Chief, Waterways Maintenance Section	

ATCHAFALAYA RIVER BAR CHANNEL
AR_03_BAR_20200128_AD
28 January 2020

Sheet Reference Number
3 of 16

Revision Number
4/8-29/1997/6/22