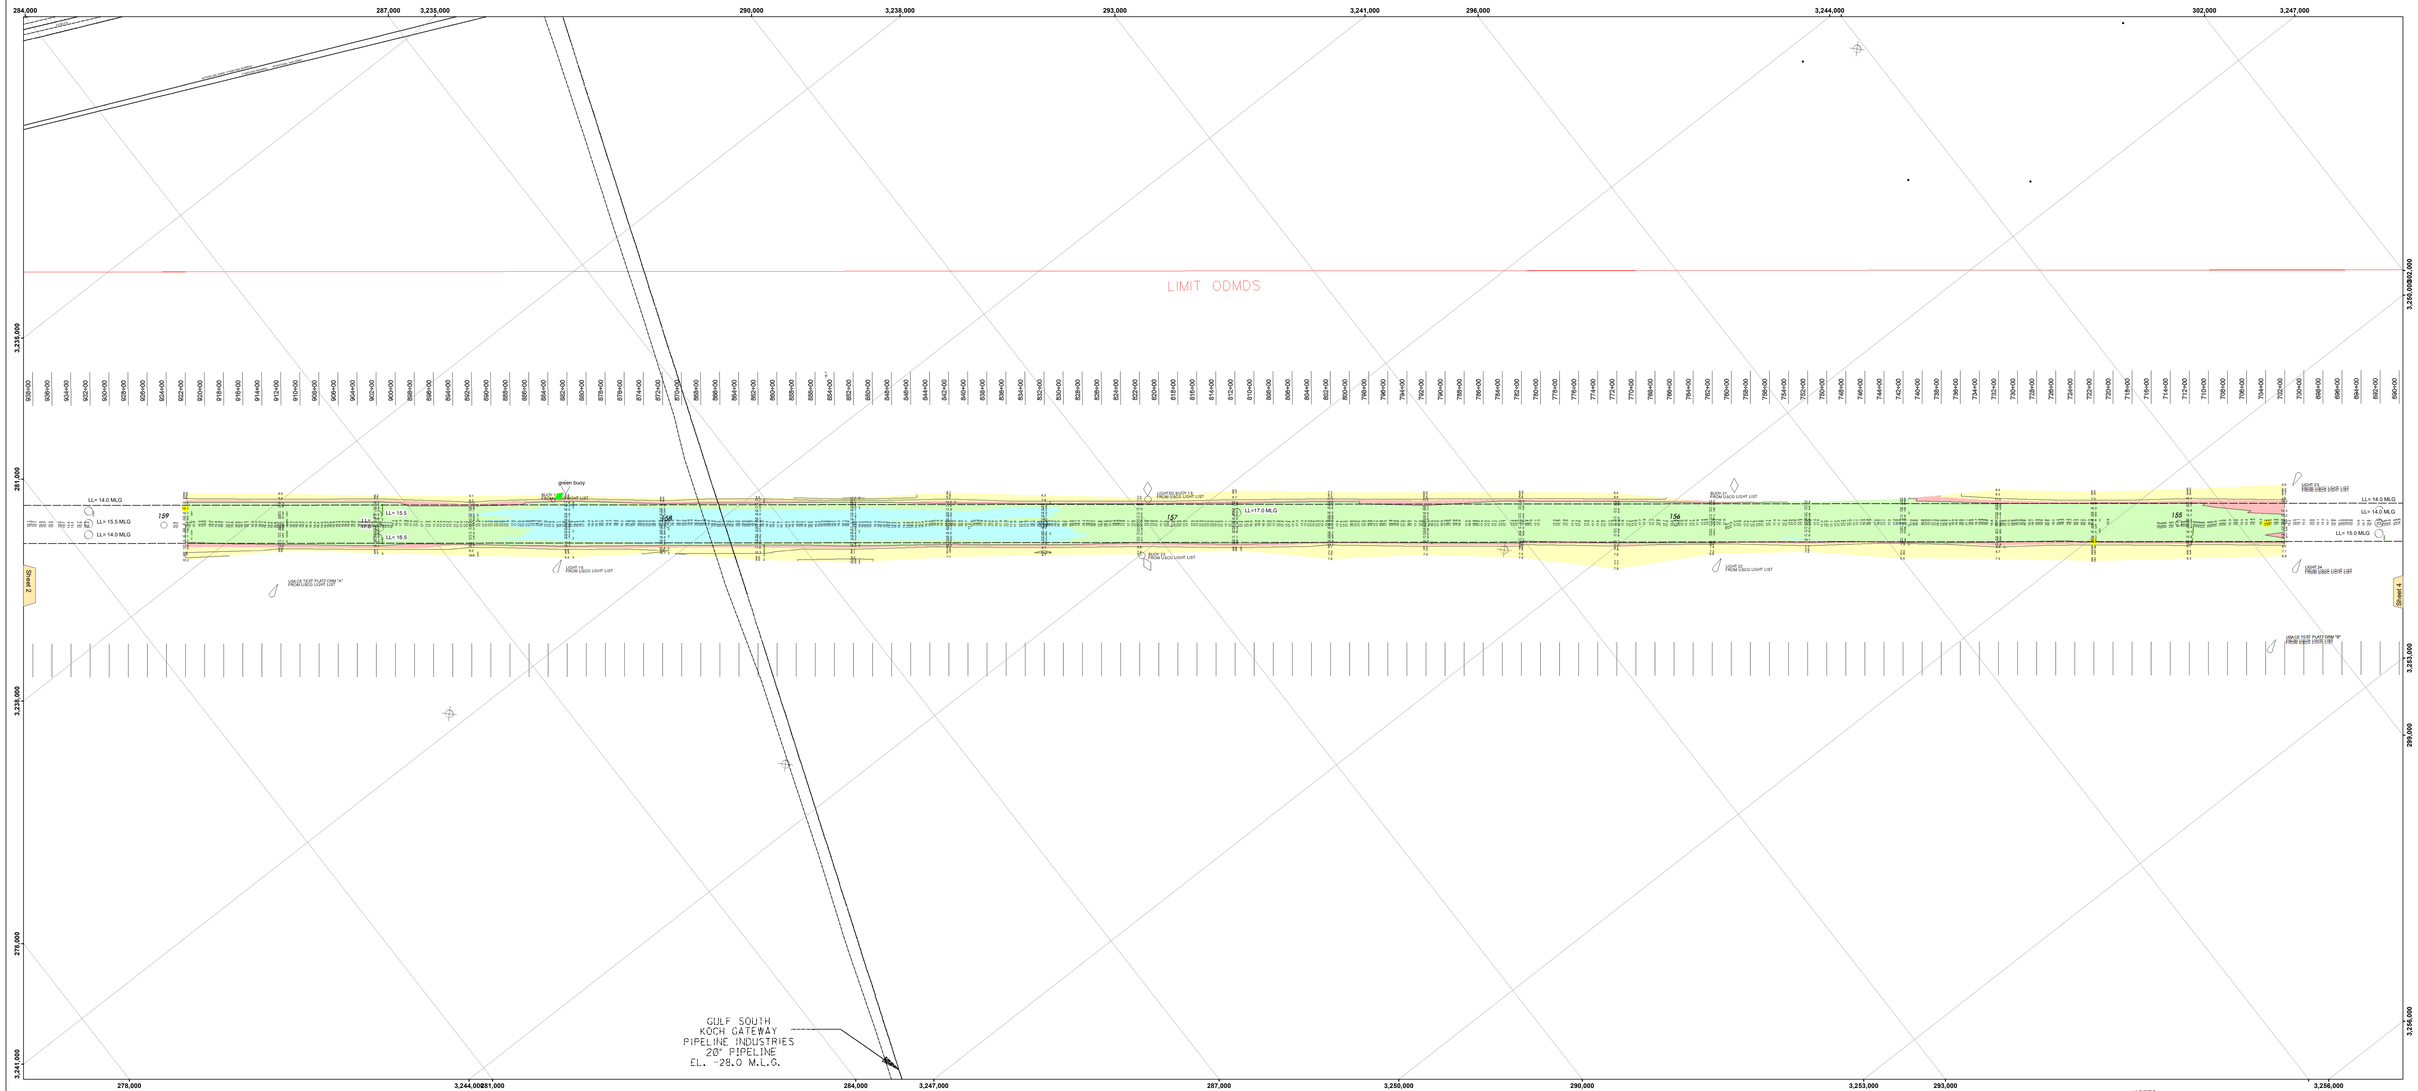

US Army Corps of Engineers
District: CEMVN

DISCLAIMER

Distribution Liability: The data represents the results of data collection and analysis at the time and for the purposes noted. It may not be suitable for other purposes or at other times. The Corps of Engineers makes no warranty, express or implied, nor assumes any liability for future use of the data or products derived from the data. Users are responsible for the proper use of the information and for the application of the data for other than its intended purpose.

Data Constraints: Hydrographic survey data is subject to change due to natural and man-made events such as storms, dredging, and shoaling and scouring and moving sediments. Prior to using any data, users should contact the District to determine if more recent information is available. Data is provided in accordance with the Freedom of Information Act, 5 U.S. Code 552, as amended, and 33 CFR Part 286 implementing regulations.

COPYRIGHT

Access Constraints: This information is protected by copyright and is subject to the following restrictions: Permission is hereby granted for the free electronic copying of this information within the framework of non-commercial use, provided that this information is not modified and that any copyright notices and any other notices or disclaimers included with the data are preserved and any copy is accompanied by a statement that the data is from the US Army Corps of Engineers.

U.S. ARMY CORPS OF ENGINEERS
NEW ORLEANS DISTRICT

Submitted:		Surveyed By: PS,CR	
Recommended:	Chief, Survey Section	Plotted By: JR	Checked By: JH
Approved:	Chief, Waterways Maintenance Section		

ATCHAFALAYA RIVER BAR CHANNEL

AR_03_BAR_20240917_CS_POSTSTORM

17 September 2024

Sheet Reference Number

3 of 16

Revision Number: 4.2-20260420

VICINITY MAP

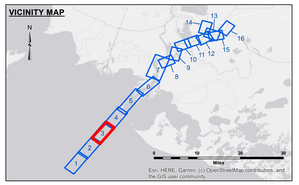

LEGEND

- Federal Navigation Channel
- Federal Navigation Center Line
- As-built Pipeline/Cable
- Unconfirmed Pipeline/Cable
- Project Depth Contour
- Cable Area
- Placement Area
- Anchorage Area
- Obstruction Point
- Wrecks-Submerged
- Borrow Area
- Shoalest Sounding**
- Beacon, General
- Red Navigation Buoy
- Green Navigation Buoy
- -12' and above
- -12' to -15'
- -15' to -18'
- -18' to -20'
- -20' and below
- 3 Fluff Thickness*

Gage Reading: EUGENE STAFF: 2.0 MLG AVG
Sea Conditions: 1 FT
Vessel Name: OB169
Survey Type: CONDITION
Sounding Frequency***: LOW

Feet
0 800 1,600 2,400 3,200

NOTES:

Horizontal Coordinate System:
North American Datum of 1983 (NAD83), projected to the State Plane Coordinate System (SPCS), Louisiana South Zone. Distance units in U.S. Survey Feet.

Vertical Datum:
Soundings are shown in feet and indicate depths below Mean Low Gulf Datum (MLG).
Datum Relationships for the gage 88600 as of August 2013:
0.0' NAVD88 = 0.6' MLLW = 1.5' MLG

Distances on the Atchafalaya River are shown at 1 mile intervals.

The location of navigation aids are base on and provided by the U.S. Coast Guard.

2013 Aerial Photography data source: GEOCLIP, Atlantic Group, LLC. (1998 DOQQ imagery in green).

Reference is N.O.A.A. Navigation Chart No. 11354.

* Difference between high and low frequency elevations where greater than 1.0'.

** Shoalest Sounding per Quarter per Reach.

*** High frequency (200 kHz) survey data represents the first signal return at a sounding location and will include suspended solids, known as "fluff", if present. Low frequency (20 kHz) survey data normally penetrates through this "fluff" layer to depict elevations of consolidated bottom material. Low frequency accuracies may vary depending on channel conditions and fathometer settings.