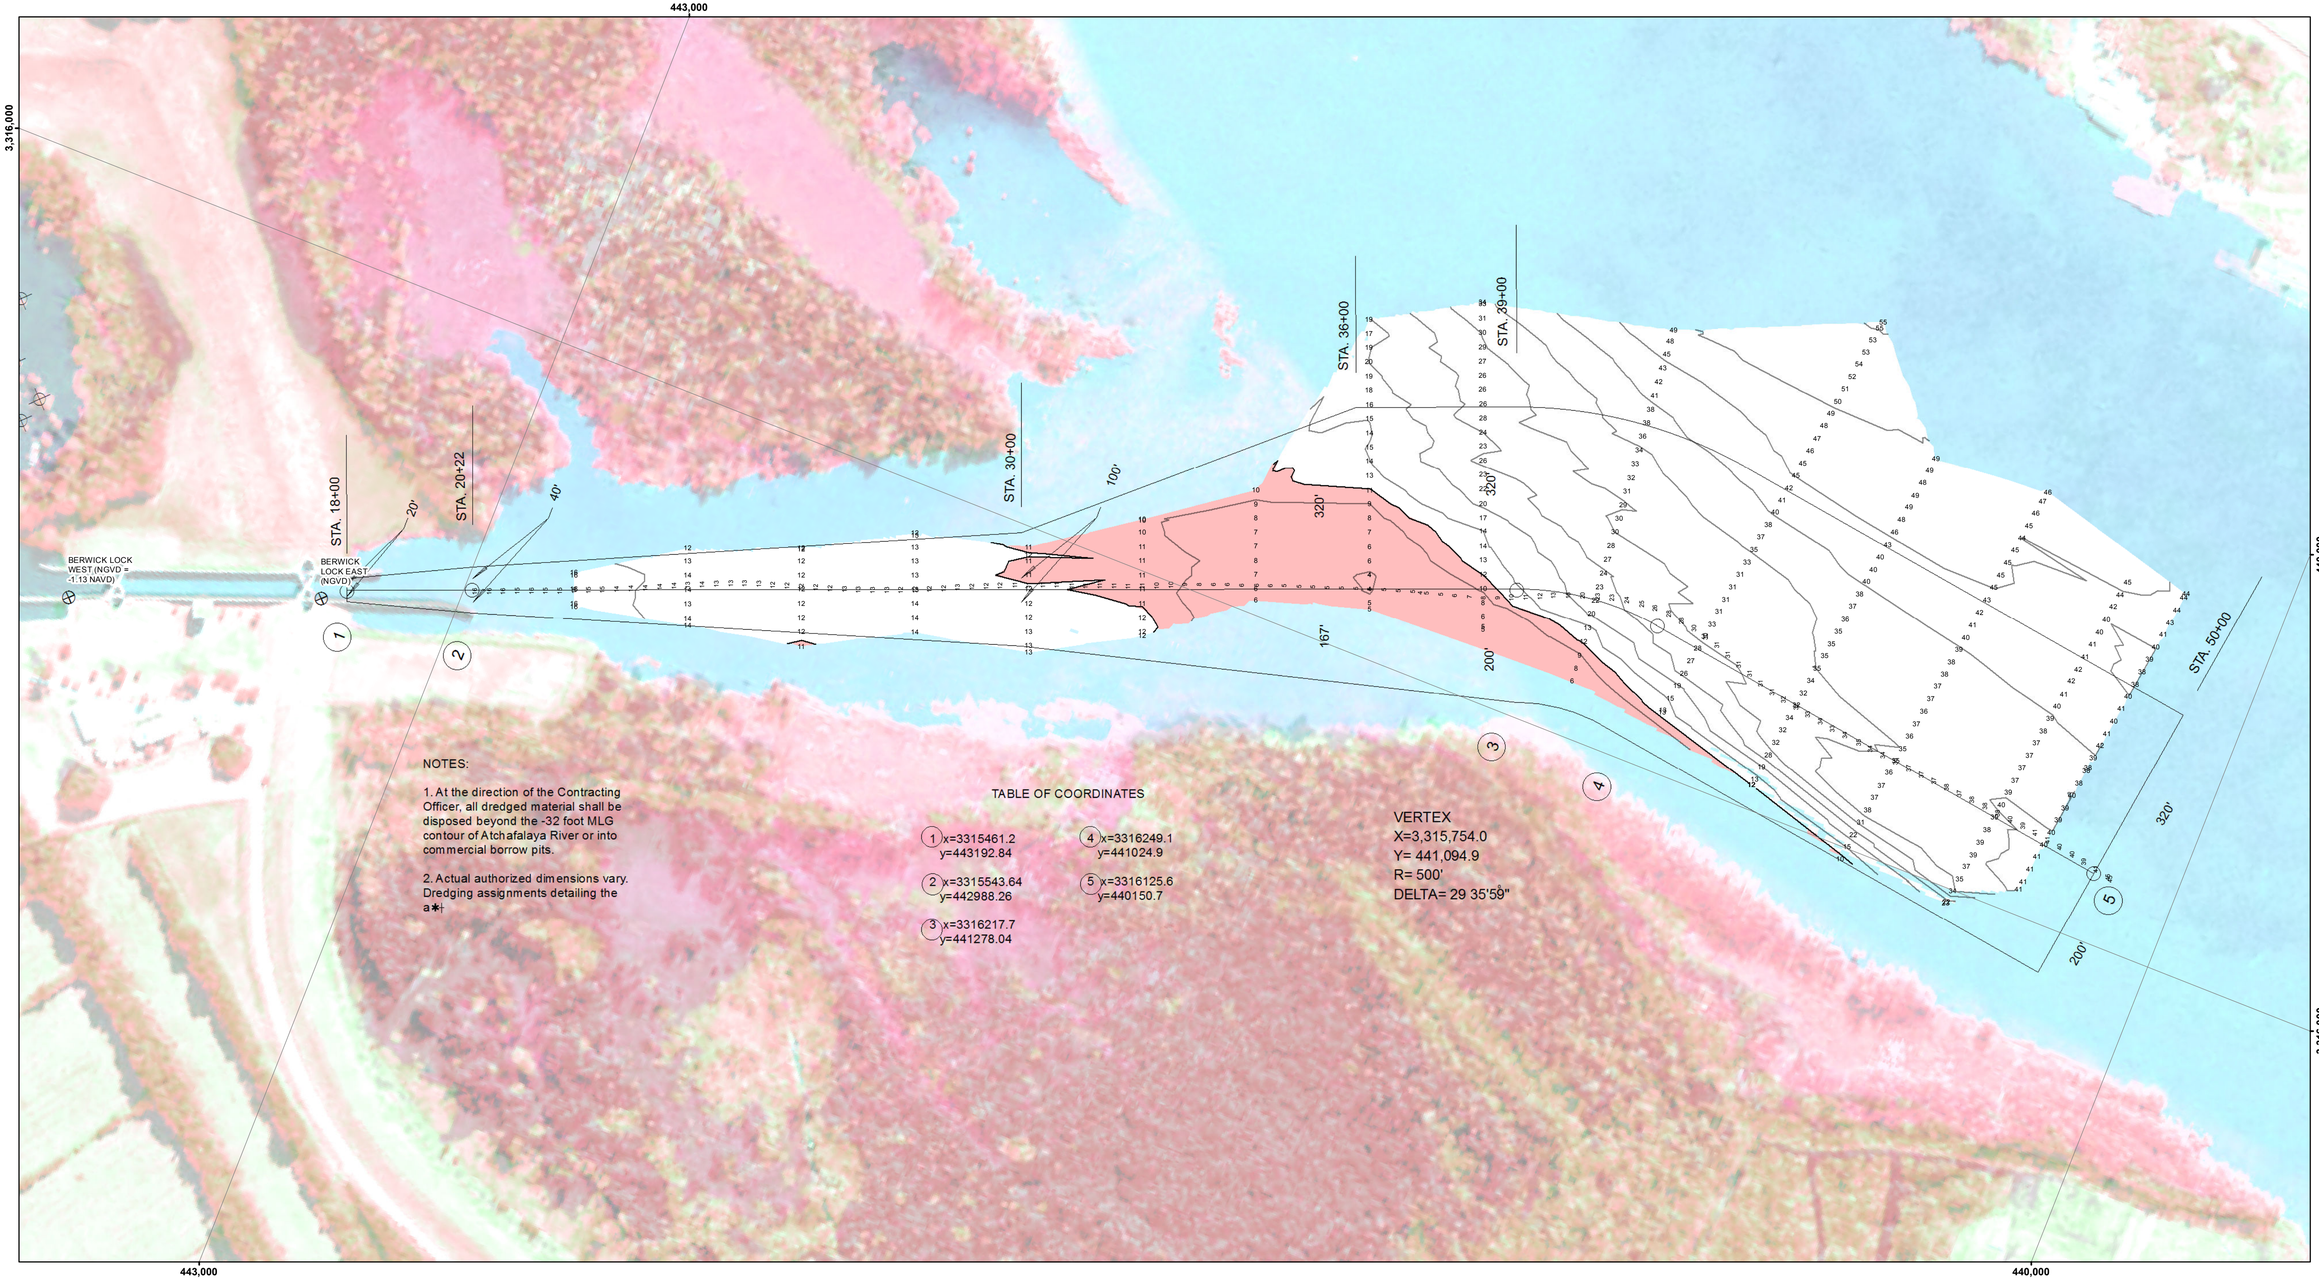

NOTES:

1. At the direction of the Contracting Officer, all dredged material shall be disposed beyond the -32 foot MLG contour of Atchafalaya River or into commercial borrow pits.

2. Actual authorized dimensions vary. Dredging assignments detailing the a*+

TABLE OF COORDINATES

1	x=3315461.2 y=443192.84	4	x=3316249.1 y=441024.9
2	x=3315543.64 y=442988.26	5	x=3316125.6 y=440150.7
3	x=3316217.7 y=441278.04		

VERTEX
X=3,315,754.0
Y= 441,094.9
R= 500'
DELTA= 29 35'59"

VICINITY MAP

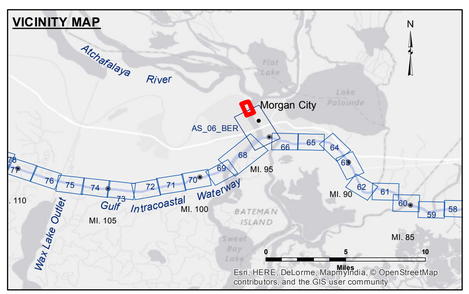

LEGEND

- Federal Navigation Channel
- Federal Navigation Center Line
- As-built Pipeline/Cable
- Unconfirmed Pipeline/Cable
- Project Depth Contour
- Cable Area
- Placement Area
- Anchorage Area
- Obstruction Point
- Wrecks-Submerged
- Borrow Area
- Shoalest Sounding**
- Beacon, General
- Red Navigation Buoy
- Green Navigation Buoy
- -12' and above
- -12' and below

Gage Reading:	MORGAN CITY 6.5 MLG
Sea Conditions:	CALM
Vessel Name:	M/V BURRWOOD
Survey Type:	CONDITION
Sounding Frequency***:	LOW

Feet
0 100 200 300 400 500

NOTES:
Horizontal Coordinate System:
North American Datum of 1983 (NAD83), projected to the State Plane Coordinate System (SPCS), Louisiana South Zone. Distance units in U.S. Survey Feet.

Vertical Datum:
Soundings are shown in feet and indicate depths below Mean Low Gulf Datum (MLG).
Datum Relationships for Lower Atchafalaya River at Morgan City (03780) as of May 2014:
0.0' NAVD88 (2009.55) = 2.05' MLG

The location of navigation aids are base on and provided by the U.S. Coast Guard.

2010 Aerial Photography data source: NAIP. 1998 DOQQ imagery shown in green from USGS.

Reference is N.O.A.A. Navigation Chart No. 11355.

** Shoalest Sounding per Quarter per Reach.

*** High frequency (200 kHz) survey data represents the first signal return at a sounding location and will include suspended solids, known as "fluff", if present. Low frequency (20 kHz) survey data normally penetrates through this "fluff" layer to depict elevations of consolidated bottom material. Low frequency accuracies may vary depending on channel conditions and fathometer settings.

US Army Corps of Engineers
District: CEMVN

Distribution Liability: The data represents the results of data collection by the US Army Corps of Engineers activity and indicates the general existing conditions. As such it is only valid for its intended use, context, time and accuracy of the application of the data for other than its intended purpose.

Data Constraints: Hydrographic survey data is subject to change due to natural shoaling and scouring processes. The U. S. Army Corps of Engineers accepts no responsibility for changes in the condition of the data after the date shown in this publication. This data is intended for U. S. Army Corps of Engineers' internal use. Private or commercial use may apply a fee.

DISCLAIMER:
Access Constraints: The United States Government furnishes this map and the information contained therein. The recipient understands that the US Government makes no warranties, express or implied, concerning the accuracy, completeness, reliability, or suitability of this map or any of its contents. This map is furnished on the condition that neither the United States nor any of its employees will be liable for any direct or indirect damage that may result from the use of this map or any of the information contained therein, regardless of whether any of the foregoing was caused in whole or part by the negligence of the United States or any of its employees. The recipient agrees to hold the United States harmless in the event of any lawsuit or other claim brought against the United States by any third party arising out of the recipient's use of this map. The United States does not guarantee that the map is free from errors, and it does not imply that it will function without interruption. The recipient may not assert any claim against the United States and its employees that alleges, in whole or in part, that the United States or any of its employees were negligent with respect to the preparation of this map. The United States shall be entitled to recover its reasonable attorney's fees and costs if any person by reason of any use made of this map by the recipient fully agrees not to represent these data to anyone as other than preliminary and subject to change. The recipient agrees to defend these data to others without also transferring this Disclaimer.

The information depicted on this map represents the results of a survey conducted on the date indicated and can only be considered to represent the general condition existing at that time.

U.S. ARMY CORPS OF ENGINEERS
NEW ORLEANS DISTRICT

Surveyed By: DR_JA	Submitted:		
Plotted By: AO	Recommended:	Chief, Survey Section	
Checked By: TC	Approved:	Chief, Waterways Maintenance Section	

ATCHAFALAYA RIVER
BERWICK LOCK FOREBAY
AS_00_BLF_20160414
14 April 2016

Sheet Reference Number
1 of 1

Revison Number:
3.8.0-20150202