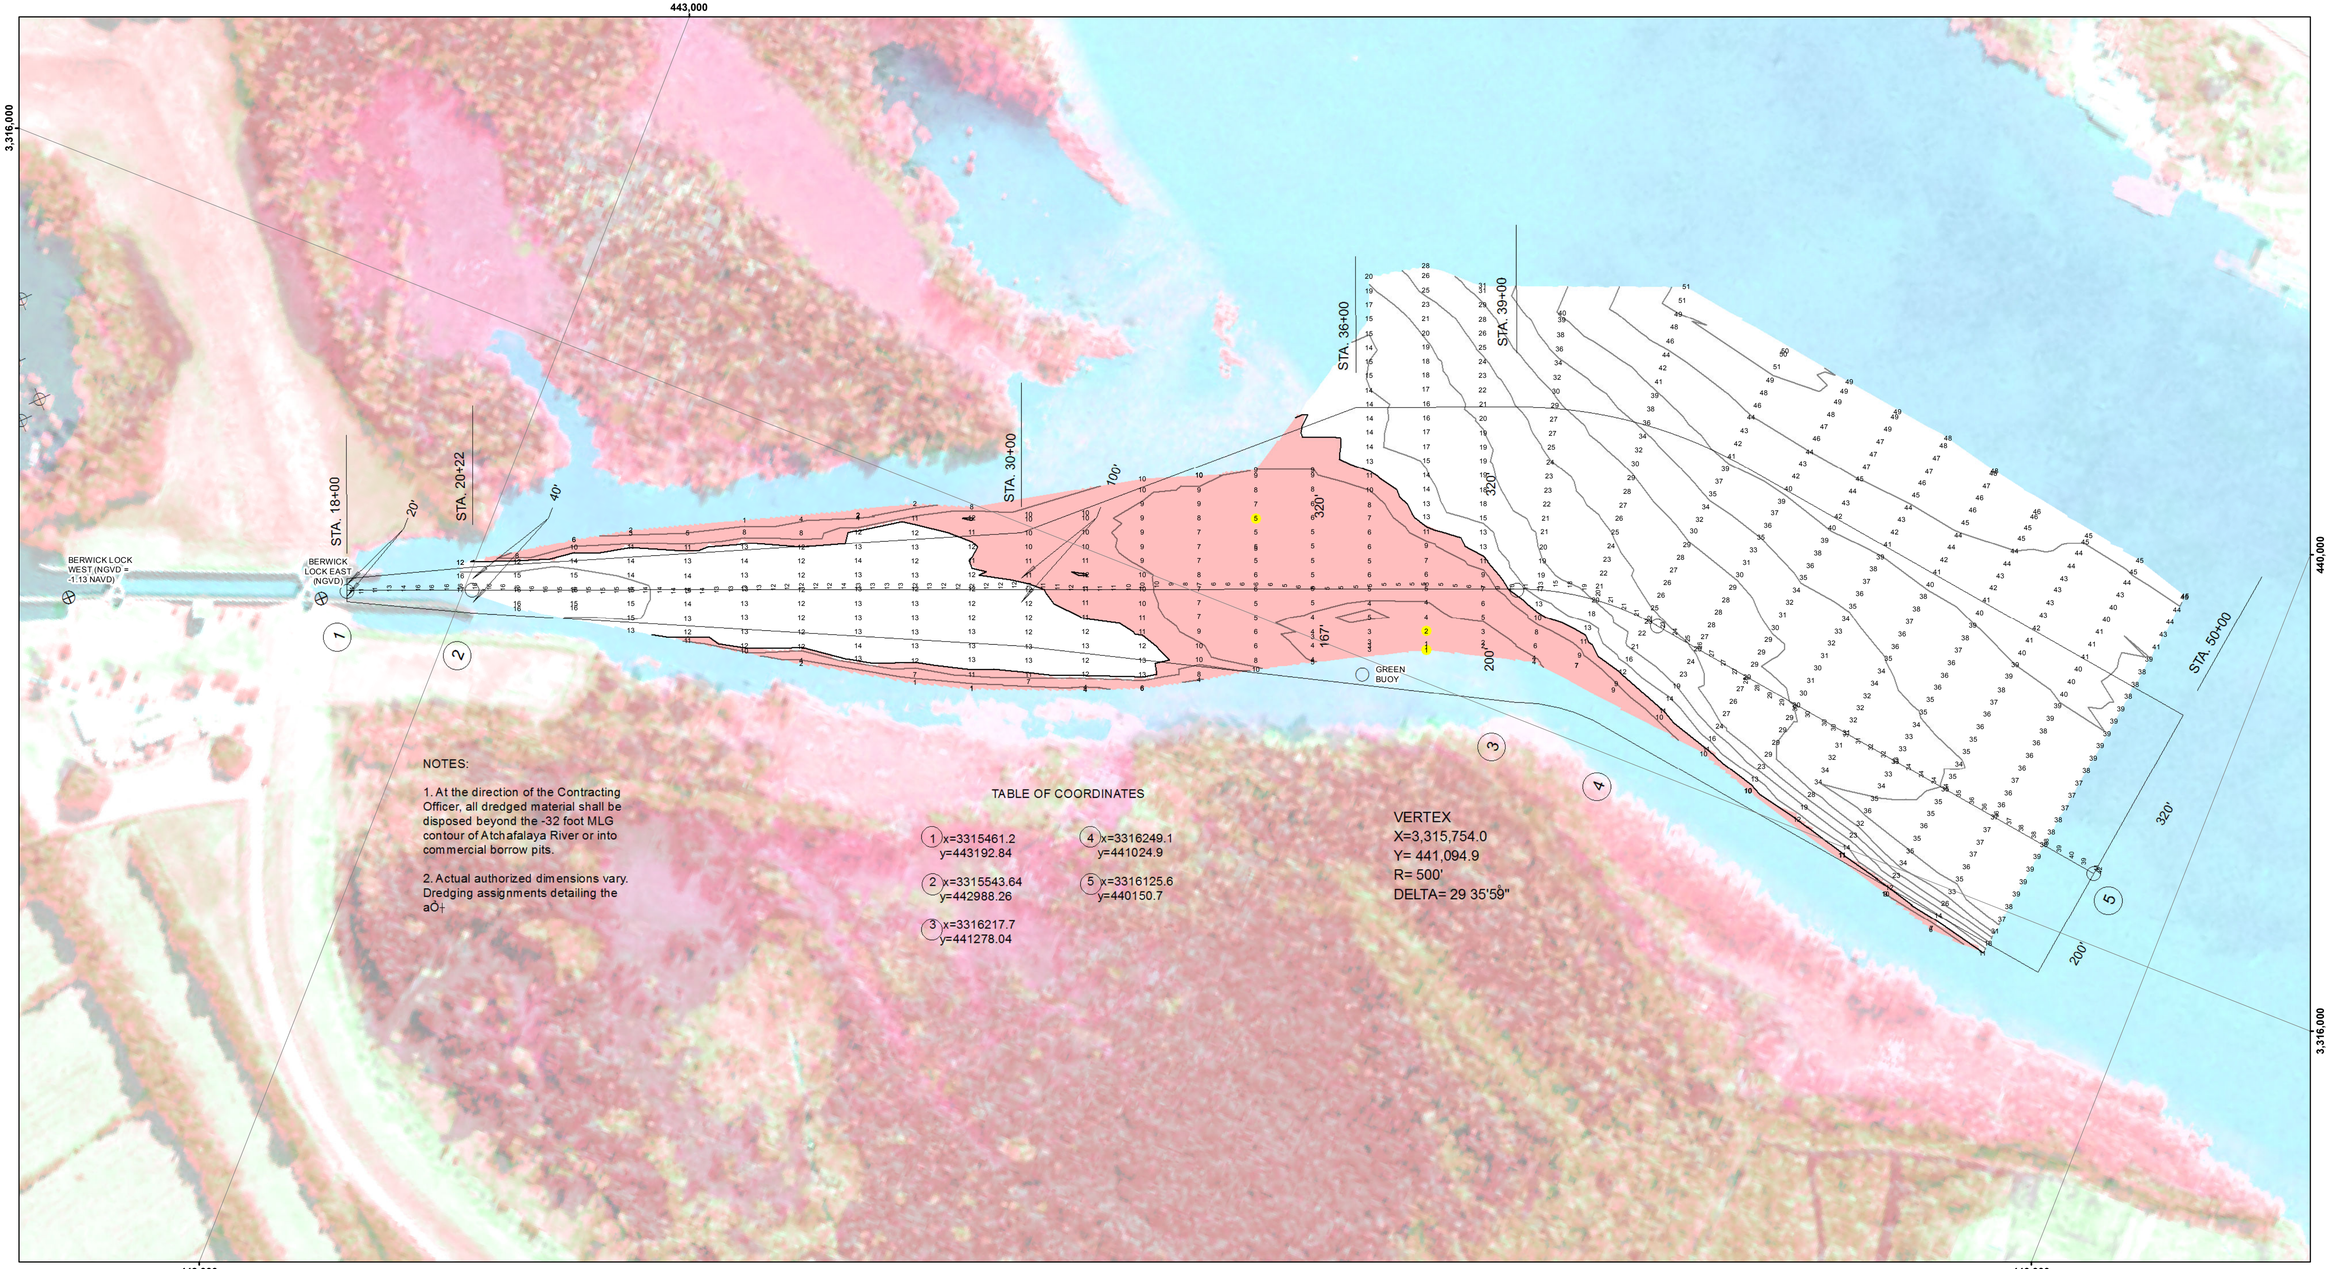

NOTES:

1. At the direction of the Contracting Officer, all dredged material shall be disposed beyond the -32 foot MLG contour of Atchafalaya River or into commercial borrow pits.

2. Actual authorized dimensions vary. Dredging assignments detailing the aÕ†

TABLE OF COORDINATES

1 x=3315461.2 y=443192.84	4 x=3316249.1 y=441024.9
2 x=3315543.64 y=442988.26	5 x=3316125.6 y=440150.7
3 x=3316217.7 y=441278.04	

VERTEX
X=3,315,754.0
Y= 441,094.9
R= 500'
DELTA= 29 35'59"

VICINITY MAP

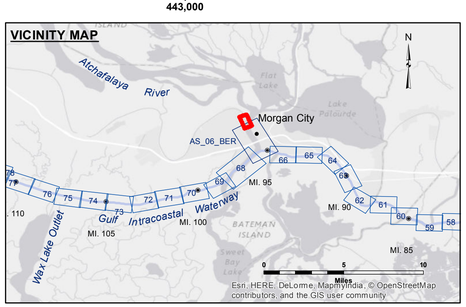

LEGEND

- Federal Navigation Channel
- Federal Navigation Center Line
- As-built Pipeline/Cable
- Unconfirmed Pipeline/Cable
- Project Depth Contour
- Cable Area
- Placement Area
- Anchorage Area
- Obstruction Point
- Wrecks-Submerged
- Borrow Area
- Shoalest Sounding**
- Beacon, General
- Red Navigation Buoy
- Green Navigation Buoy
- -12' and above
- -12' and below

Gage Reading:	MORGAN CITY: 3.3 MLG AVG
Sea Conditions:	CALM
Vessel Name:	M/V OB189
Survey Type:	CONDITION
Sounding Frequency***:	HIGH

Feet
0 100 200 300 400 500

NOTES:
Horizontal Coordinate System:
North American Datum of 1983 (NAD83), projected to the State Plane Coordinate System (SPCS), Louisiana South Zone. Distance units in U.S. Survey Feet.

Vertical Datum:
Soundings are shown in feet and indicate depths below Mean Low Gulf Datum (MLG).
Datum Relationships for Lower Atchafalaya River at Morgan City (03780) as of May 2014:
0.0' NAVD88 (2009.55) = 2.05' MLG

The location of navigation aids are base on and provided by the U.S. Coast Guard.

2010 Aerial Photography data source: NAIP. 1998 DOQQ imagery shown in green from USGS.

Reference is N.O.A.A. Navigation Chart No. 11355.

** Shoalest Sounding per Quarter per Reach.

*** High frequency (200 kHz) survey data represents the first signal return at a sounding location and will include suspended solids, known as "fluff", if present. Low frequency (20 kHz) survey data normally penetrates through this "fluff" layer to depict elevations of consolidated bottom material. Low frequency accuracies may vary depending on channel conditions and fathometer settings.

US Army Corps of Engineers
District: CEMVN

DISCLAIMER
Access Constraints: The United States Government furnishes these data and information as a service to the public. The express or implied warranties herein, including but not limited to those of fitness for a particular purpose and merchantability, are not extended to the data or information and the data furnished. The United States shall be under no liability whatsoever to any person by reason of any use made thereof. It is agreed that the recipient of these data and information and the recipient fully agrees not to represent these data to anyone as other than government data and information and to indemnify the United States of America from any and all claims arising from the use of these data by others without also transferring this Disclaimer.

The information depicted on this map represents the results of a survey conducted on the date indicated and can only be considered to represent the general condition existing at that time.

Distribution Liability: The data represents the results of data collection and analysis performed by the U.S. Army Corps of Engineers activity and indicates the general existing conditions. As such, it is only valid for its intended use, context, time and accuracy specified by the activity responsible for the data and not for any other purpose.

Data Constraints: Hydrographic survey data is subject to change due to dynamic conditions of the waterway and to errors in reporting activity and natural shoaling and scouring processes. The U. S. Army Corps of Engineers accepts no responsibility for changes in the waterway that occur after the survey has been completed and published. This data is intended for U. S. Army Corps of Engineers' internal use. Project managers should contact the survey section.

U.S. ARMY CORPS OF ENGINEERS
NEW ORLEANS DISTRICT

Submitted:	
Recommended: Chief, Survey Section	
Approved: Chief, Waterways Maintenance Section	
Surveyed By:	RY LAND/ADAMS
Plotted By:	AO
Checked By:	AO

ATCHAFALAYA RIVER
BERWICK LOCK FOREBAY
AS_00_BLF_20170310_CS
10 March 2017

Sheet Reference Number
1 of 1

Revison Number:
3.12-20160811