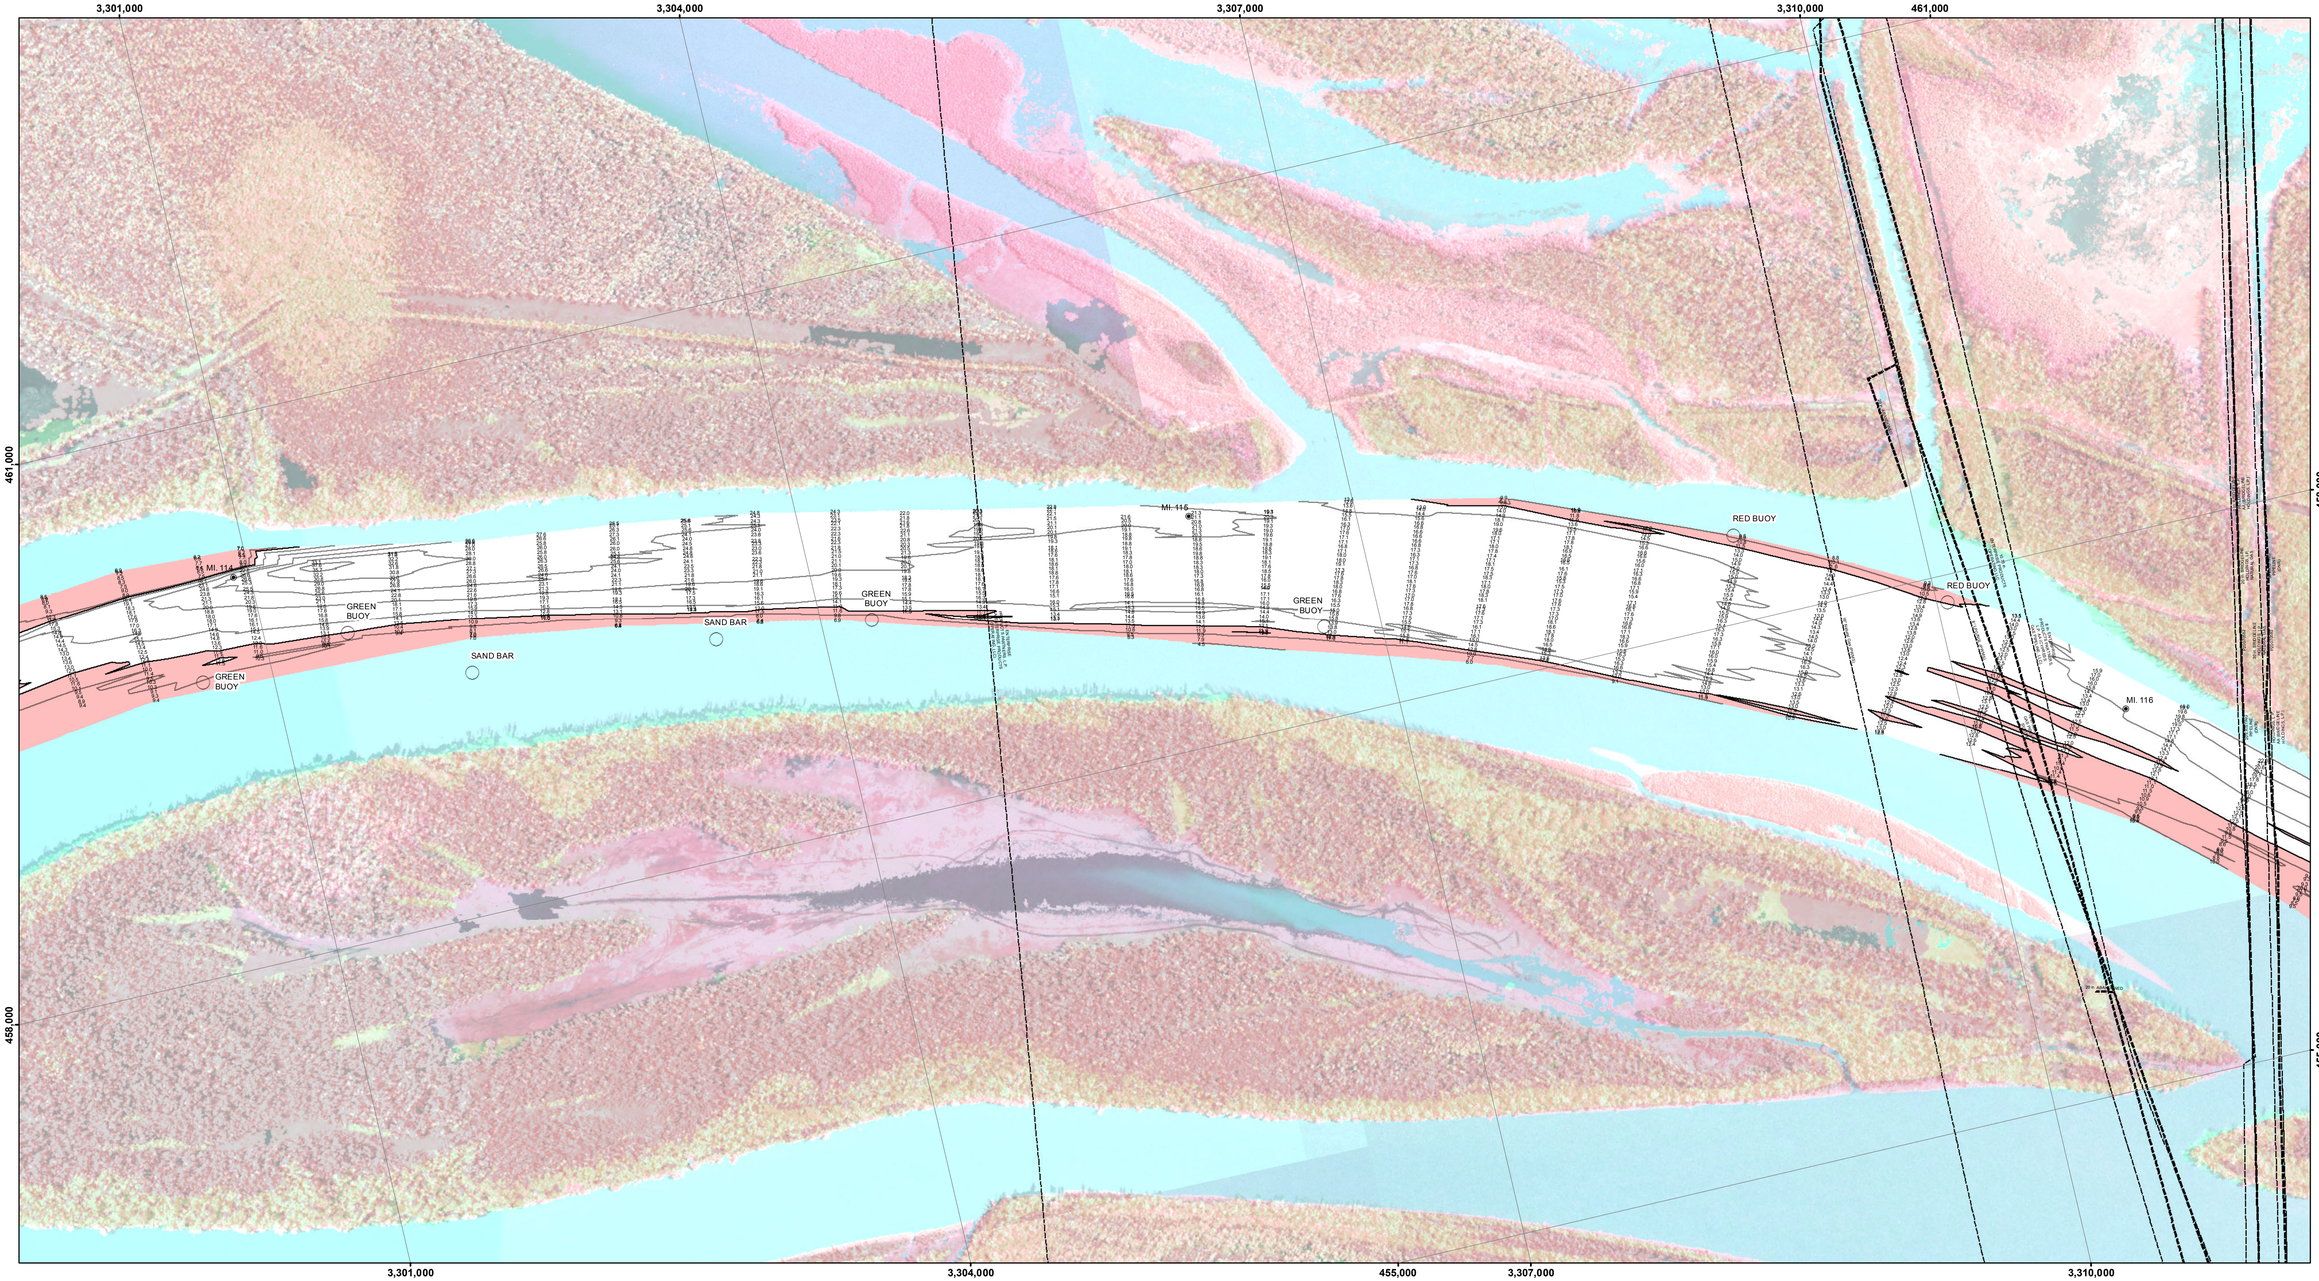

US Army Corps of Engineers
District: CEMVN

DISCLAIMER:

Access Constraints: The United States Government furnishes these data and information on an "as is" basis. The recipient agrees to assume all liability for the use of the information and the data furnished. The United States shall be under no liability whatsoever to any person by reason of any use made thereof. The United States Government does not warrant the accuracy, completeness, currentness, suitability, or validity of any information in these data and has no obligation to make any changes or updates to the data. In no event will the United States be liable for any damages, including lost profits, lost savings or other incidental or consequential damages arising out of the recipient's use of these data. The recipient agrees not to represent these data to anyone as other than data produced by the United States Government and to indemnify the United States from all claims arising from the recipient's representation of these data. Any attempt to assign its obligations to a third party does not relieve the recipient of its obligations under this agreement.

Distribution Liability: The data represents the results of data collection and analysis performed by the Corps of Engineers activity and indicates the general existing conditions. As such, it is only valid for its intended use, context, time and accuracy at the time of the survey. The Corps of Engineers accepts no liability for the misuse of any of the application of the data for other than its intended purpose.

Data Constraints: Hydrographic survey data is subject to change due to environmental conditions such as storms, shoaling activity and natural shoaling and scouring processes. The U. S. Army Corps of Engineers accepts no responsibility for changes in the condition of the channel that occur after the date shown in the publication. This data is intended for U. S. Army Corps of Engineers' internal use. Private businesses should not rely solely upon it.

The information depicted on this map represents the results of a survey conducted on the date indicated and can only be considered to represent the general condition existing at that time.

U.S. ARMY CORPS OF ENGINEERS
NEW ORLEANS DISTRICT

Surveyed By: SR_JH	Submitted:	
Plotted By: BTD	Recommended:	Chief, Survey Section
Checked By: ATO	Approved:	Chief, Waterways Maintenance Section

ATCHAFALAYA RIVER
STOUTS PASS
AS_09_STP_20160719
19 July 2016

Sheet Reference Number
9 **of** 66

Revison Number:
3.8.0-20150202

VICINITY MAP

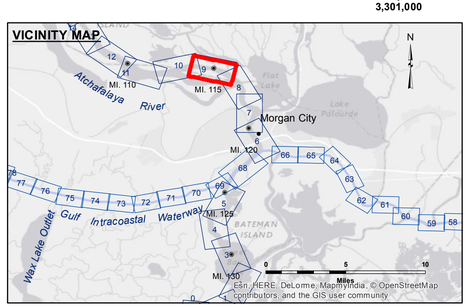

LEGEND

- Federal Navigation Channel
- Federal Navigation Center Line
- As-built Pipeline/Cable
- Unconfirmed Pipeline/Cable
- Project Depth Contour
- Cable Area
- Placement Area
- Anchorage Area
- Obstruction Point
- Wrecks-Submerged
- Borrow Area
- Shoalest Sounding**
- Beacon, General
- Red Navigation Buoy
- Green Navigation Buoy
- -12' and above
- -12' and below

N E S W

Gage Reading:	MYETTE PT.: 4.6 MLG
Sea Conditions:	CALM
Vessel Name:	M/V TECHE
Survey Type:	CONDITION
Sounding Frequency***:	LOW

Feet
0 500 1,000 1,500 2,000

NOTES:

Horizontal Coordinate System:
North American Datum of 1983 (NAD83), projected to the State Plane Coordinate System (SPCS), Louisiana South Zone. Distance units in U.S. Survey Feet.

Vertical Datum:
Soundings are shown in feet and indicate depths below Mean Low Gulf Datum (MLG).

The location of navigation aids are base on and provided by the U.S. Coast Guard.

2010 Aerial Photography data source: NAIP. 1998 DOQQ imagery shown in green from USGS.

Reference is N.O.A.A. Navigation Chart No. 11355.

** Shoalest Sounding per Quarter per Reach.

*** High frequency (200 kHz) survey data represents the first signal return at a sounding location and will include suspended solids, known as "fluff", if present. Low frequency (20 kHz) survey data normally penetrates through this "fluff" layer to depict elevations of consolidated bottom material. Low frequency accuracies may vary depending on channel conditions and fathometer settings.