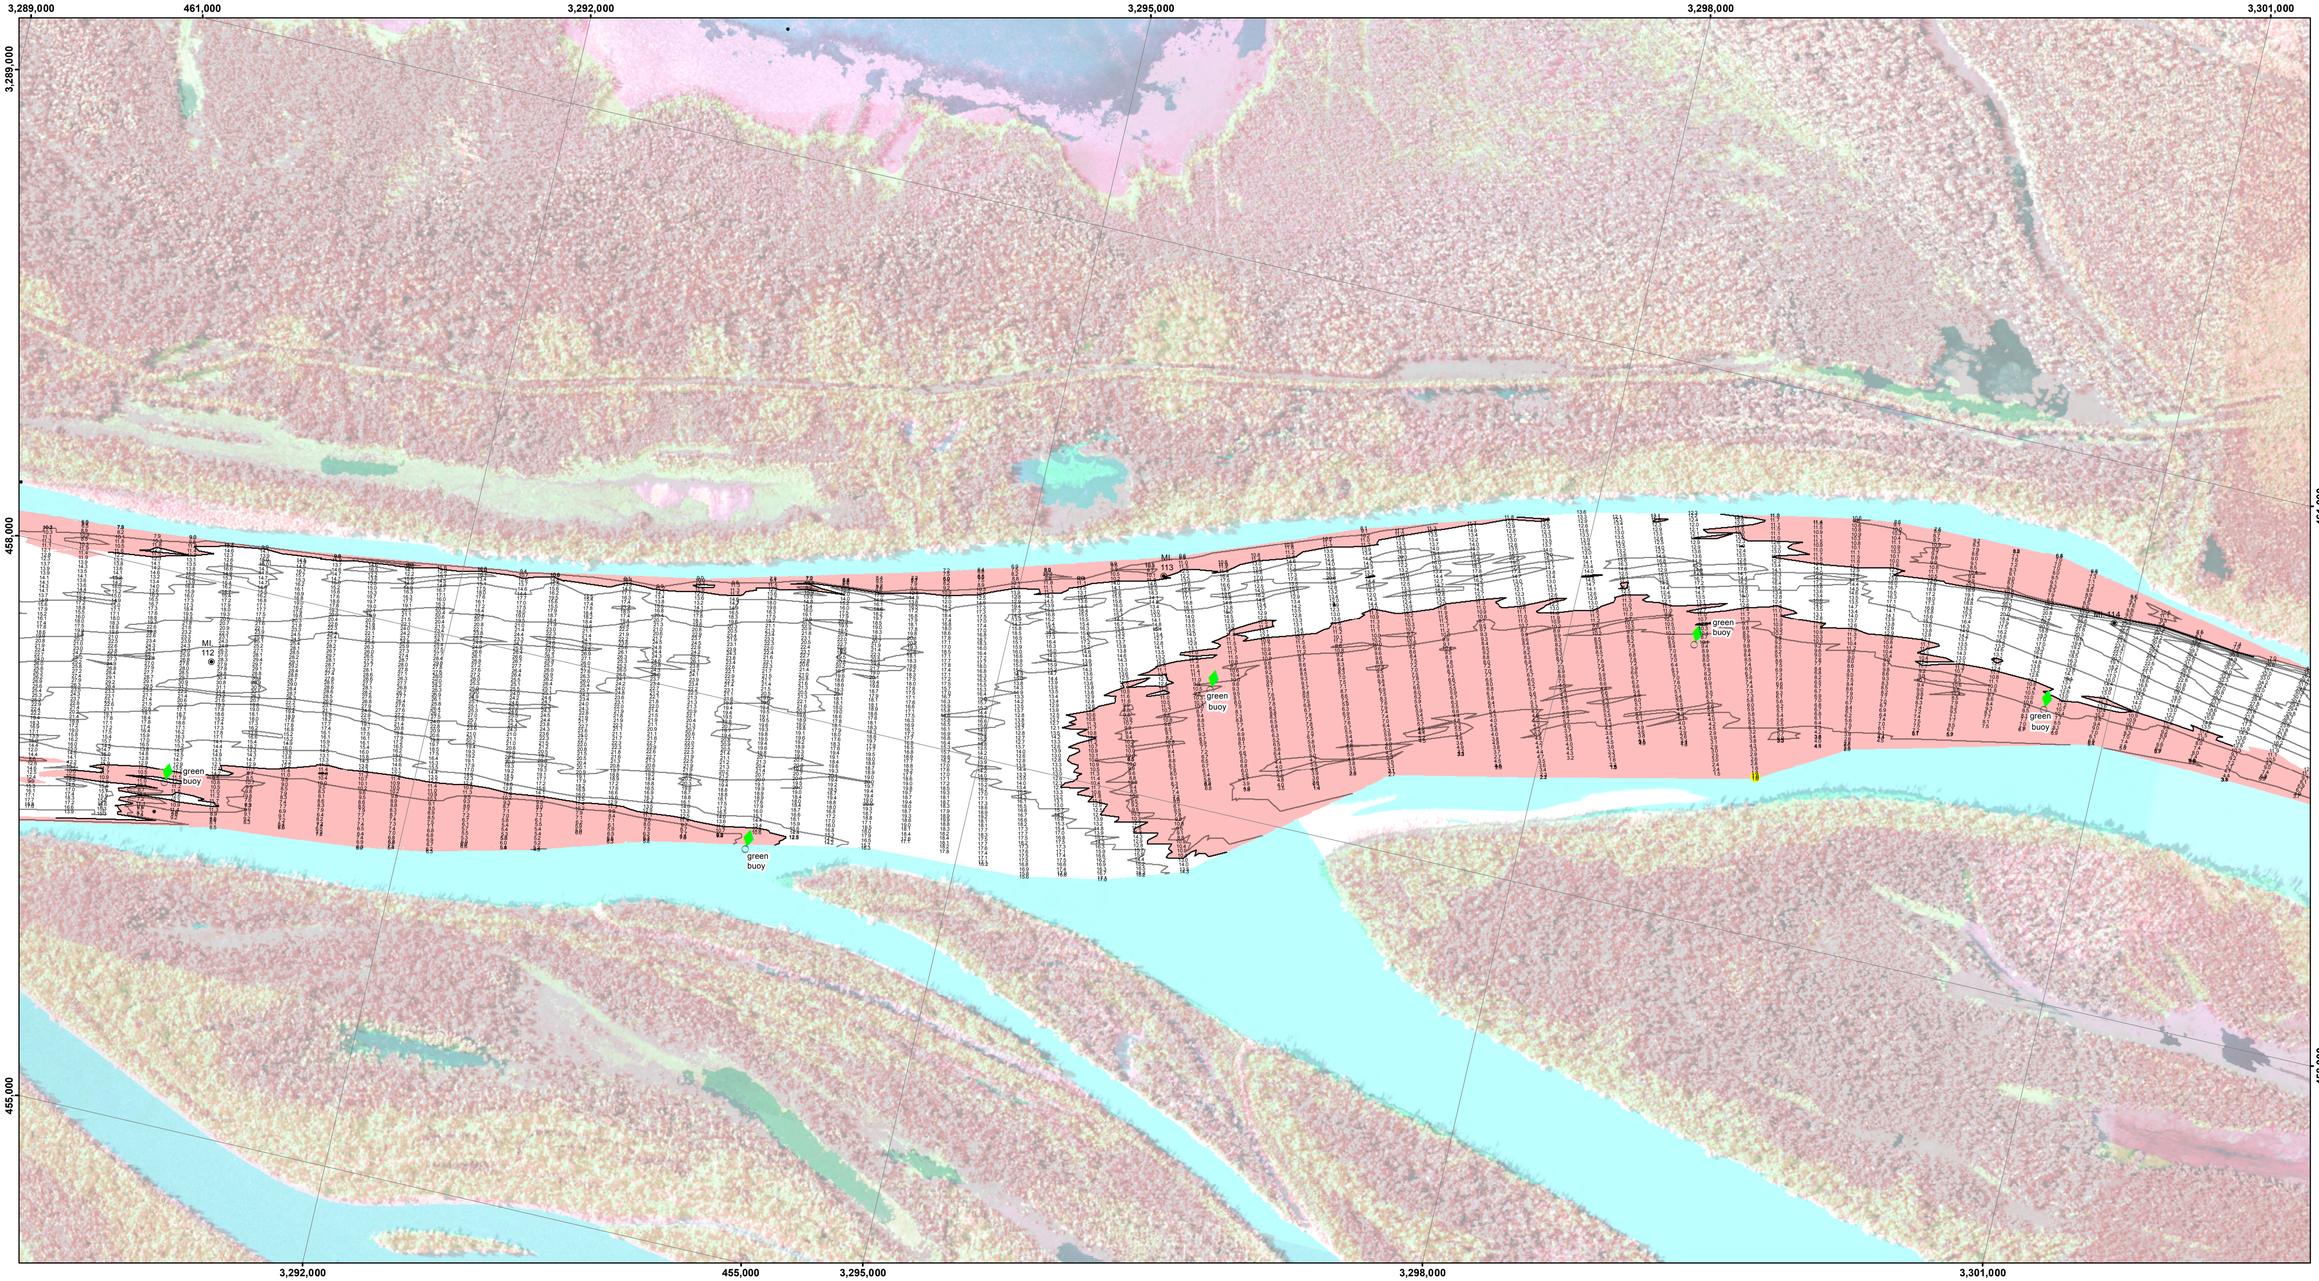

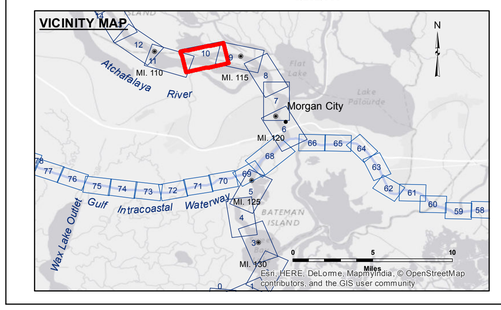

LEGEND

- Federal Navigation Channel
- Federal Navigation Center Line
- As-built Pipeline/Cable
- Unconfirmed Pipeline/Cable
- Project Depth Contour
- Cable Area
- Placement Area
- Anchorage Area
- Obstruction Point
- Wrecks-Submerged
- Borrow Area
- Shoalest Sounding**
- Beacon, General
- Red Navigation Buoy
- Green Navigation Buoy
- -12' and above
- -12' and below

Gage Reading:	CP:3.0 MC:2.5 USED: 2.6 MLG
Sea Conditions:	CALM
Vessel Name:	OB-167
Survey Type:	CONDITION
Sounding Frequency***:	LOW

Feet
0 500 1,000 1,500 2,000

NOTES:

Horizontal Coordinate System:
North American Datum of 1983 (NAD83), projected to the State Plane Coordinate System (SPCS), Louisiana South Zone. Distance units in U.S. Survey Feet.

Vertical Datum:
Soundings are shown in feet and indicate depths below Mean Low Gulf Datum (MLG).

The location of navigation aids are base on and provided by the U.S. Coast Guard.

2010 Aerial Photography data source: NAIP. 1998 DOQQ imagery shown in green from USGS.

Reference is N.O.A.A. Navigation Chart No. 11355.

** Shoalest Sounding per Quarter per Reach.

*** High frequency (200 kHz) survey data represents the first signal return at a sounding location and will include suspended solids, known as "fluff", if present. Low frequency (20 kHz) survey data normally penetrates through this "fluff" layer to depict elevations of consolidated bottom material. Low frequency accuracies may vary depending on channel conditions and fathometer settings.

US Army Corps of Engineers
District: CEMVN

DISCLAIMER:

Access Constraints: The United States Government furnishes these data and information on an "as is" basis. The user's use of the data or information, reliance on it, and expressed or implied concerning the accuracy, completeness, suitability, or usability of the data or information, and the information and the data furnished. The United States shall be under no liability whatsoever to any person by reason of any use made thereof. The United States Government does not warrant that the use of the data or information will not infringe any privately owned rights. By accepting these data or information, the recipient fully agrees not to represent these data to anyone as other than data furnished by the United States Government, nor to hold these data to others without also transferring this Disclaimer.

Distribution Liability: The data represents the results of data collection and analysis performed by the Corps of Engineers activity and indicates the general existing conditions. As such, it is only valid for its intended use, context, time and accuracy at the time of the survey. The Corps of Engineers accepts no liability of any of the application of the data for other than its intended purpose.

Data Constraints: Hydrographic survey data is subject to change due to environmental conditions such as storms, sedimentation activity, and natural shoaling and scouring processes. The U. S. Army Corps of Engineers accepts no responsibility for changes in the data that occur after the survey date shown in the publication. This data is intended for U. S. Army Corps of Engineers' internal use. It should not be used for any liability issue.

The information depicted on this map represents the results of a survey conducted on the date indicated and can only be considered to represent the general conditions existing at that time.

U.S. ARMY CORPS OF ENGINEERS
NEW ORLEANS DISTRICT

Surveyed By: SP_DS	Plotted By: AO	Checked By: AO	
Submitted:	Recommended: Chief, Survey Section	Approved: Chief, Waterways Maintenance Section	

ATCHAFALAYA RIVER
STOUTS PASS TO MYETTE PT
AS_10_S2M_20161215
15 December 2016

Sheet Reference Number
10 of 66

Revison Number:
3.8.0-20150202