518,000 515,000 512,000 2,644,000 2,641,000

DISPOSAL AREA "F"

DISPOSAL AREA "C"

STA. 5+22.00 AZ. 94°33'57.6

LIGHT 68

LIGHT 67

9

LL=41.7 MLLW
LL=43.7 MLLW
LL=39.7 MLLW
LL=39.7 MLLW
LL=42.7 MLLW
LL=39.7 MLLW

CALCASIEU SHIP CHANNEL

CAMERON PARISH

DISPOSAL AREA 9

Sheet 19

Sheet 21

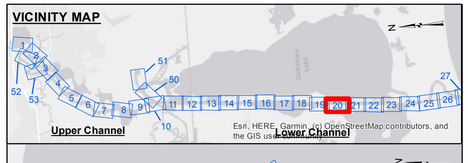

LEGEND

- Federal Navigation Channel
- Federal Navigation Center Line
- As-built Pipeline/Cable
- Unconfirmed Pipeline/Cable
- Project Depth Contour
- Cable Area
- Placement Area
- Anchorage Area
- Obstruction Point
- Wrecks-Submerged
- 3 Fluff Thickness (feet)*
- Shoalest Sounding**
- Beacon, General
- Red Navigation Buoy
- Green Navigation Buoy
- -16' and above
- -16' to -21'
- -21' to -26'
- -26' to -33'
- -33' to -39'
- -39' to -41'
- -41' to -43'
- -43' and below

Gage Reading: DM 72: 2.3 MLLW
Sea Conditions: 1'
Vessel Name: M/V VALENTOUR
Survey Type: CONDITION
Sounding Frequency***: LOW

Feet
0 400 800 1,200 1,600

NOTES:
Horizontal Coordinate System:
North American Datum of 1983 (NAD83), projected to the State Plane Coordinate System (SPCS), Louisiana South Zone. Distance units in U.S. Survey Feet.

Vertical Datum:
Soundings are shown in feet and indicate depths below Mean Lower Low Water Datum (MLLW).
Datum Relationships for gage 73615 as of December 2013:
0.0' NAVD88 (2009.55) = 1.1' MLLW = 2.1' MLG or 0.0' MLLW = 1.0' MLG

Distances on the Calcasieu River are shown at 1 mile intervals.

The location of navigation aids are base on and provided by the U.S. Coast Guard and USACE survey crews.

2015 Aerial Photography data source: NAIP

Reference is N.O.A.A. Navigation Chart No. 11339.

* Difference between high and low frequency elevations where greater than 1.0'.

** Shoalest Sounding per Quarter per Reach.

*** High frequency (200 kHz) survey data represents the first signal return at a sounding location and will include suspended solids, known as "fluff", if present. Low frequency (20 kHz) survey data normally penetrates through this "fluff" layer to depict elevations of consolidated bottom material. Low frequency accuracies may vary depending on channel conditions and fathometer settings.

US Army Corps of Engineers
District: CEMVN

DISCLAIMER
Access Constraints: The United States Government furnishes this map "as is" and makes no warranty, express or implied concerning the accuracy, completeness, reliability, or suitability of information portrayed in this information and the data furnished. The United States shall be under no liability for any deficiencies, inaccuracies or errors made thereof. These data belong to the Government. Therefore the recipient fully agrees not to represent these data to anyone as other than Government data. The recipient agrees to indemnify and save the United States harmless from all claims and liability that may arise from future use of these data by others without also transferring this Disclaimer.

Distribution Liability: The data represents the results of data collection and processing efforts at a point in time. Conditions change over time due to natural and human influences. The data is only valid for its intended use, content, time and accuracy of the application of the data for other than its intended purpose.

Data Constraints: Hydrographic survey data is subject to change due to natural and human influences. Natural processes such as shoaling activity and natural abrasion and scouring processes. The U. S. Government furnishes this information "as is" and makes no warranty as to the hydrographical conditions which develop after the date of publication. This data is intended for U. S. Army Corps of Engineers' internal use. Project maintained based on survey specs.

U.S. ARMY COPRPS OF ENGINEERS
NEW ORLEANS DISTRICT

Surveyed By: JDHADAMS
Plotted By: BD
Checked By: AO

Submitted:
Recommended: Chief, Survey Section
Approved: Chief, Waterways Maintenance Section

CALCASIEU SHIP CHANNEL
LOWER SHEET 20
CR_20_LWR_20200615_CS_POSTSTORM
15 June 2020

Sheet Reference Number
20 **of** 53

Revison Number:
4.1-20191105