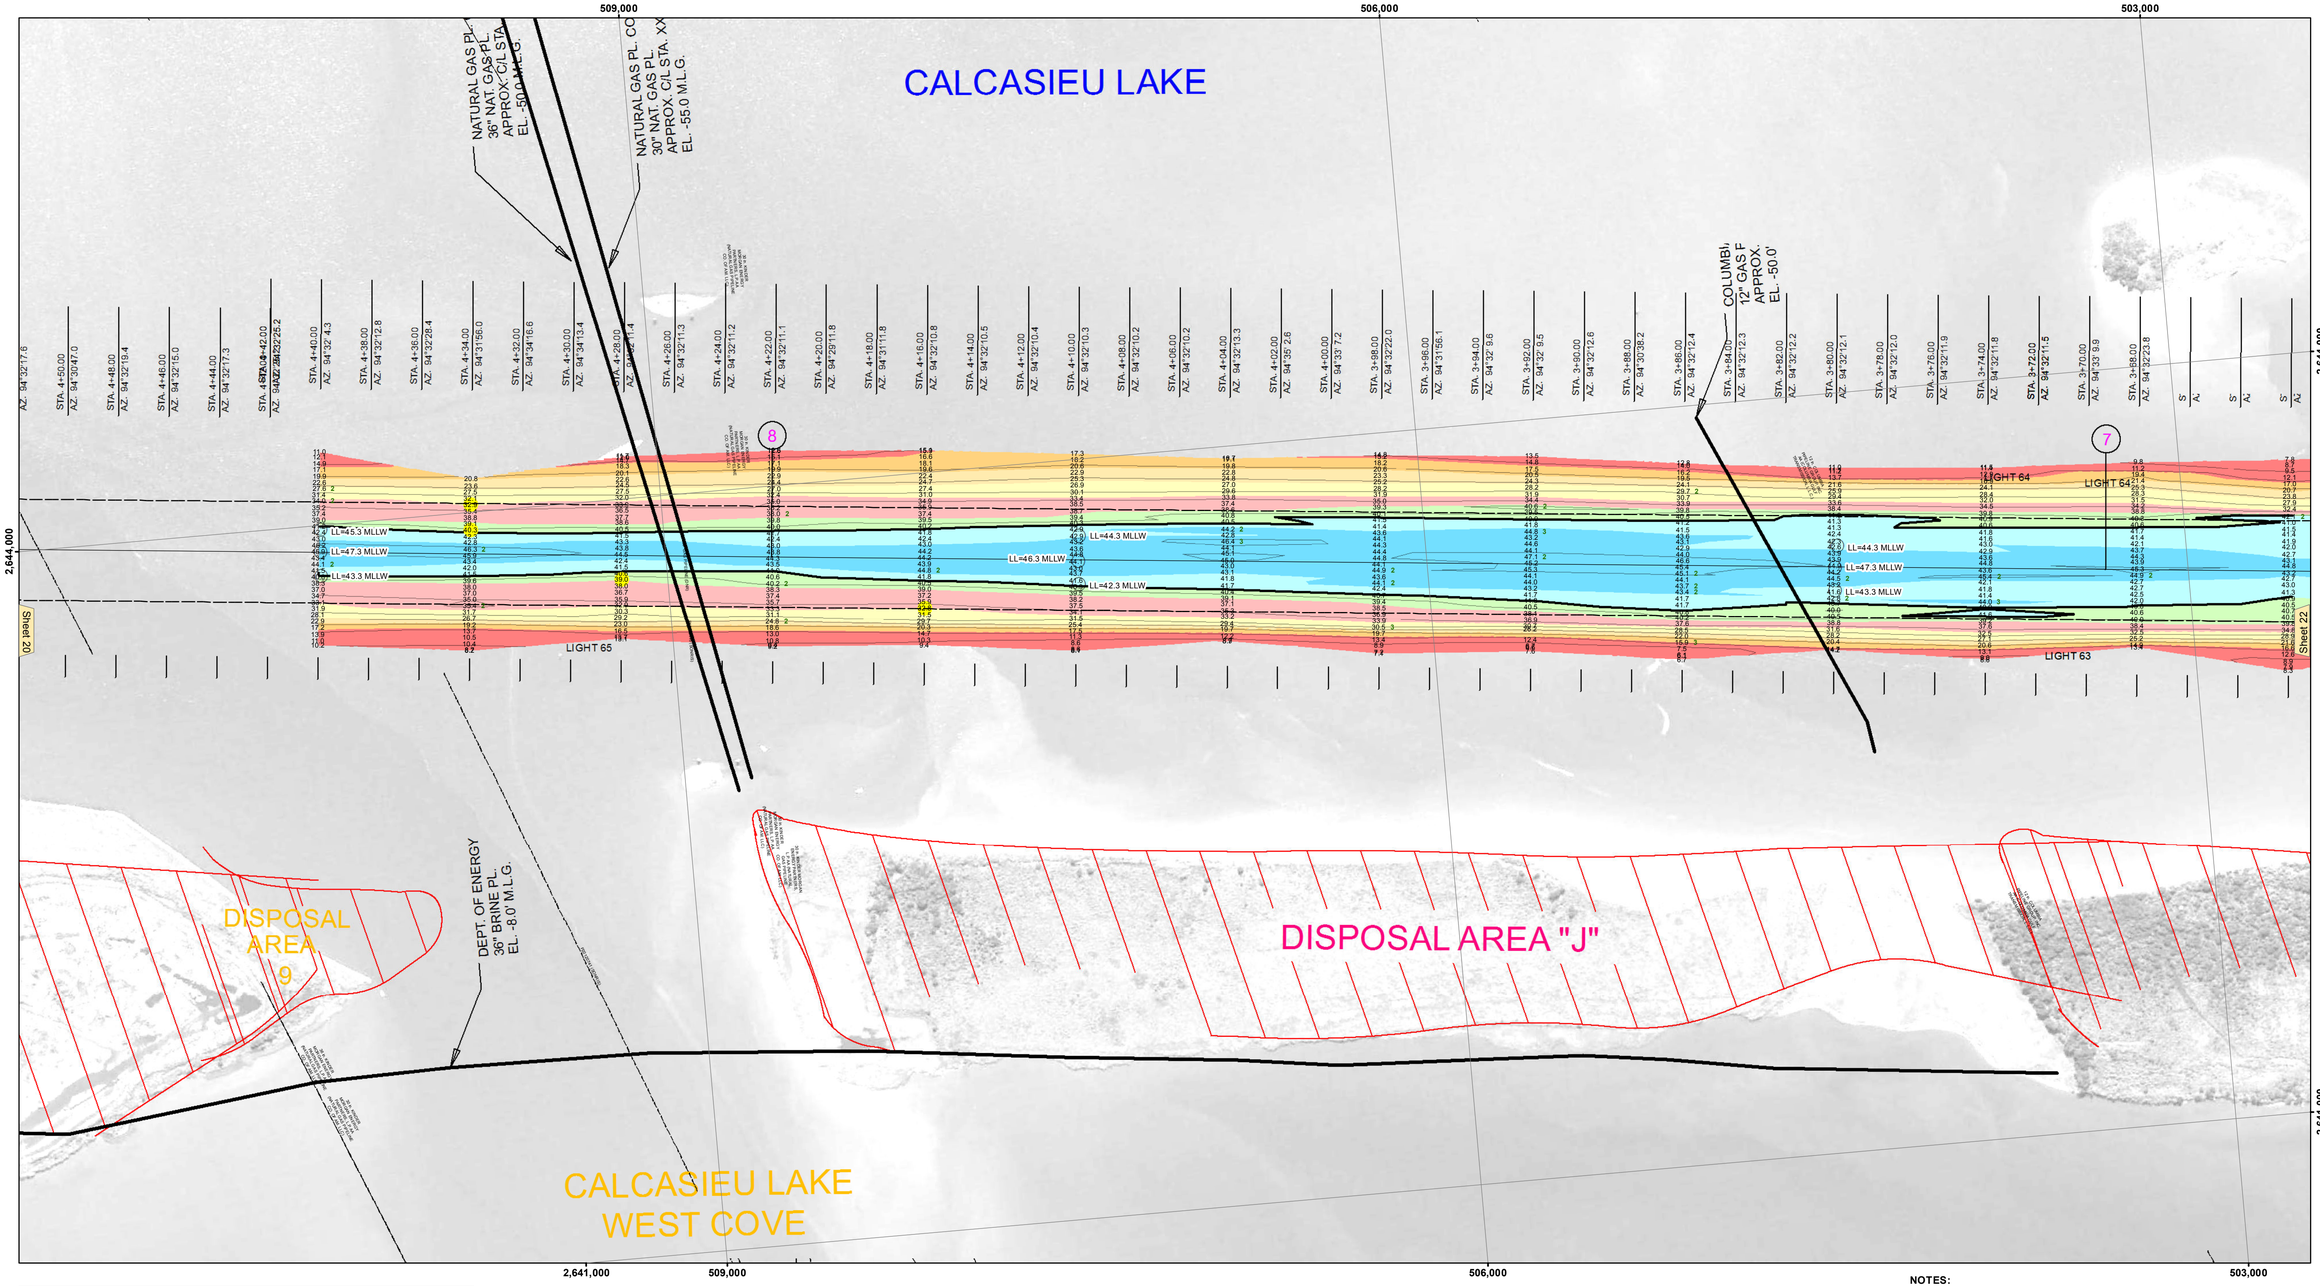

VICINITY MAP

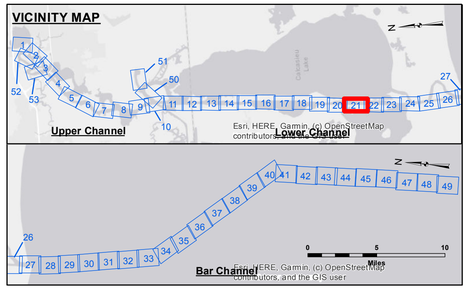

LEGEND

- Federal Navigation Channel
- Federal Navigation Center Line
- As-built Pipeline/Cable
- Unconfirmed Pipeline/Cable
- Project Depth Contour
- Cable Area
- Placement Area
- Anchorage Area
- Obstruction Point
- Wrecks-Submerged
- 3 Fluff Thickness (feet)*
- Shoalest Sounding**
- Beacon, General
- Red Navigation Buoy
- Green Navigation Buoy
- -16' and above
- -16' to -21'
- -21' to -26'
- -26' to -33'
- -33' to -39'
- -39' to -41'
- -41' to -43'
- -43' and below

Gage Reading:	DM 57 VRS RTK NTRIP: 0.69 MLLW AVG
Sea Conditions:	CHOPPY
Vessel Name:	OB-167
Survey Type:	CONDITION
Sounding Frequency***:	LOW

Feet
0 400 800 1,200 1,600

NOTES:

Horizontal Coordinate System:
North American Datum of 1983 (NAD83), projected to the State Plane Coordinate System (SPCS), Louisiana South Zone. Distance units in U.S. Survey Feet.

Vertical Datum:
Soundings are shown in feet and indicate depths below Mean Lower Low Water Datum (MLLW). Datum Relationships for gage 73625 as of December 2013:
0.0' NAVD88 (2009.55) = 1.2' MLLW = 2.2' MLG or 0.0' MLLW = 1.0' MLG

Distances on the Calcasieu River are shown at 1 mile intervals.

The location of navigation aids are base on and provided by the U.S. Coast Guard and USACE survey crews.

2015 Aerial Photography data source: NAIP

Reference is N.O.A.A. Navigation Chart No. 11339.

* Difference between high and low frequency elevations where greater than 1.0'.

** Shoalest Sounding per Quarter per Reach.

*** High frequency (200 kHz) survey data represents the first signal return at a sounding location and will include suspended solids, known as "fluff", if present. Low frequency (20 kHz) survey data normally penetrates through this "fluff" layer to depict elevations of consolidated bottom material. Low frequency accuracies may vary depending on channel conditions and fathometer settings.

US Army Corps of Engineers
District: CEMVN

DISCLAIMER
Access Constraints: The United States Government furnishes this map "as is" without warranty of any kind, either expressed or implied concerning the accuracy, completeness, timeliness, or rights to use such information. The use of this information and the data furnished. The United States shall in no event be liable for any damages resulting from the use of or reliance upon the information or data made thereof. These data belong to the Government. Therefore the recipient fully agrees not to represent these data to anyone as other than Government data and to indemnify the Government from any claim resulting from the use of these data to others without also transferring this Disclaimer.

Distribution Liability: The data represents the results of data collection and processing efforts at a point in time and may become inaccurate or obsolete as conditions change. The U. S. Government assumes no responsibility to distribute information on changes in the hydrographic conditions which develop after the date of publication. This data is intended for U. S. Army Corps of Engineers internal use. Private commercial distribution is strictly prohibited.

Data Constraints: Hydrographic survey data is subject to change due to environmental conditions such as storms, ongoing shoaling activity, and natural shoaling and scouring processes. The U. S. Government assumes no responsibility to distribute information on changes in the hydrographic conditions which develop after the date of publication. This data is intended for U. S. Army Corps of Engineers internal use. Private commercial distribution is strictly prohibited.

U.S. ARMY CORPS OF ENGINEERS
NEW ORLEANS DISTRICT

Surveyed By: SP,PM	Submitted:	
Plotted By: BD	Recommended: Chief, Survey Section	
Checked By: AO	Approved: Chief, Waterways Maintenance Section	

CALCASIEU SHIP CHANNEL
LOWER SHEET 21
CR_21_LWR_20210211_CS
11 February 2021

Sheet Reference Number
21 of 53

Revison Number:
4.1-20191105