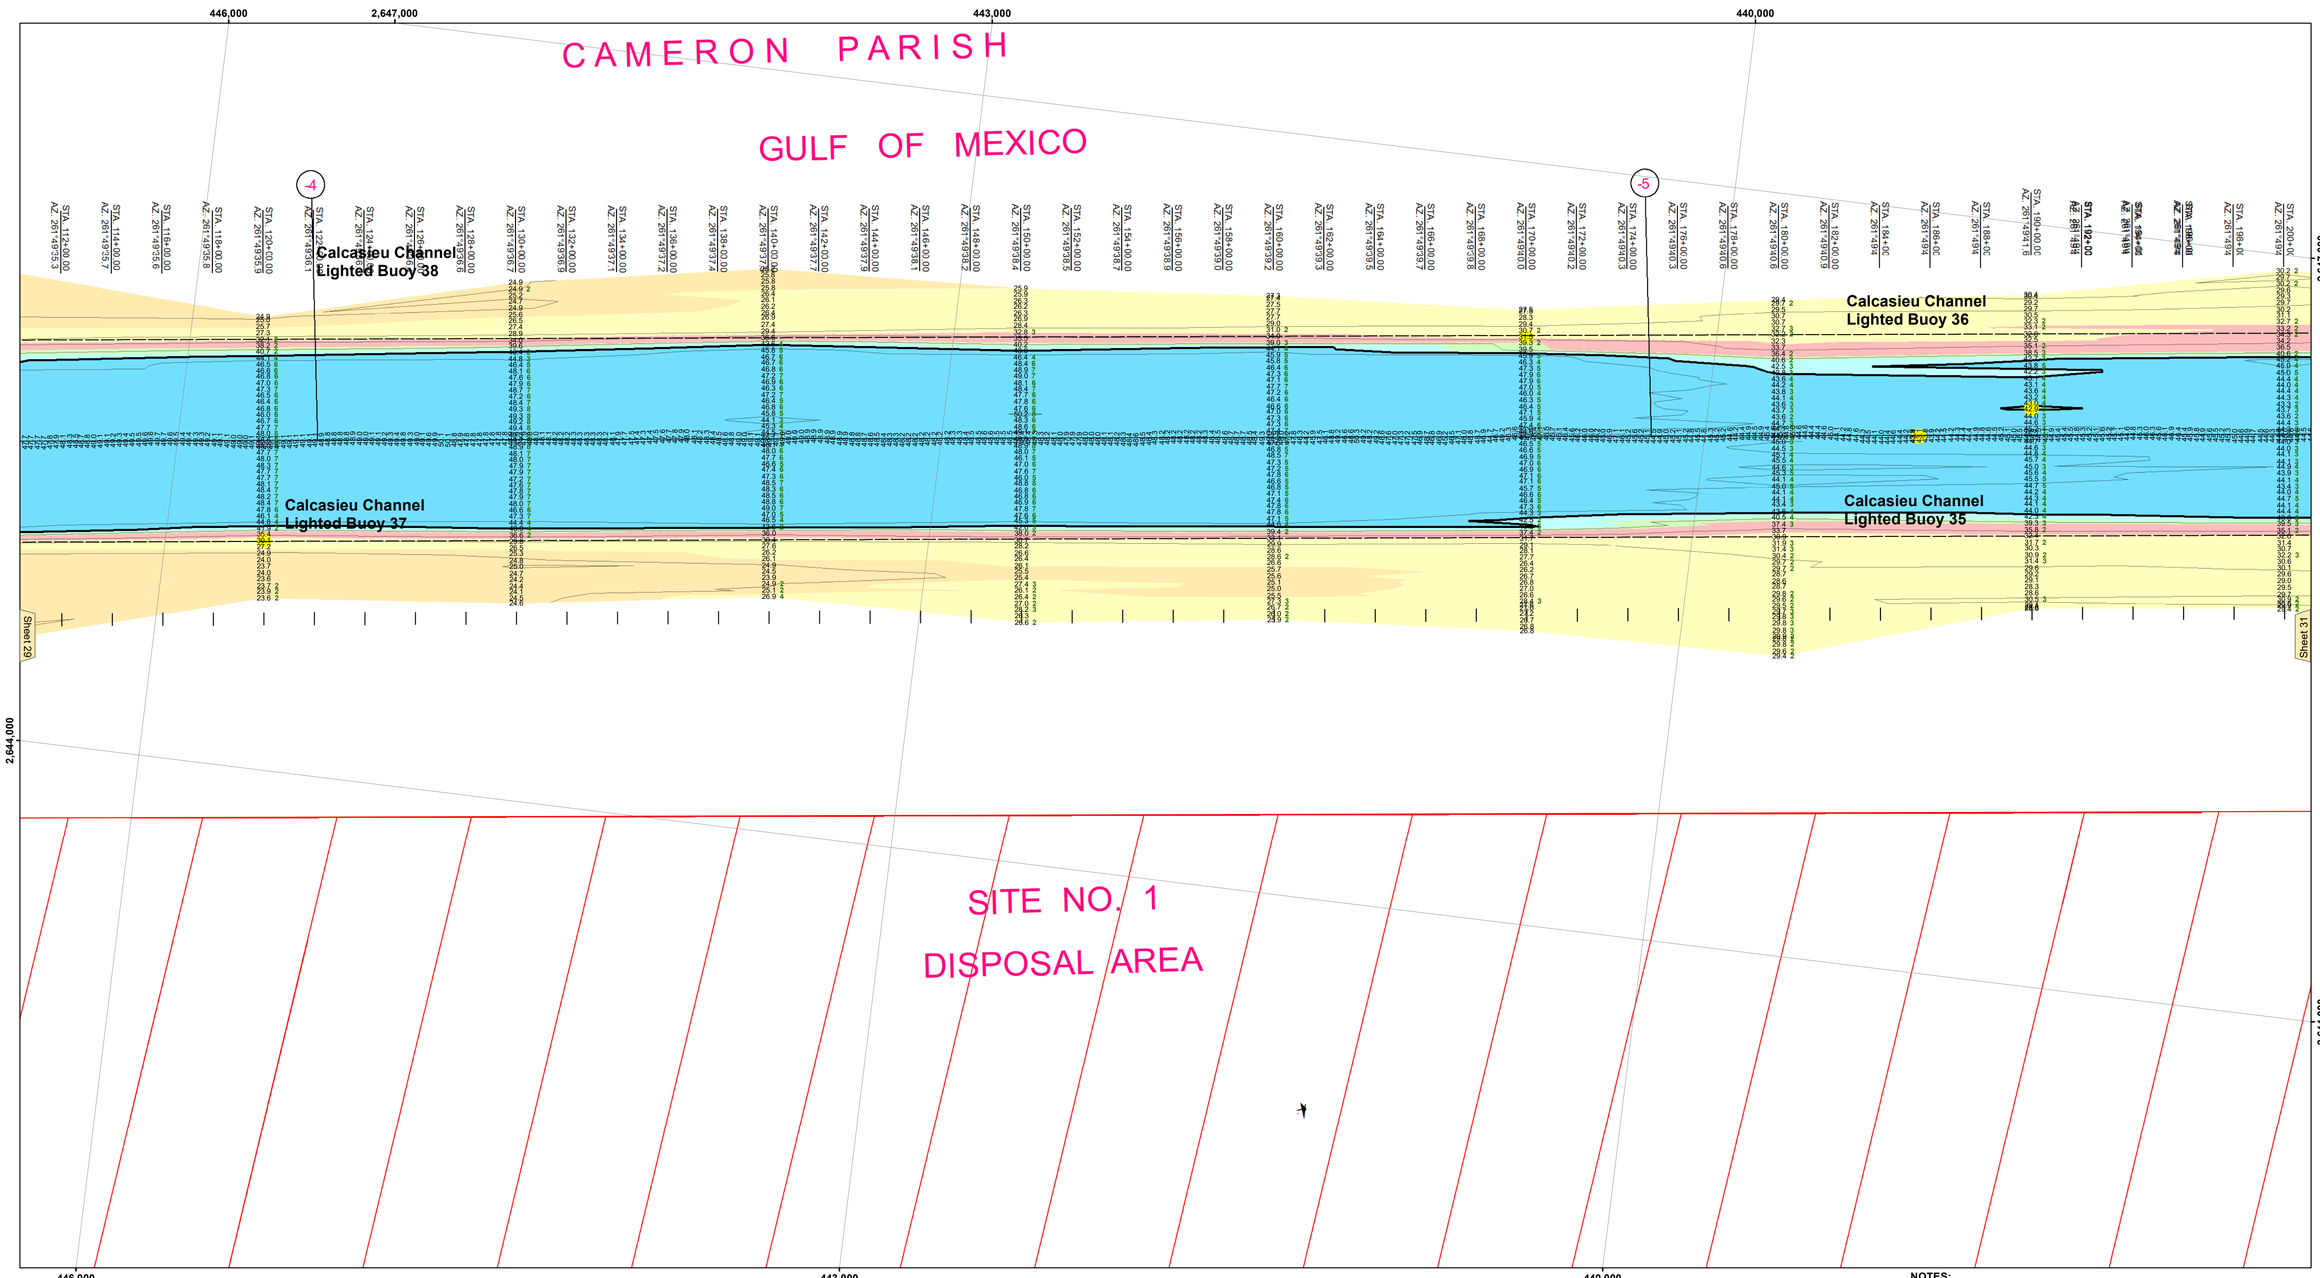

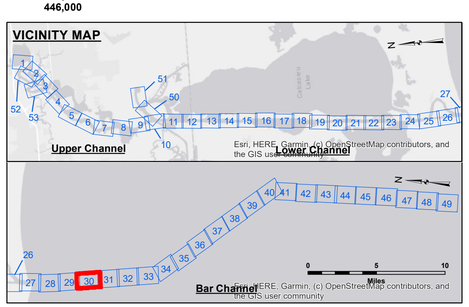

LEGEND

- Federal Navigation Channel
- Federal Navigation Center Line
- As-built Pipeline/Cable
- Unconfirmed Pipeline/Cable
- Project Depth Contour
- Cable Area
- Placement Area
- Anchorage Area
- Obstruction Point
- Wrecks-Submerged
- 3 Fluff Thickness (feet)*
- Shoalest Sounding**
- Beacon, General
- Red Navigation Buoy
- Green Navigation Buoy
- -16' and above
- -16' to -21'
- -21' to -26'
- -26' to -33'
- -33' to -39'
- -39' to -41'
- -41' to -43'
- -43' and below

Gage Reading:	CAMERON VRN: 0.4 MLLW AVG
Sea Conditions:	CALM
Vessel Name:	MV TECHE
Survey Type:	CONDITION
Sounding Frequency***:	LOW

Feet: 0 400 800 1,200 1,600

NOTES:
Horizontal Coordinate System:
North American Datum of 1983 (NAD83), projected to the State Plane Coordinate System (SPCS), Louisiana South Zone. Distance units in U.S. Survey Feet.

Vertical Datum:
Soundings are shown in feet and indicate depths below Mean Lower Low Water Datum (MLLW).
Datum Relationships for gage 73650 as of December 2013:
0.0' NAVD88 (2009.55) = 1.3' MLLW = 2.3' MLG or 0.0' MLLW = 1.0' MLG

Distances on the Calcasieu River are shown at 1 mile intervals.

The location of navigation aids are base on and provided by the U.S. Coast Guard and USACE survey crews.

2015 Aerial Photography data source: NAIP

Reference is N.O.A.A. Navigation Chart No. 11339.

* Difference between high and low frequency elevations where greater than 1.0'.

** Shoalest Sounding per Quarter per Reach.

*** High frequency (200 kHz) survey data represents the first signal return at a sounding location and will include suspended solids, known as "fluff", if present. Low frequency (20 kHz) survey data normally penetrates through this "fluff" layer to depict elevations of consolidated bottom material. Low frequency accuracies may vary depending on channel conditions and fathometer settings.

US Army Corps of Engineers
District: CEMVN

Distribution Liability: The data represents the results of data collection and processing efforts at the time of survey activity and indicates the general existing conditions. As such, it is only valid for its intended use, content, time and accuracy as presented by the collecting agency. The U.S. Government assumes no liability for any modification of the data for other than its intended purpose.

Data Constraints: Hydrographic survey data is subject to change due to environmental conditions that occur after the date of survey activity and natural shoaling and scouring processes. The U.S. Government assumes no responsibility for changes to the data in the hydrographical conditions which develop after the date of publication. This data is intended for U.S. Army Corps of Engineers' internal use. Present evidence based on survey used.

DISCLAIMER
Access Constraints: The United States Government furnishes these data and information without warranty. Its accuracy, understanding that the US Government makes no warranties, expressed, or implied concerning the accuracy, completeness, reliability, or suitability of this information. It is strongly recommended that these data and information be reviewed by the recipient fully agrees not to represent these data to anyone as other made thereof. These data belong to the Government. Therefore the than the original recipient. The United States shall be these data to others without also transferring this Disclaimer.

The information depicted on this map represents the results of a survey conducted on the date indicated and can only be considered to represent the general condition existing at that time.

U.S. ARMY CORPRPS OF ENGINEERS
NEW ORLEANS DISTRICT

Surveyed By: KC, PS	Plotted By: JH	Checked By: JH	
Submitted:	Recommended: Chief, Survey Section		Approved: Chief, Waterways Maintenance Section

CALCASIEU SHIP CHANNEL
BAR SHEET 30
CR_30_BAR_20240912_BD_POSTSTORM
12 September 2024

Sheet Reference Number
30 **of** 53

Revison Number:
4.2-20200420