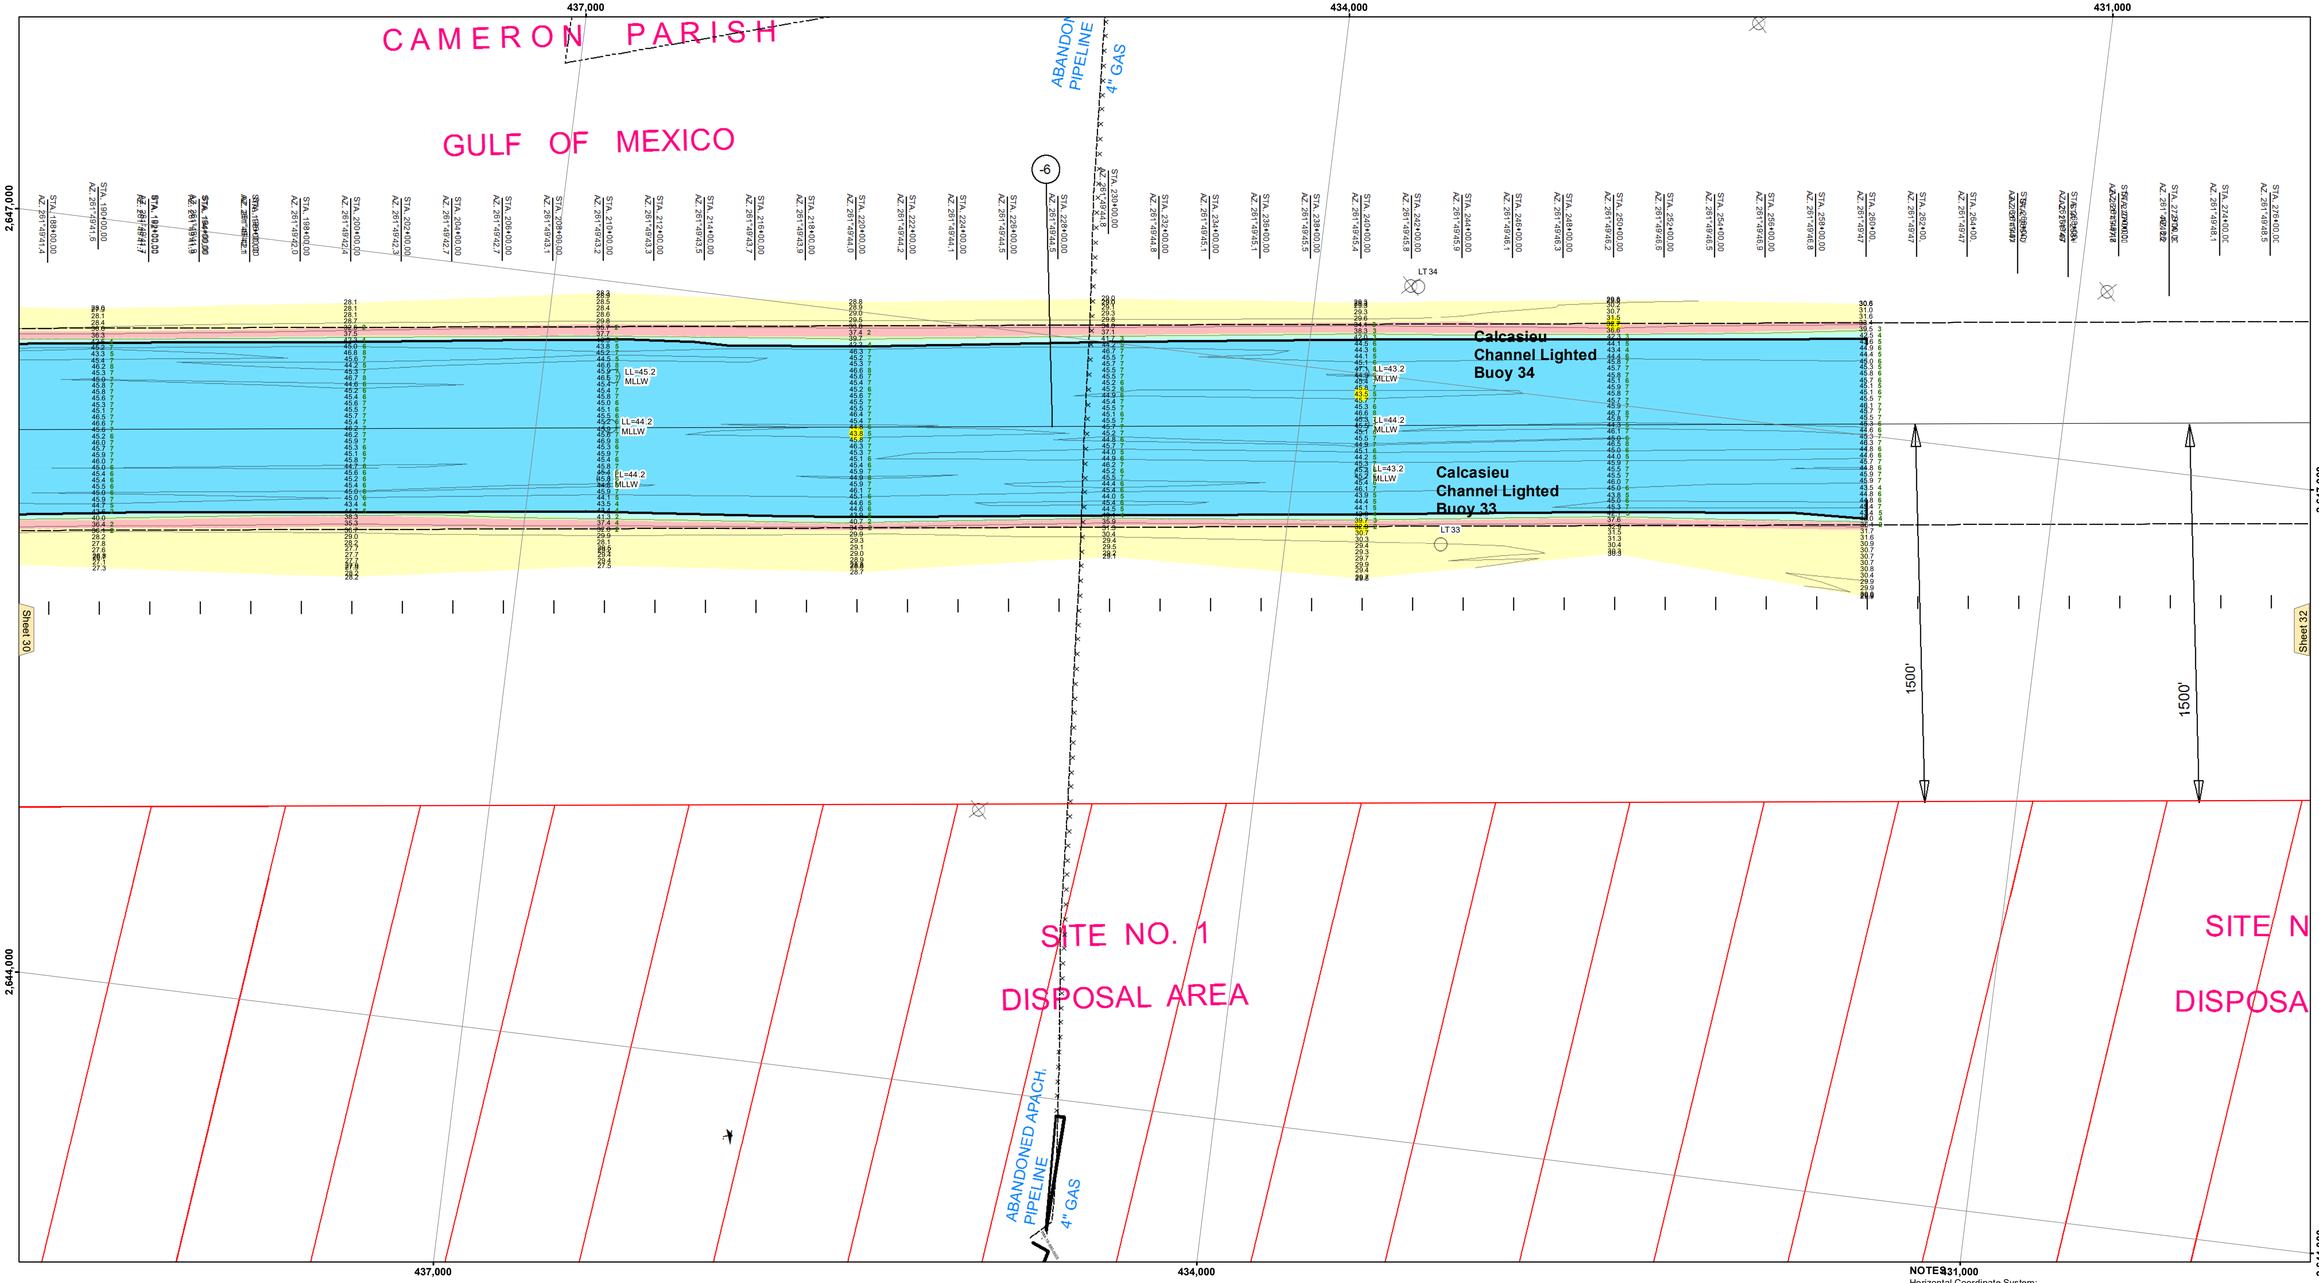

VICINITY MAP

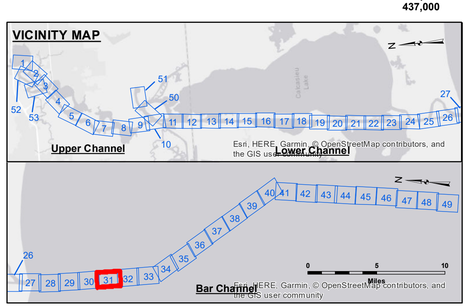

LEGEND

- Federal Navigation Channel
- Federal Navigation Center Line
- As-built Pipeline/Cable
- Unconfirmed Pipeline/Cable
- Project Depth Contour
- Cable Area
- Placement Area
- Anchorage Area
- Obstruction Point
- Wrecks-Submerged
- 3 Fluff Thickness (feet)*
- Shoalest Sounding**
- Beacon, General
- Red Navigation Buoy
- Green Navigation Buoy
- -16' and above
- -16' to -21'
- -21' to -26'
- -26' to -33'
- -33' to -39'
- -39' to -41'
- -41' to -43'
- -43' and below

Gage Reading:	CAMERON (NOAA): 1.8 MLLW
Sea Conditions:	1'
Vessel Name:	LAFOURCHE
Survey Type:	CONDITION
Sounding Frequency***:	LOW

Feet
0 400 800 1,200 1,600

NOTES:

Horizontal Coordinate System:
North American Datum of 1983 (NAD83), projected to the State Plane Coordinate System (SPCS), Louisiana South Zone. Distance units in U.S. Survey Feet.

Vertical Datum:
Soundings are shown in feet and indicate depths below Mean Lower Low Water Datum (MLLW).
Datum Relationships for gage 73650 as of December 2013:
0.0' NAVD88 (2009.55) = 1.3' MLLW = 2.3' MLG or 0.0' MLLW = 1.0' MLG

Distances on the Calcasieu River are shown at 1 mile intervals.

The location of navigation aids are base on and provided by the U.S. Coast Guard and USACE survey crews.

2015 Aerial Photography data source: NAIP

Reference is N.O.A.A. Navigation Chart No. 11339.

* Difference between high and low frequency elevations where greater than 1.0'.

** Shoalest Sounding per Quarter per Reach.

*** High frequency (200 kHz) survey data represents the first signal return at a sounding location and will include suspended solids, known as "fluff", if present. Low frequency (20 kHz) survey data normally penetrates through this "fluff" layer to depict elevations of consolidated bottom material. Low frequency accuracies may vary depending on channel conditions and fathometer settings.

US Army Corps of Engineers
District: CEMVN

Distribution Liability: The data represents the results of data collection and processing activities at the time of survey and indicates the general existing conditions. As such, it is only valid for its intended use, content, time and accuracy and is not to be used for any purpose other than its intended purpose.

Data Constraints: Hydrographic survey data is subject to change due to natural processes such as sedimentation and erosion, seismic activity, and natural shoaling and scouring processes. The U. S. Government makes no warranties, expressed or implied, as to the hydrographical conditions which develop after the date of publication. This data is intended for U. S. Army Corps of Engineers' internal use. Project maintained based on daily spot.

DISCLAIMER
Access Constraints: The United States Government furnishes this map and the data contained therein with the understanding that the US Government makes no warranties, expressed or implied concerning the accuracy, completeness, reliability, or suitability of this map or any of its contained information and the data furnished. The United States shall be under no liability whatsoever to any individual or party for any loss made thereof. These data belong to the Government. Therefore the recipient fully agrees not to represent these data to anyone as other than Government data. Recipient agrees to indemnify the Government these data to others without also transferring this Disclaimer.

The information depicted on this map represents the results of a survey conducted on the date indicated and can only be considered to represent the general condition existing at that time.

U.S. ARMY CORPPS OF ENGINEERS
NEW ORLEANS DISTRICT

Surveyed By: SPS, JH	Plotted By: AO	Checked By: AO

Submitted:

Recommended: Chief, Survey Section

Approved: Chief, Waterways Maintenance Section

CALCASIEU SHIP CHANNEL
BAR SHEET 31
CR_31_BAR_20180726_CS
26 July 2018

Sheet Reference Number
31 of 53

Revison Number:
3.12-20160811