

**LEGEND**

- Federal Navigation Channel
- Federal Navigation Center Line
- As-built Pipeline/Cable
- ..... Unconfirmed Pipeline/Cable
- Project Depth Contour
- Cable Area
- Placement Area
- Anchorage Area
- ⊗ Obstruction Point
- ⚓ Wrecks-Submerged
- Borrow Area
- Shoalest Sounding\*\*
- ★ Beacon, General
- ◆ Red Navigation Buoy
- ◆ Green Navigation Buoy
- -12' and above
- -12' and below

**NOTES:**

Horizontal Coordinate System:  
North American Datum of 1983 (NAD83), projected to the State Plane Coordinate System (SPCS), Louisiana South Zone. Distance units in U.S. Survey Feet.

Vertical Datum:  
Soundings are shown in feet and indicate depths below Mean Low Gulf Datum (MLG).

Mile markers on the G.I.W.W. are shown in one mile intervals.


The location of navigation aids are based on and provided by the U.S. Coast Guard.

2017 Aerial Photography data source: NAIP 1998 DOQQ imagery shown in green from USGS.

Reference is N.O.A.A. Navigation Chart No. 11367.

\*\* Shoalest Sounding per Quarter per Reach.

\*\*\* High frequency (200 kHz) survey data represents the first signal return at a sounding location and will include suspended solids, known as "fluff", if present. Low frequency (20 kHz) survey data normally penetrates through this "fluff" layer to depict elevations of consolidated bottom material. Low frequency accuracies may vary depending on channel conditions and fathometer settings.

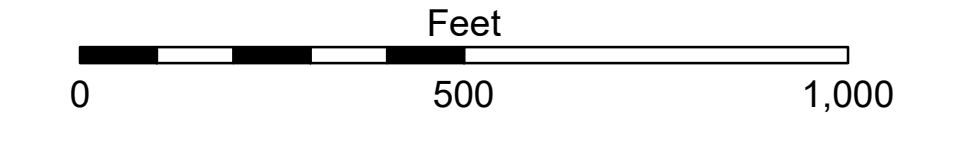

**DISCLAIMER**

The United States Government furnishes these data and the recipient accepts and uses them with the express understanding that the Government makes no warranty, expressed or implied, concerning the accuracy, completeness, reliability, usability or suitability for any particular purpose of the information. The recipient is responsible for the results obtained from the use of this information. The recipient agrees to indemnify and hold the United States Government harmless from any and all claims, damages, costs and expenses, including reasonable attorneys' fees, that may be asserted against or incurred by the United States Government or its employees, agents, contractors, or subcontractors, in connection with the use of this information. The recipient agrees to release the United States Government from any and all claims, damages, costs and expenses, including reasonable attorneys' fees, that may be asserted against or incurred by the recipient or its employees, agents, contractors, or subcontractors, in connection with the use of this information.

Submitted:	Surveyed By: RYLAND/HOSHMAN
Recommended: Chief Survey Station	Plotted By: AO
Approved: Chief Waterways Maintenance Section	Checked By: AO

**GULF INTRACOASTAL WATERWAY**  
**BARATARIA TO LAFOURCHE**  
**GI\_13\_B2L\_20200211\_CS**  
**11 February 2020**

**Sheet Reference Number**  
**13 of 191**

Revision Number:  
410-20190702