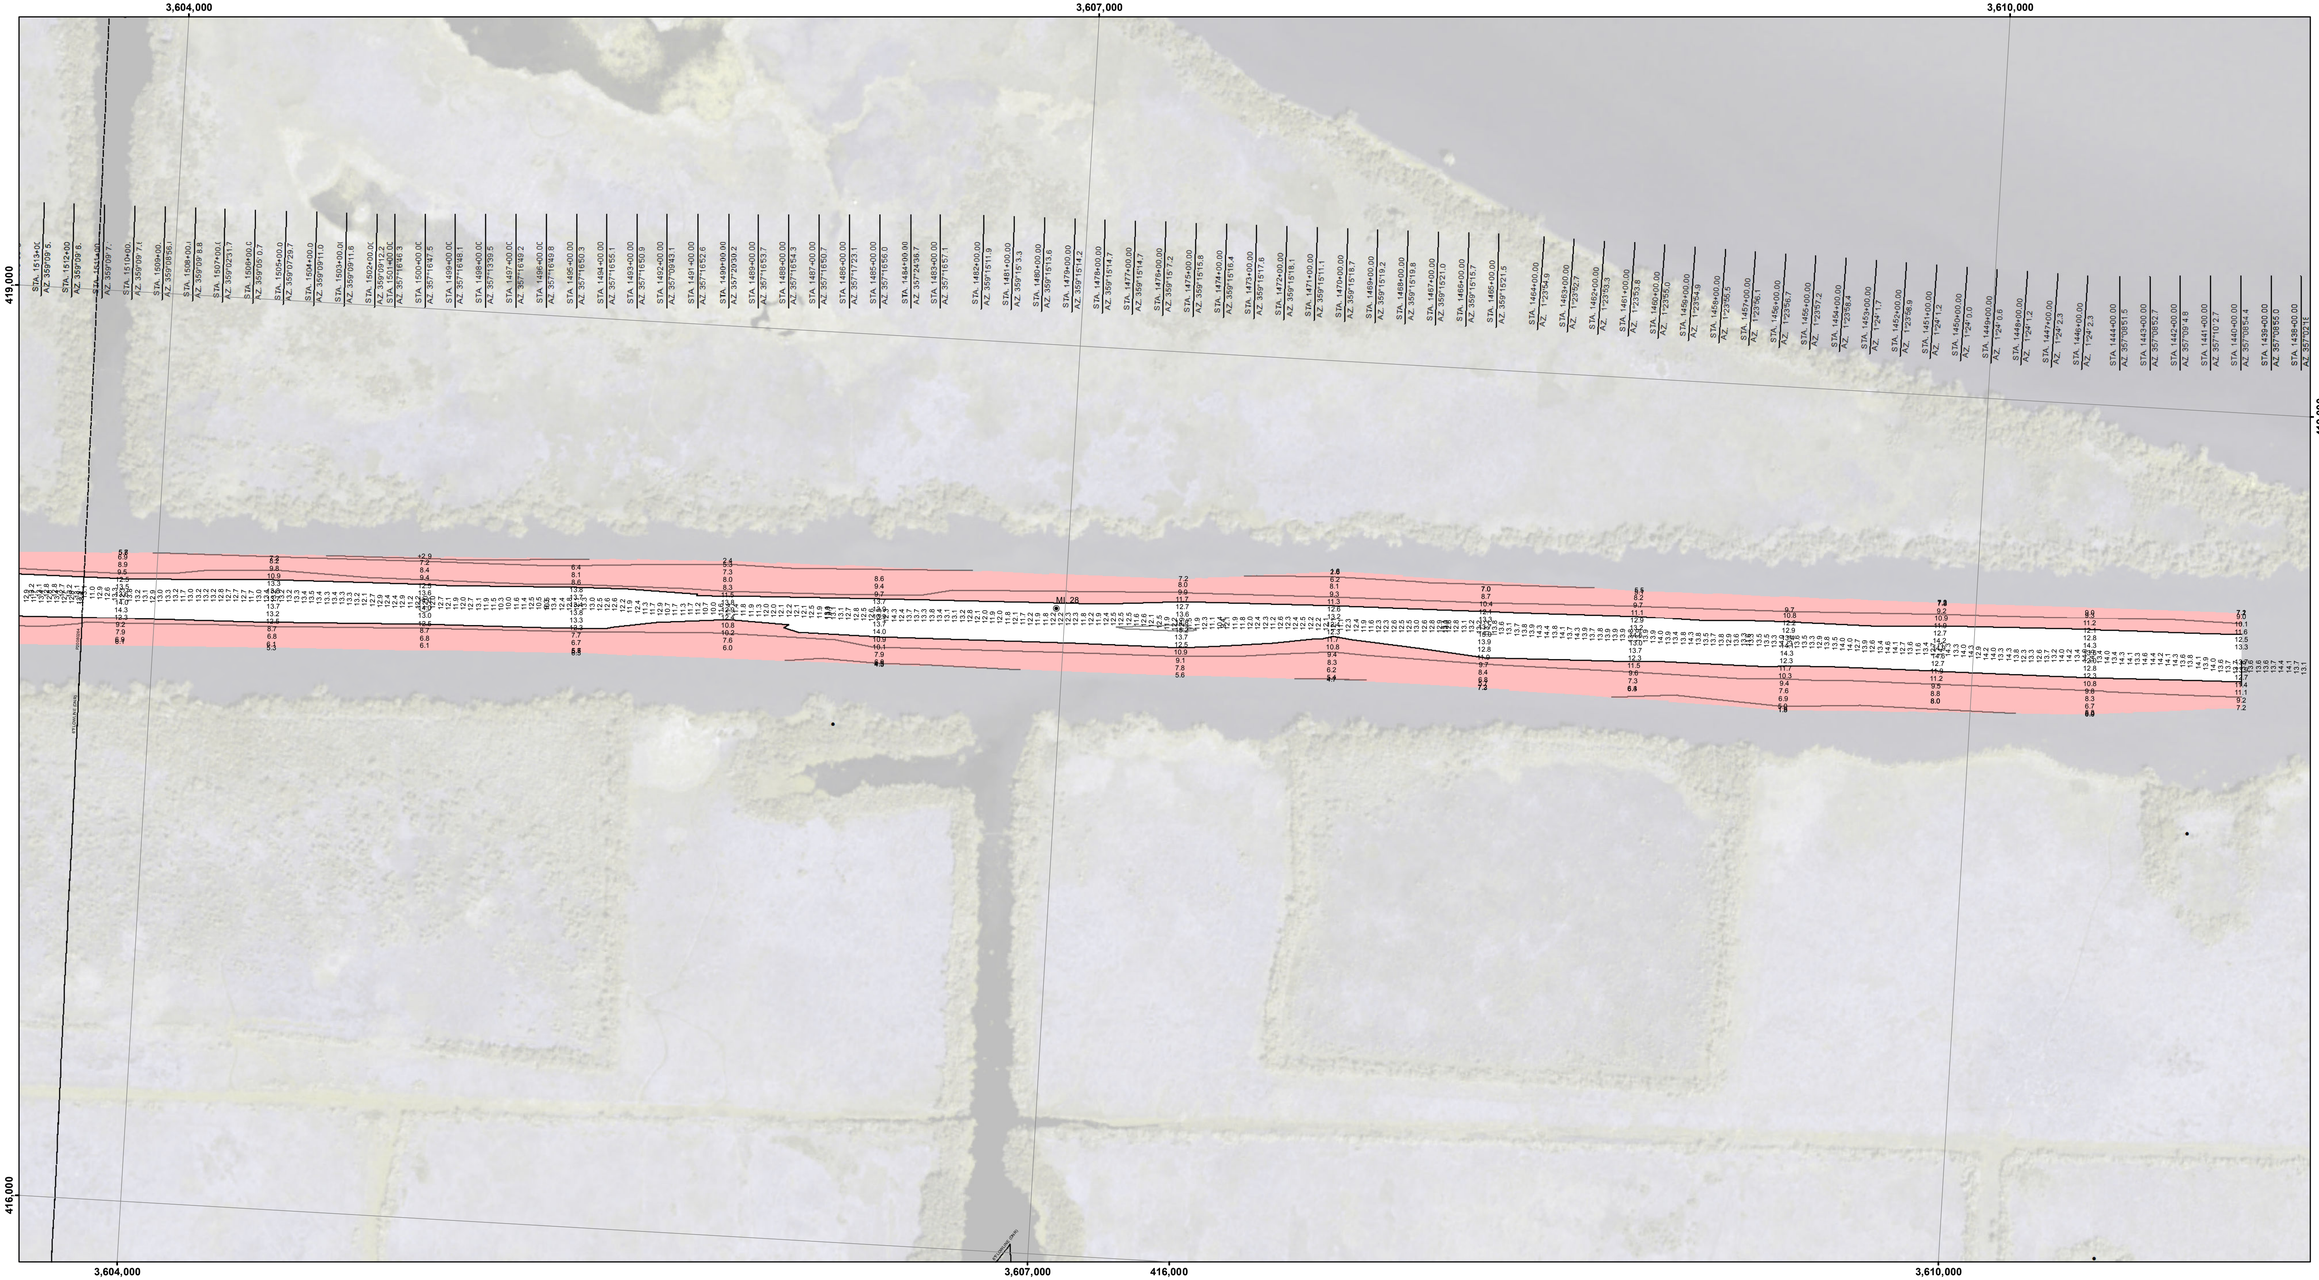

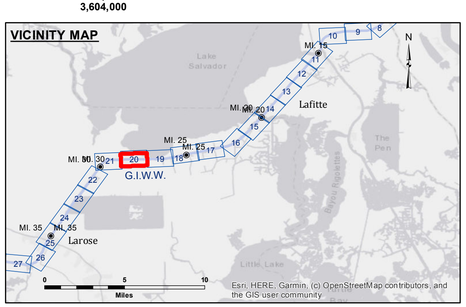

LEGEND

- Federal Navigation Channel
- Federal Navigation Center Line
- As-built Pipeline/Cable
- Unconfirmed Pipeline/Cable
- Project Depth Contour
- Cable Area
- Placement Area
- Anchorage Area
- Obstruction Point
- Wrecks-Submerged
- Borrow Area
- Shoalest Sounding**
- Beacon, General
- Red Navigation Buoy
- Green Navigation Buoy
- -12' and above
- -12' and below

Gage Reading:	WCC: 3.03 MLG AVG
Sea Conditions:	CHOP
Vessel Name:	OB-169
Survey Type:	CONDITION
Sounding Frequency***:	HIGH/LOW

Feet
0 500 1,000

NOTES:

Horizontal Coordinate System:
North American Datum of 1983 (NAD83), projected to the State Plane Coordinate System (SPCS), Louisiana South Zone. Distance units in U.S. Survey Feet.

Vertical Datum:
Soundings are shown in feet and indicate depths below Mean Low Gulf Datum (MLG).

Mile markers on the G.I.W.W. are shown in one mile intervals.

The location of navigation aids are base on and provided by the U.S. Coast Guard.

2017 Aerial Photography data source: NAIP. 1998 DOQQ imagery shown in green from USGS.

Reference is N.O.A.A. Navigation Chart No. 11365.

** Shoalest Sounding per Quarter per Reach.

*** High frequency (200 kHz) survey data represents the first signal return at a sounding location and will include suspended solids, known as "fluff", if present. Low frequency (20 kHz) survey data normally penetrates through this "fluff" layer to depict elevations of consolidated bottom material. Low frequency accuracies may vary depending on channel conditions and fathometer settings.

US Army Corps of Engineers
District: CEMVN

DISCLAIMER:
Access Constraints: The United States Government furnishes these data and information on an "as is" basis. The recipient agrees to assume any and all risk associated with the use of any data or information and the data furnished. The United States shall not be liable, whatsoever by any person, for any damages, including, without limitation, consequential damages, resulting from the recipient fully agrees not to represent these data to anyone as other than preliminary and unofficial without verification, clarification, and conformation by the U.S. Army Corps of Engineers. The U.S. Army Corps of Engineers accepts no responsibility for any deficiencies in these data which may exist. The act of distribution shall not constitute any such warranty. The recipient agrees to indemnify and hold the United States harmless from any damages which may result from the use or misuse of these data and information. The recipient further agrees to inform any subsequent recipient of the terms of this Disclaimer.

Distribution Liability: The data represents the results of data collection and analysis performed by the Corps for its own activity and indicates the general existing conditions. As such it is only valid for its intended use, content, time and accuracy. The Corps accepts no responsibility for any other use or misuse of any of the application of the data for other than its intended purpose.

Data Constraints: Hydrographic survey data is subject to change over time due to environmental factors, such as storms, shoaling activity, and natural sloughing and scouring processes. The U. S. Army Corps of Engineers accepts no responsibility for changes in the condition of the channel and adjacent areas after the date of publication. This data is intended for U. S. Army Corps of Engineers' internal use. Project customers should not rely solely upon it.

U.S. ARMY CORPPS OF ENGINEERS
NEW ORLEANS DISTRICT

Surveyed By: SP,PM	Plotted By: AO	Checked By: AO
Submitted:	Recommended: Chief, Survey Section	Approved: Chief, Waterways Maintenance Section

GULF INTRACOASTAL WATERWAY
BARATARIA TO LAFOURCHE
GI_20_B2L_20211029_AD
29 October 2021

Sheet Reference Number
20 **of** 191

Revison Number:
4.2-20200420