
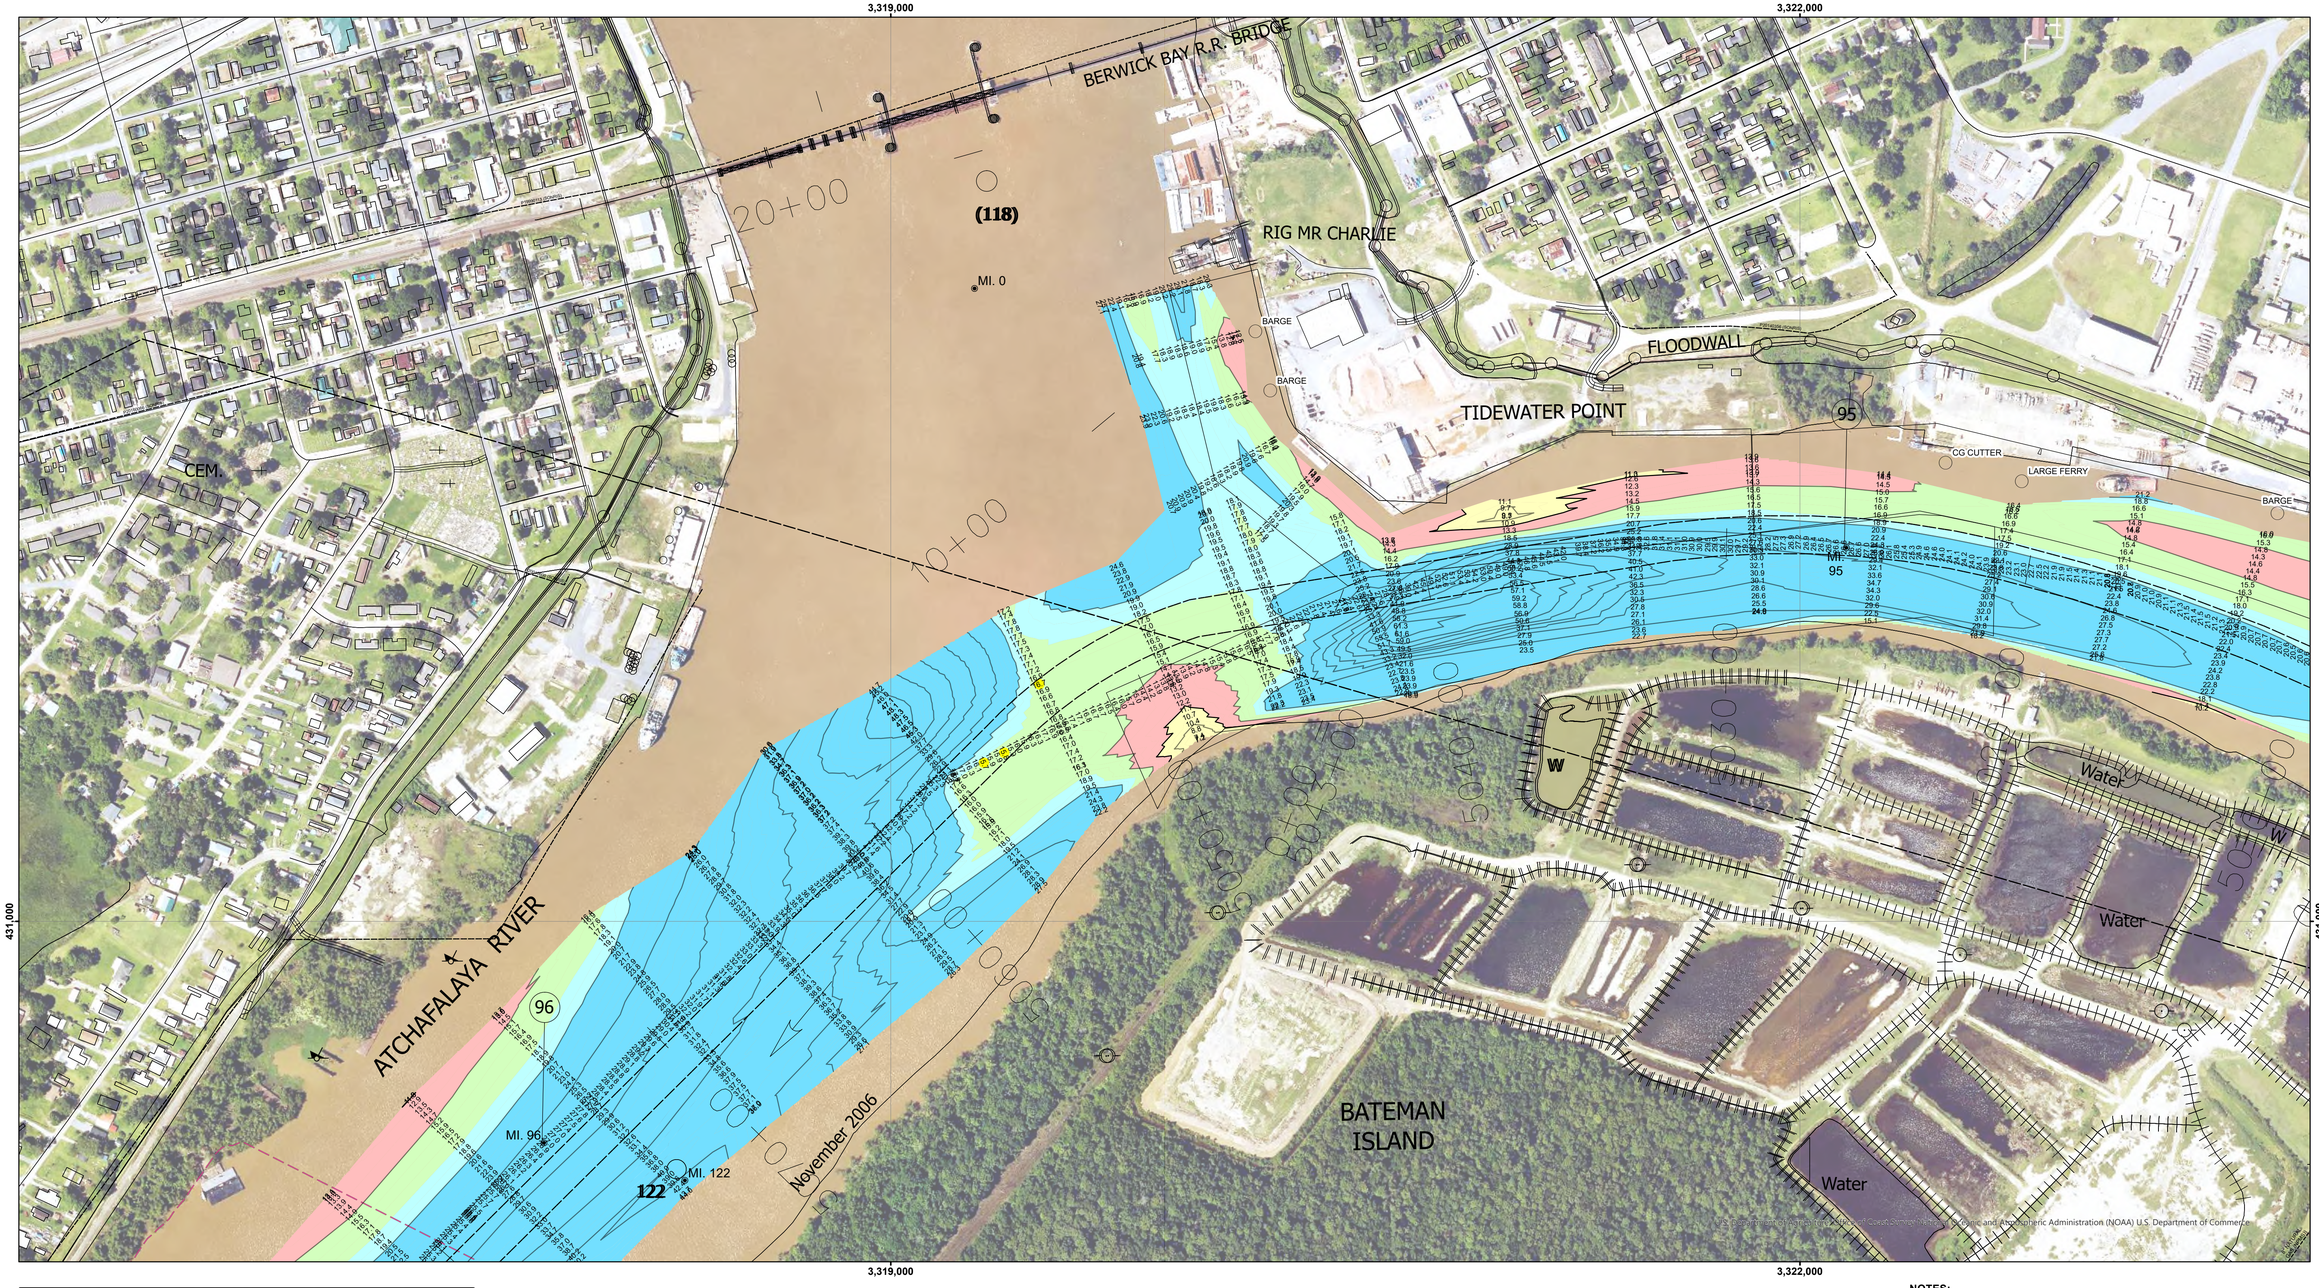


VICINITY MAP

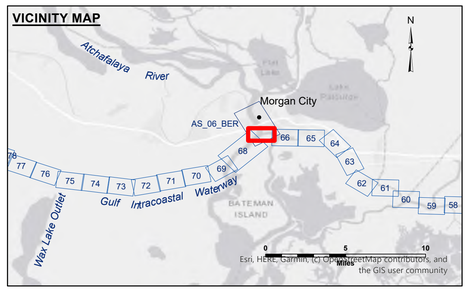

LEGEND

- Federal Navigation Channel
- Federal Navigation Center Line
- As-built Pipeline/Cable
- Unconfirmed Pipeline/Cable
- Project Depth Contour
- Cable Area
- Placement Area
- Anchorage Area
- Obstruction Point
- Wrecks-Submerged
- Borrow Area
- Shoalest Sounding**
- Beacon, General
- Red Navigation Buoy
- Green Navigation Buoy
- -6' and above
- -6 to -8
- -8 to -10
- -10 to -12
- -12' to -15'
- -15' to -18'
- -18' to -20'
- -20' and below

N W E S

Gage Reading:	MORGAN CITY: 3.20 MLG
Sea Conditions:	CALM
Vessel Name:	M/V VALENTOUR
Survey Type:	CONDITION
Sounding Frequency***:	HIGH

Feet
0 500 1,000

NOTES:

Horizontal Coordinate System:
North American Datum of 1983 (NAD83), projected to the State Plane Coordinate System (SPCS), Louisiana South Zone. Distance units in U.S. Survey Feet.

Vertical Datum:
Soundings are shown in feet and indicate depths below Mean Low Gulf Datum (MLG). Datum Relationships for Lower Atchafalaya River at Morgan City (03780) as of 2025: 0.0' NAVD88 (2009.55) = 2.19' MLG

The location of navigation aids are base on and provided by the U.S. Coast Guard.

2023 Aerial Photography data source: NAIP

Reference is N.O.A.A. Navigation Chart No. 11355.

** Shoalest Sounding per Quarter per Reach.

*** High frequency (200 kHz) survey data represents the first signal return at a sounding location and will include suspended solids, known as "fluff", if present. Low frequency (20 kHz) survey data normally penetrates through this "fluff" layer to depict elevations of consolidated bottom material. Low frequency accuracies may vary depending on channel conditions and fathometer settings.

US Army Corps of Engineers District: CEMVN

DISCLAIMER
Access Constraints: The United States Government furnishes this map and geographic data and related graphics as is with no understanding that the US Government makes no warranties, expressed, or implied concerning the accuracy, completeness, reliability, or suitability of this information for any purpose. The information and the data furnished. The United States shall be under no liability whatsoever to any individual or party for any loss made thereof. These data belong to the Government. Therefore the recipient fully agrees not to represent these data to anyone as other than data furnished by the Government. Any user shall indemnify these data to others without also transferring this Disclaimer.

Distribution Liability: The data represents the results of data collection and analysis performed by the Corps of Engineers activity and indicates the general existing conditions. As such it is only valid for its intended use, content, time and accuracy of the application of the data for other than its intended purpose.

Data Constraints: Hydrographic survey data is subject to change due to environmental conditions such as storms and natural shoaling activity and natural shoaling and scouring processes. The U. S. Army Corps of Engineers assumes no responsibility for changes in the hydrographical conditions which develop after the date of publication. This data is intended for U. S. Army Corps of Engineers internal use. Present navigation aids may be moving apart.

U.S. ARMY COPRPS OF ENGINEERS
NEW ORLEANS DISTRICT

Surveyed By:	SP_JS
Plotted By:	BD
Checked By:	AOJH
Submitted:	
Recommended:	Chief, Survey Section
Approved:	Chief, Waterways Maintenance Section

GULF INTRACOASTAL WATERWAY
20 GRAND POINT
GI_67_BBW_20261016_CS
16 October 2026

Sheet Reference Number
67 **of** 191

Revison Number:
5.26.07.27-5.26.07.27