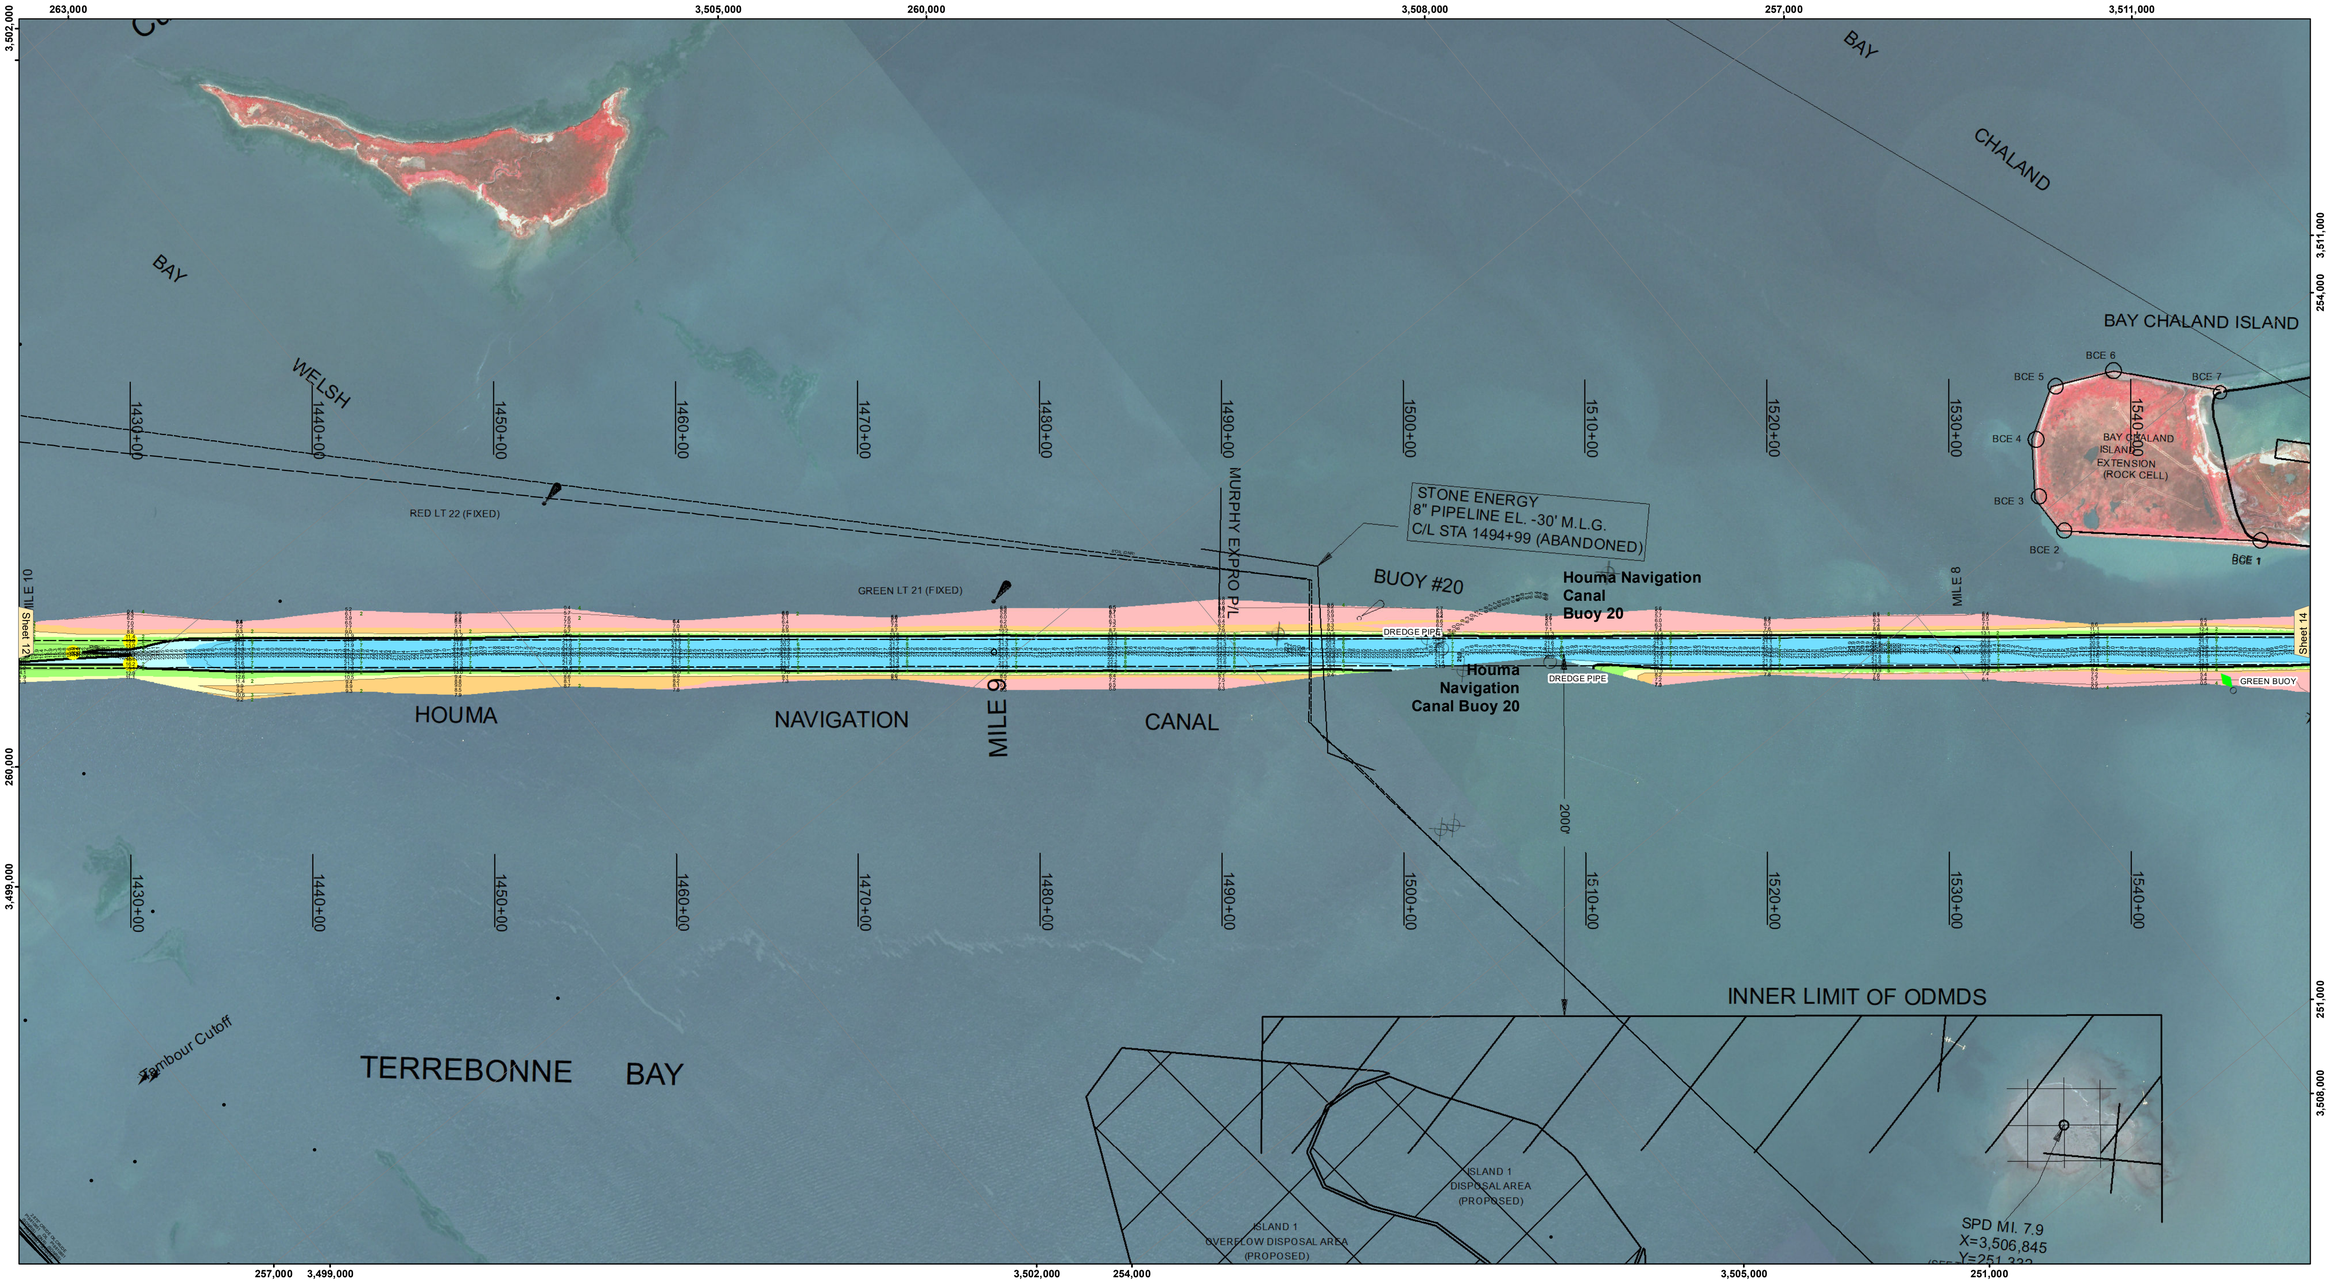

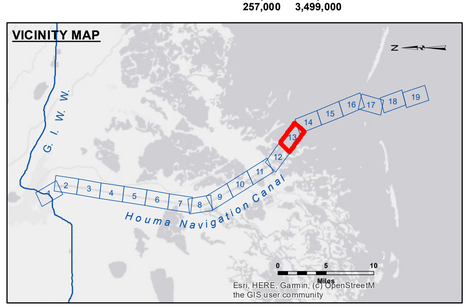

LEGEND

- Federal Navigation Channel
- Federal Navigation Center Line
- As-built Pipeline/Cable
- Unconfirmed Pipeline/Cable
- Project Depth Contour
- Cable Area
- Placement Area
- Anchorage Area
- Obstruction Point
- Wrecks-Submerged
- 3 Fluff Thickness (feet)*
- Shoalest Sounding**
- Beacon, General
- Red Navigation Buoy
- Green Navigation Buoy
- -8' and above
- -8' to -10'
- -10' to -12'
- -12' to -16'
- -16' to -19'
- -19' and below

Gage Reading:	FRONT RANGE B: 0.97 MLLW AVG
Sea Conditions:	CALM
Vessel Name:	OB-167
Survey Type:	AD
Sounding Frequency***:	LOW

Feet
0 400 800 1,200 1,600 2,000

NOTES:

Horizontal Coordinate System:
North American Datum of 1983 (NAD83), projected to the State Plane Coordinate System (SPCS), Louisiana South Zone. Distance units in U.S. Survey Feet.

Vertical Datum:
Soundings are shown in feet and indicate depths below Mean Lower Low Water Datum (MLLW).
Datum Relationships for 88455 as of September 2022:
0.0' NAVD88 (OPUS 2019) = 0.40' MLLW (2012-2016) = 1.40' MLG

Distances on the Houma Nav. Canal are shown at 1 mile intervals.

The location of navigation aids are base on and provided by the U.S. Coast Guard and USACE survey crews.

2022 Aerial Photography data source: Optimal GEO, Inc. (1998 DOQQ Imagery in green)

Reference is N.O.A.A. Navigation Chart No. 11355.

* Difference between high and low frequency elevations where greater than 1.0'.
** Shoalest Sounding per Quarter per Reach.
*** High frequency (200 kHz) survey data represents the first signal return at a sounding location and will include suspended solids, known as "fluff", if present. Low frequency (20 kHz) survey data normally penetrates through this "fluff" layer to depict elevations of consolidated bottom material. Low frequency accuracies may vary depending on channel conditions and fathometer settings.

US Army Corps of Engineers
District: CEMVN

DISCLAIMER
Access Constraints: The United States Government furnishes this data and information without warranties, express or implied, as to any matter whatsoever, including, but not limited to, the accuracy, completeness, usefulness, or suitability for any purpose of the information and the data furnished. The United States shall be held harmless from any liability or damages resulting from the use made thereof. These data belong to the Government. Therefore the recipient fully agrees not to represent these data to anyone as other than Government data, or to represent themselves as the owners of these data to others without also transferring this Disclaimer.

The information depicted on this map represents the results of a survey conducted on the date indicated and can only be considered to represent the general condition existing at that time.

Distribution Liability: The data represents the results of data collection activities conducted by the Corps of Engineers and indicates the general existing conditions. As such, it is only valid for its intended use. Content, time and accuracy of data may be inadequate for any other purpose. Use of any of the application of the data for other than its intended purpose.

Data Constraints: Hydrographic survey data is subject to change due to storms and other conditions which affect coastal and riverine activity and natural shoaling and scouring processes. The U. S. Army Corps of Engineers makes no representations as to the state in the hydrographical conditions which develop after the date of publication. This data is intended for U. S. Army Corps of Engineers internal use. Present revisions based on daily traffic count.

U.S. ARMY CORPS OF ENGINEERS
NEW ORLEANS DISTRICT

Submitted:	
Recommended: Chief, Survey Section	
Approved: Chief, Waterways Maintenance Section	
Surveyed By:	ADAMS/CHAMPINE
Plotted By:	JH
Checked By:	JH

HOUMA NAVIGATION CANAL
BAY CHANNEL
HN_13_BAY_20240201_AD
01 February 2024

Sheet Reference Number
13 of 19

Revison Number:
4.2-20200420