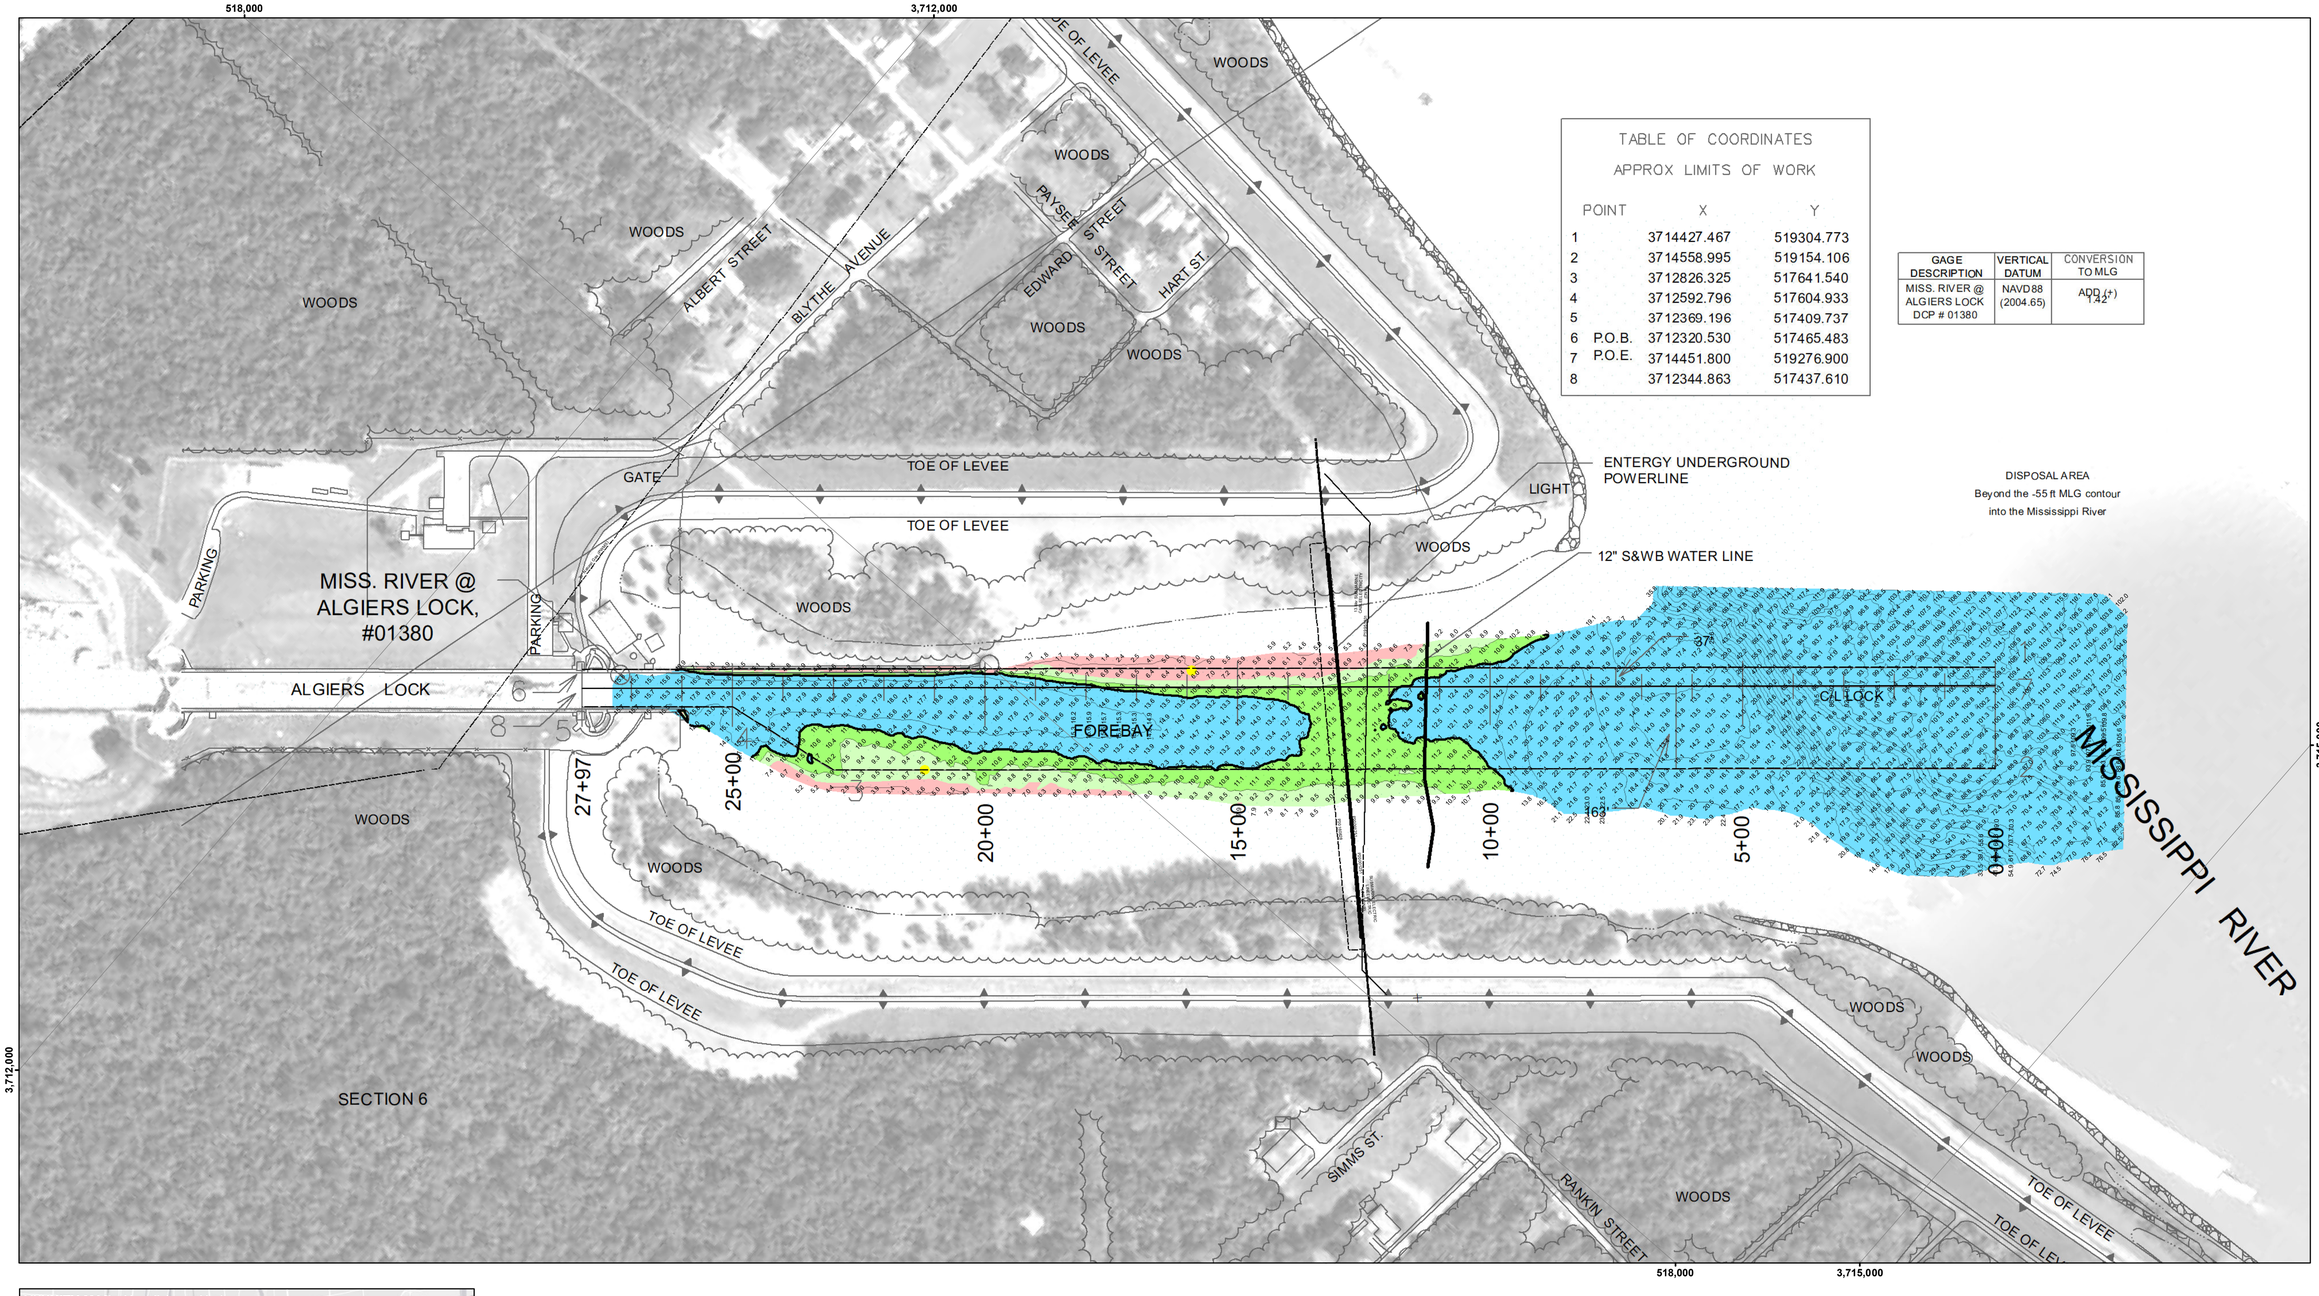

TABLE OF COORDINATES
APPROX LIMITS OF WORK

POINT		X	Y
1		3714427.467	519304.773
2		3714558.995	519154.106
3		3712826.325	517641.540
4		3712592.796	517604.933
5		3712369.196	517409.737
6	P.O.B.	3712320.530	517465.483
7	P.O.E.	3714451.800	519276.900
8		3712344.863	517437.610

GAGE DESCRIPTION	VERTICAL DATUM	CONVERSION TO MLG

DISCLAIMER:
Access Constraints: The United States Government furnishes these data and the US Government assumes no liability except as expressly stated, or implied concerning the accuracy, completeness, timeliness, and the rights to property described. Any use of the information and the data furnished. The United States shall be under no liability whatsoever to any person by reason of any use made thereof, and the recipient agrees to indemnify the United States for any such liability. The recipient fully agrees not to represent these data to anyone as other than data furnished by the US Government. Any use of these data by others without also transferring this Disclaimer.

Distribution Liability: The data represents the results of data collection and analysis performed by the U.S. Army Corps of Engineers activity and indicates the general existing condition. As such, it is only valid for its intended use, content, time and accuracy of the application of the data for other than its intended purpose.

Data Constraints: Hydrographic survey data is subject to change due to environmental conditions such as shoaling and scouring activity and natural shoaling and scouring processes. The U. S. Army Corps of Engineers accepts no responsibility for changes in the survey data that occur between the date of survey and date of publication. This data is intended for U. S. Army Corps of Engineers' internal use. Project conditions should be verified by survey prior to

US Army Corps of Engineers
District: CEMVN

U.S. ARMY CORPS OF ENGINEERS
NEW ORLEANS DISTRICT

Submitted:	Surveyed By: PM,SPS	Plotted By: BD	Checked By: AO
Recommended:	Chief, Survey Section		
Approved:	Chief, Waterways Maintenance Section		

MISSISSIPPI RIVER DEEP-DRAFT LOCKS
ALGIERS LOCK FOREBAY
LK_01_ALG_20220414_CS_5X5
14 April 2022

Sheet Reference Number
1 **of** 4

Revison Number:
4.2-20200420

VICINITY MAP *New Orleans Harbor*

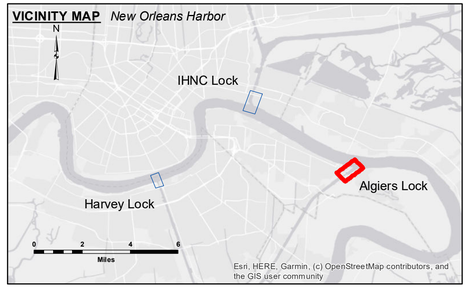

LEGEND

- Federal Navigation Channel
- Federal Navigation Center Line
- As-built Pipeline/Cable
- Unconfirmed Pipeline/Cable
- Project Depth Contour
- Cable Area
- Placement Area
- Anchorage Area
- Obstruction Point
- Wrecks-Submerged
- Placement Area
- Shoalest Sounding**
- Beacon, General
- Red Navigation Buoy
- Green Navigation Buoy
- -8' and above
- -8' to -10'
- -10' to -12'
- -12' and below

LWRP:	N/A
Gage Reading:	ALGIERS LOCK FB: 10.12 MLG
Sea Conditions:	CALM
Vessel Name:	OB-167
Survey Type:	MB
Sounding Frequency***:	400KHZ

Feet
0 200 400 600 800

NOTES:

Horizontal Coordinate System:
North American Datum of 1983 (NAD83), projected to the State Plane Coordinate System (SPCS), Louisiana South Zone. Distance units in U.S. Survey Feet.

Vertical Datum:
Soundings are shown in feet and indicate depths below Mean Low Gulf (MLG).

Distances on the Mississippi River, above and below Head of Passes are shown at 1 mile intervals.

The location of navigation aids are base on and provided by the U.S. Coast Guard and USACE crew.

2015 Aerial Photography data source: NAIP, USDA-FSA-APFO Aerial Photography Field Office.

Reference is N.O.A.A. Navigation Chart No. 11370.

** Shoalest Sounding per Quarter per Reach.

*** High frequency (200 kHz) survey data represents the first signal return at a sounding location and will include suspended solids, known as "fluff", if present. Low frequency (20 kHz) survey data normally penetrates through this "fluff" layer to depict elevations of consolidated bottom material. Low frequency accuracies may vary depending on channel conditions and fathometer settings.