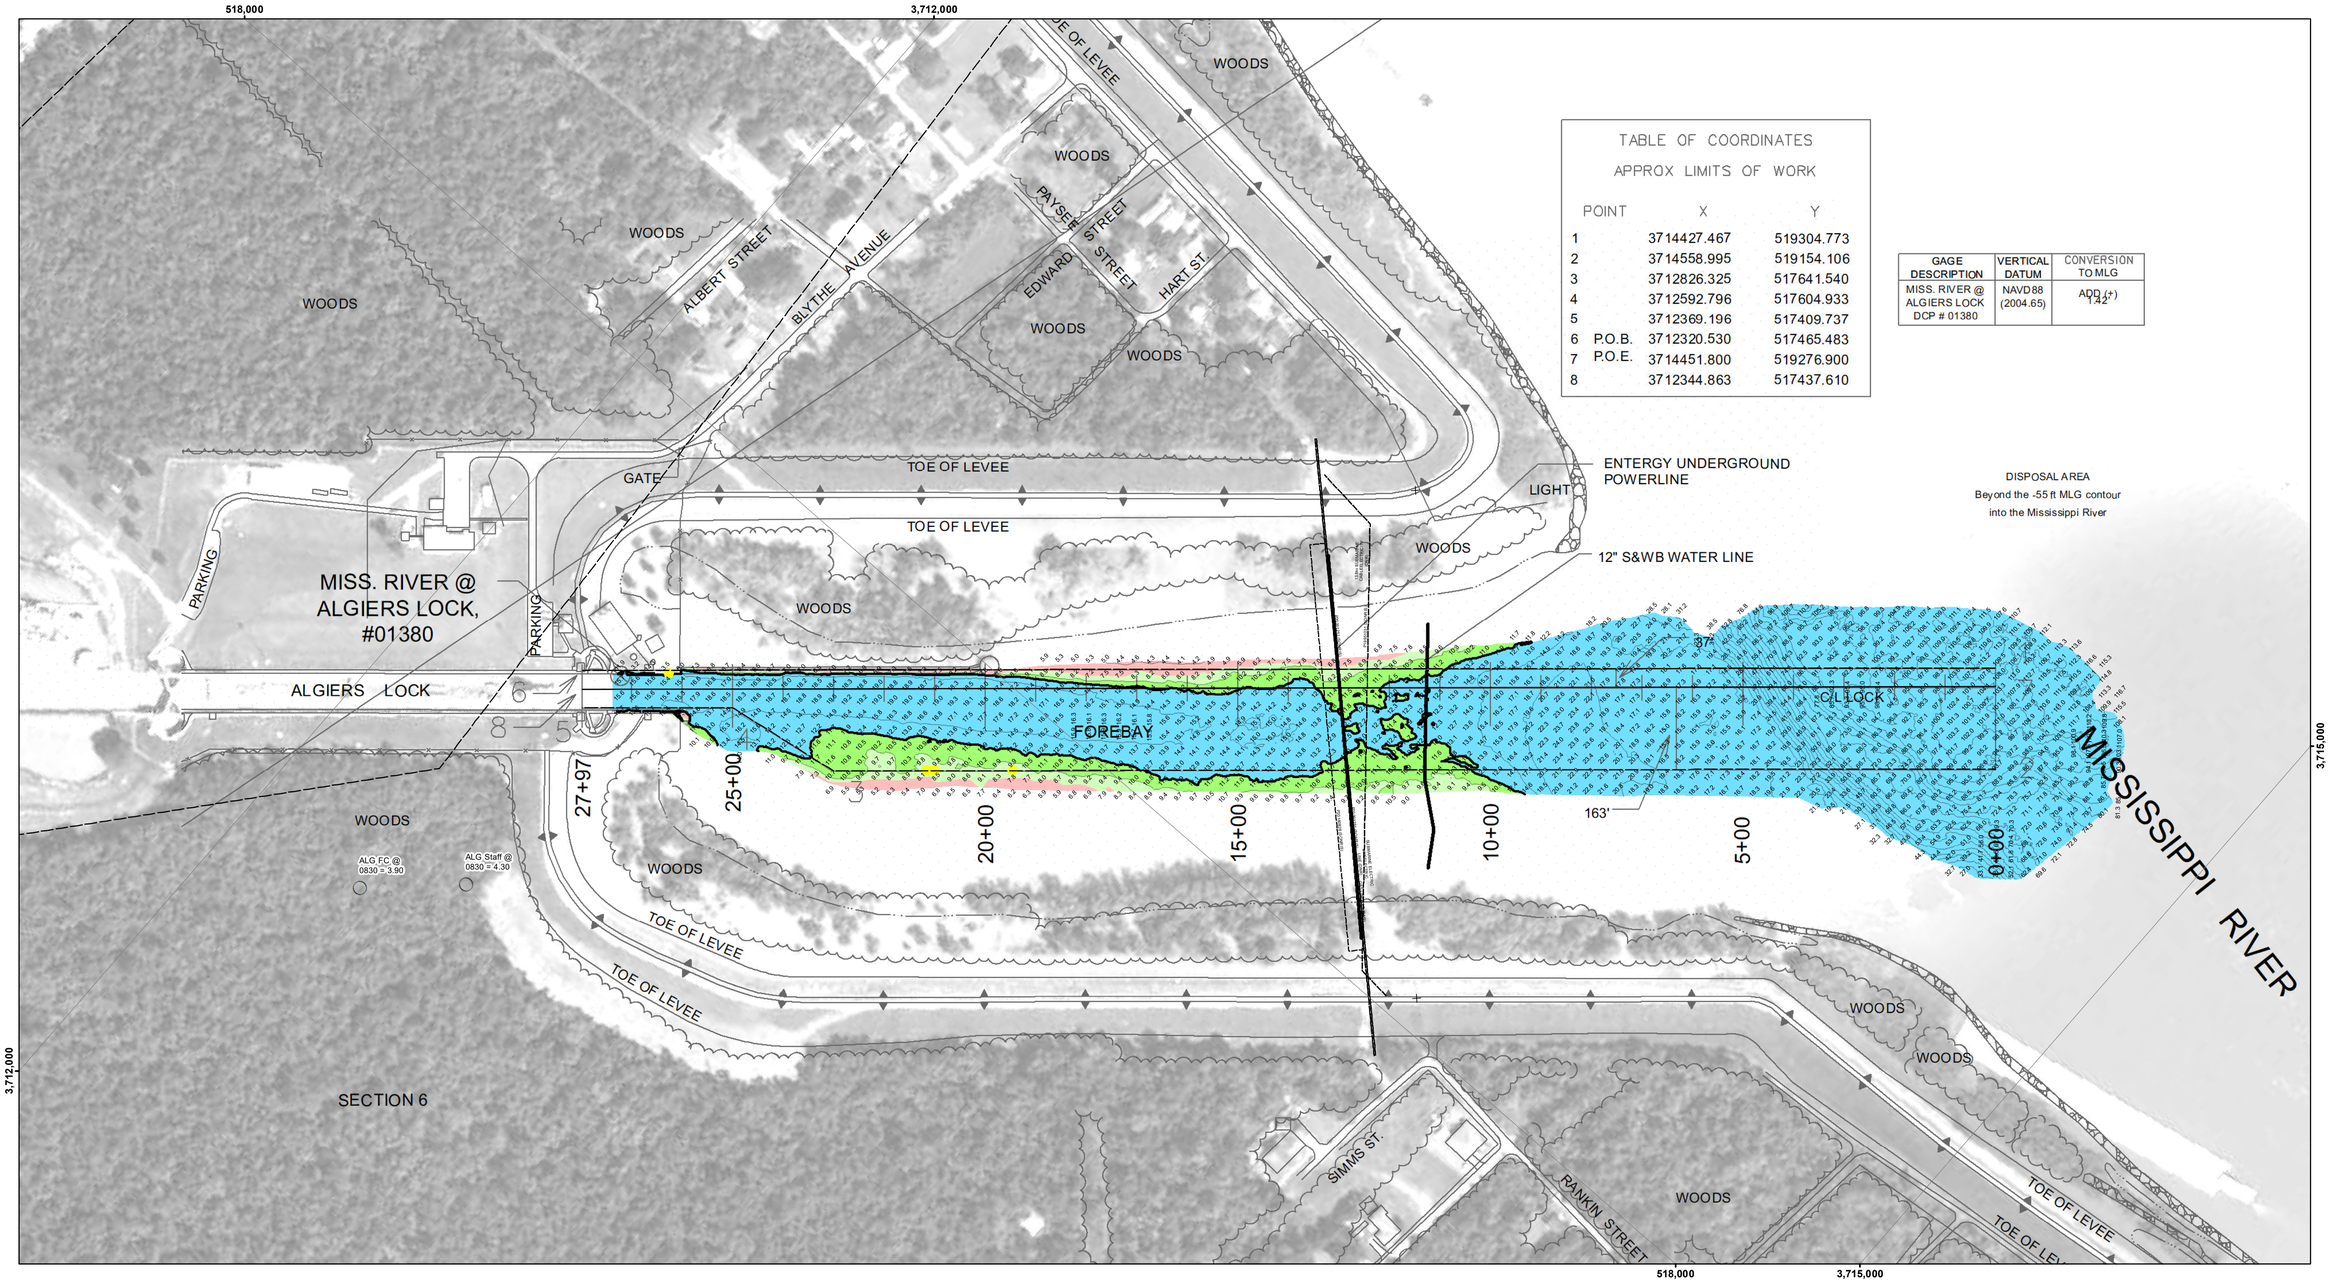

TABLE OF COORDINATES APPROX LIMITS OF WORK			
POINT		X	Y
1		3714427.467	519304.773
2		3714558.995	519154.106
3		3712826.325	517641.540
4		3712592.796	517604.933
5		3712369.196	517409.737
6	P.O.B.	3712320.530	517465.483
7	P.O.E.	3714451.800	519276.900
8		3712344.863	517437.610

GAGE DESCRIPTION	VERTICAL DATUM	CONVERSION TO MLG
MISS. RIVER @ ALGIERS LOCK DCP # 01380	NAVD88 (2004.65)	ADD (+) 1.42

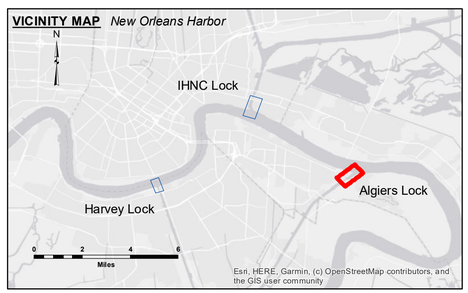

LEGEND

- Federal Navigation Channel
- Federal Navigation Center Line
- As-built Pipeline/Cable
- Unconfirmed Pipeline/Cable
- Project Depth Contour
- Cable Area
- Placement Area
- Anchorage Area
- Obstruction Point
- Wrecks-Submerged
- Placement Area
- Shoalest Sounding**
- Beacon, General
- Red Navigation Buoy
- Green Navigation Buoy
- -8' and above
- -8' to -10'
- -10' to -12'
- -12' and below

LWRP:	N/A
Gage Reading:	5.72 MLG
Sea Conditions:	CALM
Vessel Name:	DUCARPE
Survey Type:	MB
Sounding Frequency***:	400

Feet
0 200 400 600 800

NOTES:

Horizontal Coordinate System:
North American Datum of 1983 (NAD83), projected to the State Plane Coordinate System (SPCS), Louisiana South Zone. Distance units in U.S. Survey Feet.

Vertical Datum:
Soundings are shown in feet and indicate depths below Mean Low Gulf (MLG).

Distances on the Mississippi River, above and below Head of Passes are shown at 1 mile intervals.

The location of navigation aids are base on and provided by the U.S. Coast Guard and USACE crew.

2015 Aerial Photography data source: NAIP, USDA-FSA-APFO Aerial Photography Field Office.

Reference is N.O.A.A. Navigation Chart No. 11370.

** Shoalest Sounding per Quarter per Reach.

*** High frequency (200 kHz) survey data represents the first signal return at a sounding location and will include suspended solids, known as "fluff", if present. Low frequency (20 kHz) survey data normally penetrates through this "fluff" layer to depict elevations of consolidated bottom material. Low frequency accuracies may vary depending on channel conditions and fathometer settings.

US Army Corps of Engineers
District: CEMVN

DISCLAIMER
Access Constraints: The United States Government furnishes these data and the USACE accepts and uses them with the express understanding that the government makes no warranties, expressed, or implied concerning the accuracy, completeness, reliability, or suitability of this information, of any of the information and the data furnished. The United States shall be under no liability whatsoever to any person by reason of any use made thereof. It is agreed that with the acceptance of these data the recipient fully agrees not to represent these data to anyone as other than government data. It is further agreed that the recipient will delineate these data to others without also transferring this Disclaimer.

The information depicted on this map represents the results of a survey conducted on the date indicated and can only be considered to represent the general condition existing at that time.

Distribution Liability: The data represents the results of data collection and processing for operation of the Army Corps of Engineers civil works projects. It is provided as a public service and it is only valid for its intended use, content, time and accuracy of the data at the time of publication. The U.S. Government is not liable for any of any of the application of the data for other than its intended purpose.

Data Constraints: Hydrographic survey data is subject to change due to natural and man-made influences such as storms, dredging activity and natural shoaling and scouring processes. The U. S. Army Corps of Engineers accepts no responsibility for changes in the hydrographic survey data after the date of the survey publication. This data is intended for U. S. Army Corps of Engineers' internal use. Project engineers should use key survey points.

U.S. ARMY CORPS OF ENGINEERS
NEW ORLEANS DISTRICT

Submitted:

Recommended:
Chief, Survey Section

Approved:
Chief, Waterways Maintenance Section

Surveyed By: PM,AO
Plotted By: AO
Checked By: AO

MISSISSIPPI RIVER DEEP-DRAFT LOCKS
ALGIERS LOCK FOREBAY
LK_01_ALG_20240726_CS_3X3
26 July 2024

Sheet Reference Number
1 of 4

Revison Number:
4.2-20200420