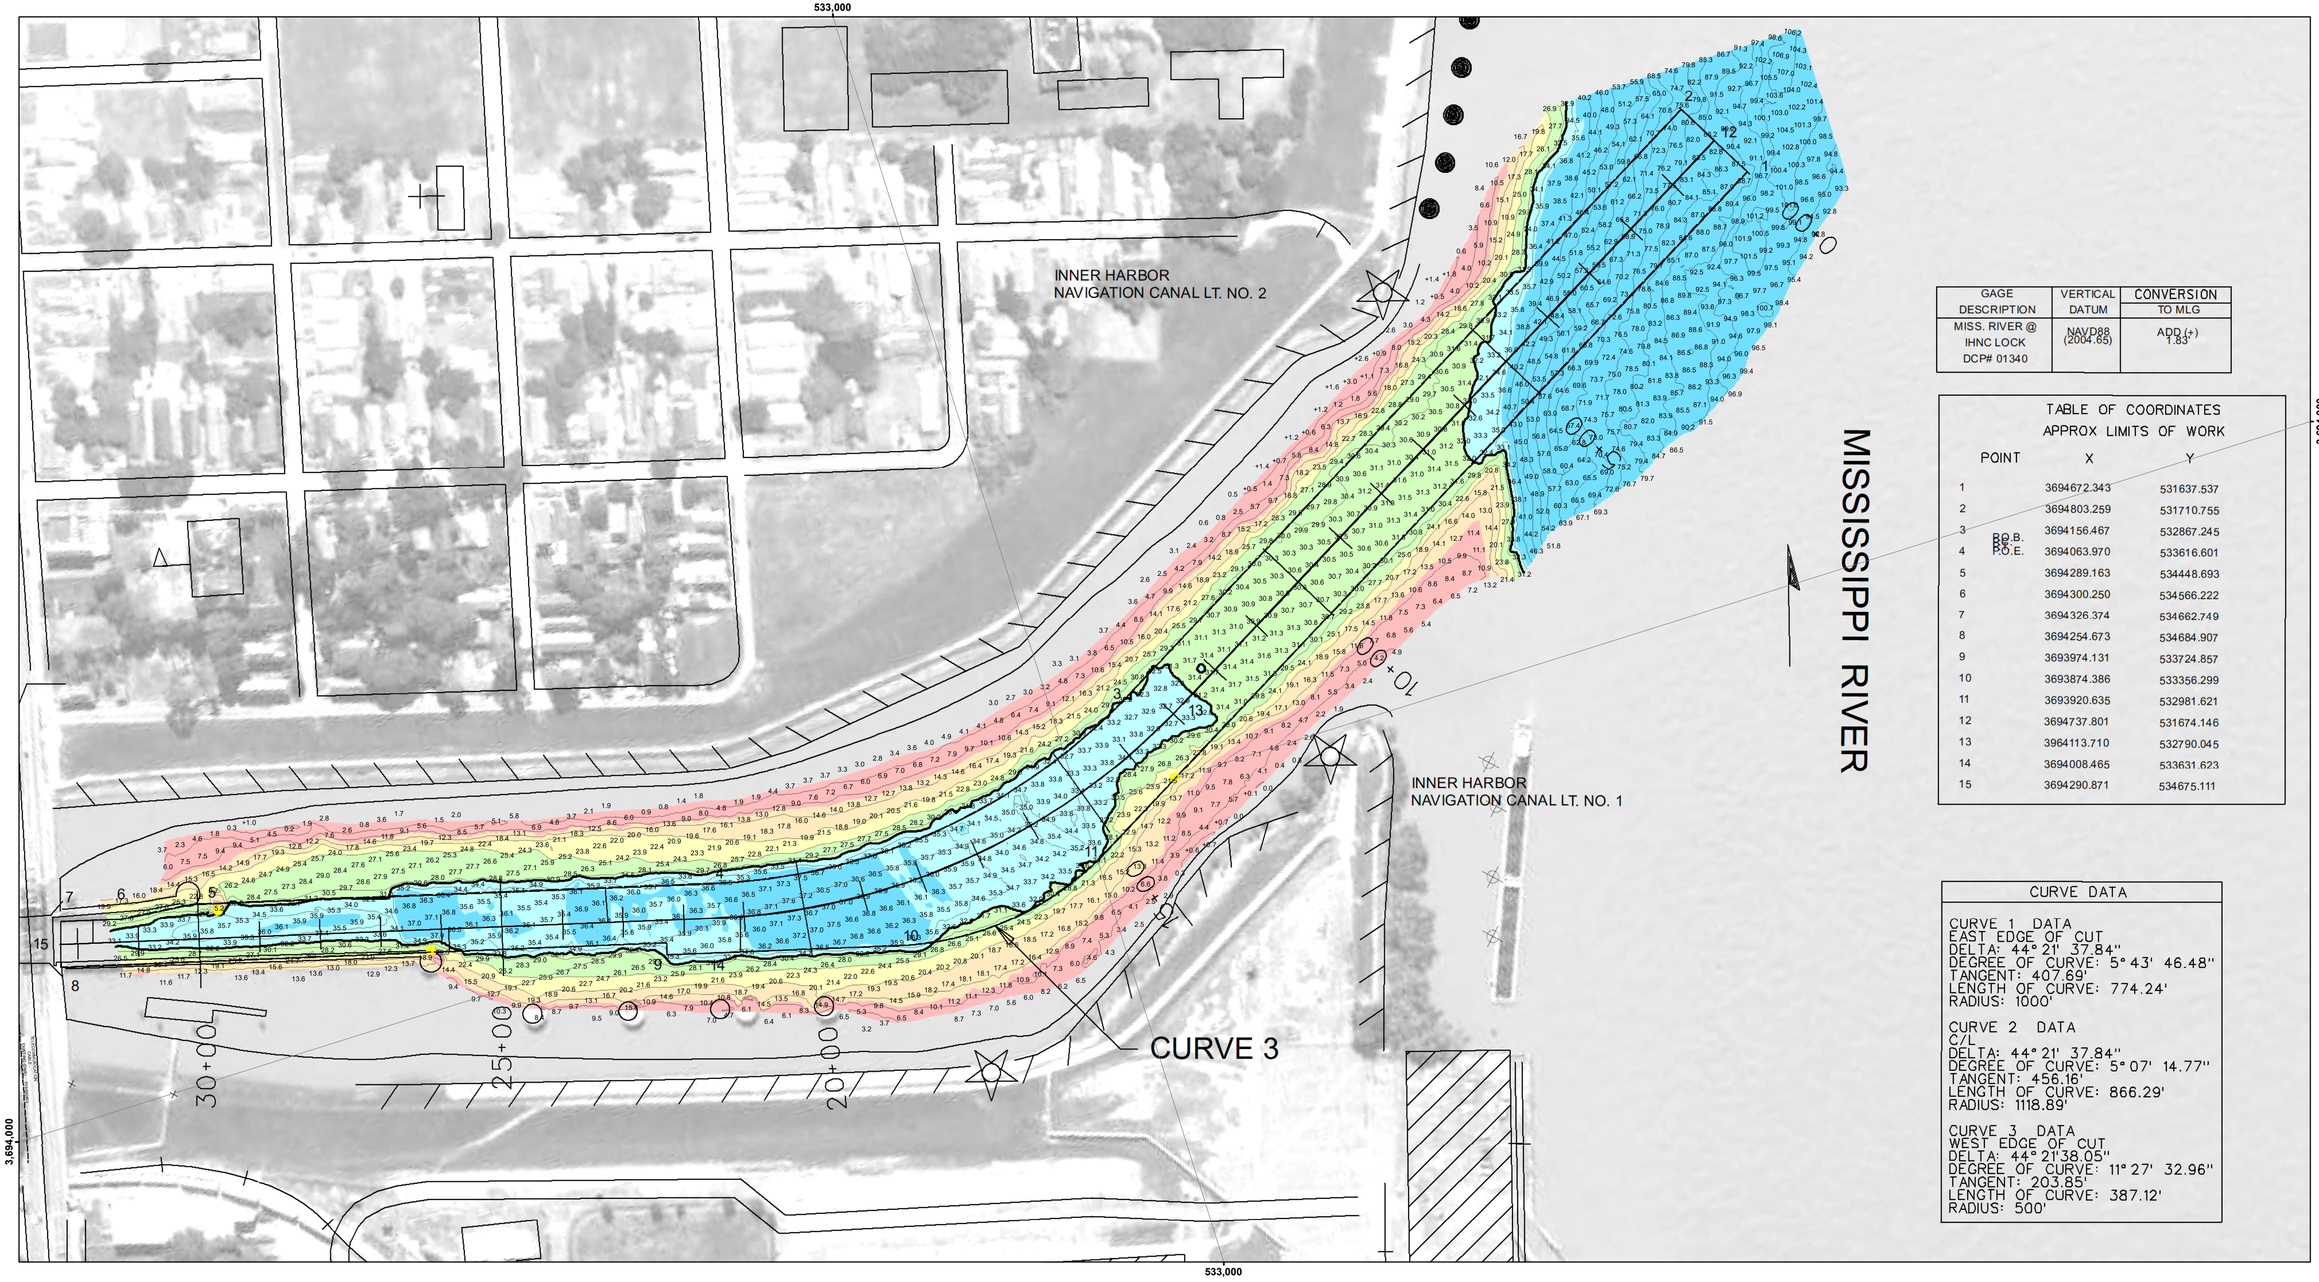

GAGE DESCRIPTION	VERTICAL DATUM	CONVERSION TO MLG
MISS. RIVER @ IHNC LOCK DCP# 01340	NAVD88 (2004.65)	ADD (+) 1.83'

TABLE OF COORDINATES
APPROX LIMITS OF WORK

POINT	X	Y
1	3694672.343	531637.537
2	3694803.259	531710.755
3	3694156.467	532867.245
4 P.O.B. P.O.E.	3694063.970	533616.601
5	3694289.163	534448.693
6	3694300.250	534566.222
7	3694326.374	534662.749
8	3694254.673	534684.907
9	3693974.131	533724.857
10	3693874.386	533356.299
11	3693920.635	532981.621
12	3694737.801	531674.146
13	3964113.710	532790.045
14	3694008.465	533631.623
15	3694290.871	534675.111

CURVE DATA

CURVE 1 DATA
EAST EDGE OF CUT
DELTA: 44° 21' 37.84"
DEGREE OF CURVE: 5° 43' 46.48"
TANGENT: 407.69'
LENGTH OF CURVE: 774.24'
RADIUS: 1000'

CURVE 2 DATA
C/L
DELTA: 44° 21' 37.84"
DEGREE OF CURVE: 5° 07' 14.77"
TANGENT: 456.16'
LENGTH OF CURVE: 866.29'
RADIUS: 1118.89'

CURVE 3 DATA
WEST EDGE OF CUT
DELTA: 44° 21'38.05"
DEGREE OF CURVE: 11° 27' 32.96"
TANGENT: 203.85'
LENGTH OF CURVE: 387.12'
RADIUS: 500'

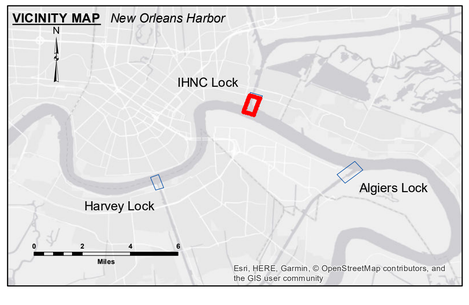

LEGEND

- Federal Navigation Channel
- Federal Navigation Center Line
- As-built Pipeline/Cable
- Unconfirmed Pipeline/Cable
- Project Depth Contour
- Cable Area
- Placement Area
- Anchorage Area
- Obstruction Point
- Wrecks-Submerged
- Placement Area
- Shoalest Sounding**
- Beacon, General
- Red Navigation Buoy
- Green Navigation Buoy
- -12' and above
- -12' to -20'
- -20' to -25'
- -25' to -32'
- -32' to -36'
- -36' and below

LWRP:	N/A
Gage Reading:	IHNC FB: 12.1 MLG
Sea Conditions:	CALM
Vessel Name:	M/V OB-169
Survey Type:	CONDITION VRS RTK
Sounding Frequency***:	400KHZ

Feet
0 200 400 600

NOTES:

Horizontal Coordinate System:
North American Datum of 1983 (NAD83), projected to the State Plane Coordinate System (SPCS), Louisiana South Zone. Distance units in U.S. Survey Feet.

Vertical Datum:
Soundings are shown in feet and indicate depths below Mean Low Gulf (MLG).

Distances on the Mississippi River, above and below Head of Passes are shown at 1 mile intervals.

The location of navigation aids are base on and provided by the U.S. Coast Guard and USACE crew.

2015 Aerial Photography data source: NAIP, USDA-FSA-APFO Aerial Photography Field Office.

Reference is N.O.A.A. Navigation Chart No. 11370.

** Shoalest Sounding per Quarter per Reach.

*** High frequency (200 kHz) survey data represents the first signal return at a sounding location and will include suspended solids, known as "fluff", if present. Low frequency (20 kHz) survey data normally penetrates through this "fluff" layer to depict elevations of consolidated bottom material. Low frequency accuracies may vary depending on channel conditions and fathometer settings.

US Army Corps of Engineers
District: CEMVN

DISCLAIMER:
Access Constraints: The United States Government furnishes these data and information on an "as is" basis. The recipient agrees that the US Government assumes no liability for the use of the data and information except as expressly stated herein, and neither warrants nor makes any other express or implied concerning the accuracy, completeness, reliability, or suitability for particular purpose of the data and information and the data furnished. The United States shall be under no liability whatsoever to any person by reason of any use made hereof, and the recipient agrees to indemnify and save the United States harmless from any claim based upon use of these data by anyone under the recipient's authority. The recipient fully agrees not to represent these data to anyone as other than data provided "as is" by the United States and to require this disclaimer be made a condition to any further dissemination of these data to others without also transferring this Disclaimer.

The information depicted on this map represents the results of a survey conducted on the date indicated and can only be considered to represent the general condition existing at this time.

Distribution Liability: The data represents the results of data collection activities conducted by the U.S. Army Corps of Engineers activity and indicates the general existing conditions. As such, it is only valid for its intended use, content, time and accuracy. The U.S. Army Corps of Engineers accepts no responsibility for any of any of the application of the data for other than its intended purpose.

Data Constraints: Hydrographic survey data is subject to change due to environmental conditions such as storm activity, sediment activity and natural shoaling and scouring processes. The U. S. Army Corps of Engineers accepts no responsibility for changes in the condition of the data that occur after the date of this publication. This data is intended for U. S. Army Corps of Engineers' internal use. Private businesses should not rely solely upon it.

U.S. ARMY CORPPS OF ENGINEERS
NEW ORLEANS DISTRICT

Surveyed By: SP_PM	Plotted By: AO	Checked By: AO	
Submitted:	Recommended: Chief Survey Section	Approved: Chief Waterways Maintenance Section	

MISSISSIPPI RIVER DEEP-DRAFT LOCKS
I.H.N.C. LOCK FOREBAY
LK_02_IHN_20181115_CS_5X5
15 November 2018

Sheet Reference Number
2 of 4

Revison Number:
3.12-20160811