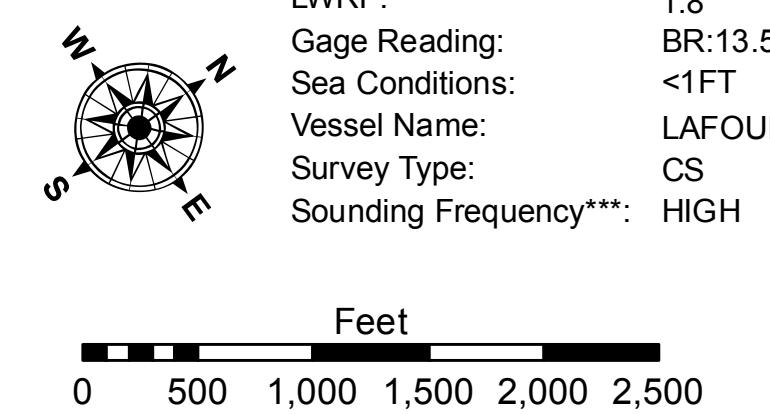


<u>LEGEND</u>																			
— Federal Navigation Channel	○ Cable Area																		
— Federal Navigation Center Line	■ Placement Area																		
— As-built Pipeline/Cable	□ Anchorage Area																		
..... Unconfirmed Pipeline/Cable	★ Beacon, General																		
— Project Depth Contour	☒ Obstruction Point																		
	◆ Red Navigation Buoy																		
	◆ Wrecks-Submerged																		
	<table border="1"> <tr> <td>Borrow Area</td> <td>0' and above</td> </tr> <tr> <td></td><td>0' to -5'</td></tr> <tr> <td></td><td>-5' to -10'</td></tr> <tr> <td></td><td>-10' to -20'</td></tr> <tr> <td></td><td>-20' to -30'</td></tr> <tr> <td></td><td>-30' to -35'</td></tr> <tr> <td></td><td>-35' to -40'</td></tr> <tr> <td></td><td>-40' to -45'</td></tr> <tr> <td></td><td>-45' and below</td></tr> </table>	Borrow Area	0' and above		0' to -5'		-5' to -10'		-10' to -20'		-20' to -30'		-30' to -35'		-35' to -40'		-40' to -45'		-45' and below
Borrow Area	0' and above																		
	0' to -5'																		
	-5' to -10'																		
	-10' to -20'																		
	-20' to -30'																		
	-30' to -35'																		
	-35' to -40'																		
	-40' to -45'																		
	-45' and below																		
	Shoalest Sounding**																		
	Beacon, General																		
	Obstruction Point																		
	Wrecks-Submerged																		

**NOTES:**

Horizontal Coordinate System:
North American Datum of 1983 (NAD83), projected to the State Plane
Coordinate System (SPCS), Louisiana South Zone. Distance units in U.S. Survey Feet.

Vertical Datum:
Soundings are shown in feet and indicate depths below Low Water Reference Plane 2007 (NAVD).
Distances on the Mississippi River, above and below Head of Passes are shown
at 1 mile intervals.

The location of navigation aids are base on and provided by the U.S. Coast Guard and USACE crew.
2015 Aerial Photography data source: NAIP, USDA-FSA-APFO Aerial Photography Field Office.
Reference is N.O.A.A. Navigation Chart No. 11370.

** Shoalest Sounding per Quarter per Reach.

*** High frequency (200 kHz) survey data represents the first signal return at a sounding
location and will include suspended solids, known as "fluff", if present. Low frequency (20 kHz)
survey data normally penetrates through this "fluff" layer to depict elevations of consolidated bottom
material. Low frequency accuracies may vary depending on channel conditions and fathometer
settings.

Sheet
Reference
Number

13 of 97

Revision Number:
4-20200420

US Army Corps of Engineers
District: CEMVN

Distribution liability: The data represents the results of data collection/processing by a specific US Army Corps of Engineers activity and indicates the general existing conditions as such. The user accepts the data "as is" without warranty or guarantee of any kind. The user is responsible for the results of any use of the data. Data Constraints: Hydrographic survey data is subject to change due to several factors including but not limited to dredging operations, subsidence, and coastal processes. The U.S. Army Corps of Engineers and several states including Alaska, California, Florida, Louisiana, and others have issued statements of caution regarding the use of hydrographic survey data. This data is intended for U.S. Army Corps of Engineers internal use. Private studies should not be based upon it.

DATA STATEMENT
DISCLAIMER
The United States Government furnishes these data and the recipient accepts and uses them with the express understanding that the U.S. Government makes no warranties, expressed or implied, concerning the accuracy, reliability, or fitness for a particular purpose. The United States shall not be liable for damages resulting from use of the data furnished. The United States shall be under no liability whatsoever to any person by reason of any use made of the data furnished. The recipient shall not resell the data to anyone else. The recipient may transfer the data to another person without prior written consent from the Government provided that the recipient agrees not to resell the data to anyone else. The recipient may transfer the data to others without prior written consent from the Government provided that the recipient agrees not to resell the data to anyone else. The information depicted on this map represents the results of a survey conducted on the date indicated and can only be considered to depict the general conditions existing at the time it was drawn. The data is intended for U.S. Army Corps of Engineers internal use. Private studies should not be based upon it.

MISSISSIPPI RIVER - B.R. TO GULF
BAYOU GOULA CROSSING
MD_13_GOU_20210810_CS
10 August 2021