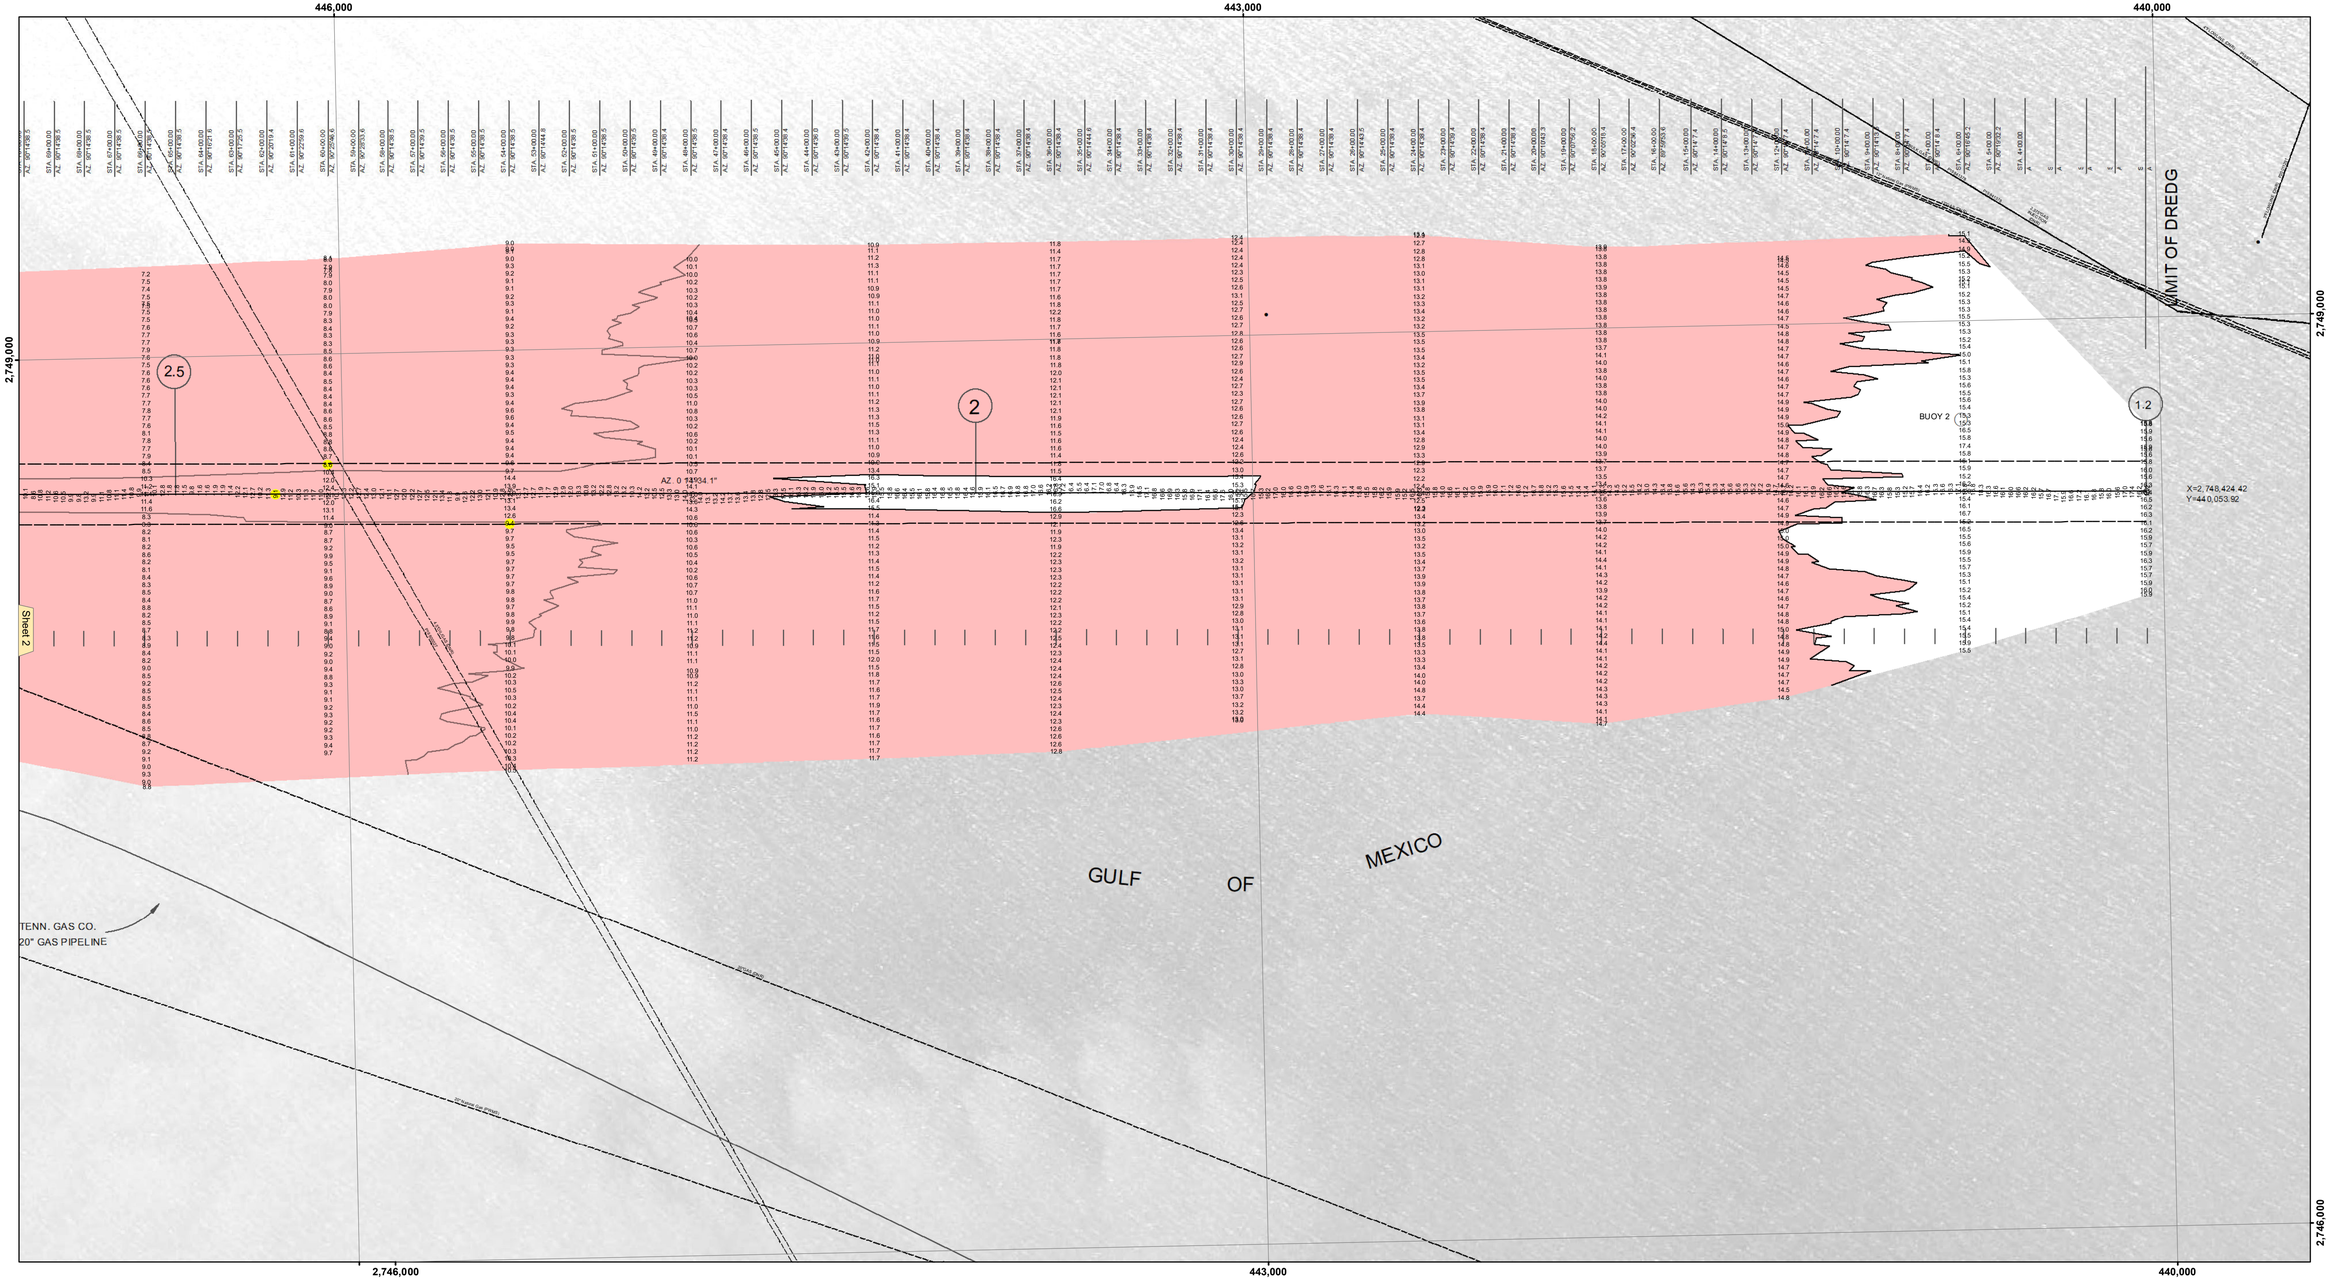

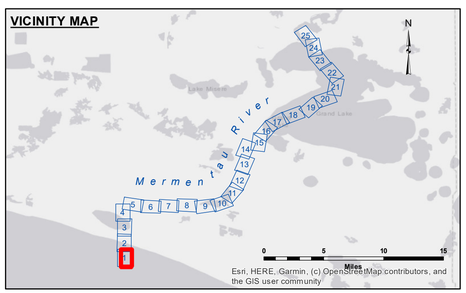

LEGEND

- Federal Navigation Channel
- Federal Navigation Center Line
- As-built Pipeline/Cable
- Unconfirmed Pipeline/Cable
- Project Depth Contour
- Cable Area
- Placement Area
- Anchorage Area
- Obstruction Point
- Wrecks-Submerged
- Borrow Area
- Shoalest Sounding**
- Beacon, General
- Red Navigation Buoy
- Green Navigation Buoy
- -15' and above
- -15' and below

Gage Reading:	RTK/VRS: 3.25 MLG
Sea Conditions:	CHOPPY
Vessel Name:	OB-167
Survey Type:	CONDITION
Sounding Frequency***:	LOW

Feet
0 500 1,000

NOTES:

Horizontal Coordinate System:
North American Datum of 1983 (NAD83), projected to the State Plane Coordinate System (SPCS), Louisiana South Zone. Distance units in U.S. Survey Feet.

Vertical Datum:
Soundings are shown in feet and indicate depths below Mean Low Gulf Datum (MLG).

The location of navigation aids are base on and provided by the U.S. Coast Guard.

2015 Aerial Photography data source: NAIP.

Reference is N.O.A.A. Navigation Chart No. 11344 and 11348.

** Shoalest Sounding per Quarter per Reach.

*** High frequency (200 kHz) survey data represents the first signal return at a sounding location and will include suspended solids, known as "fluff", if present. Low frequency (20 kHz) survey data normally penetrates through this "fluff" layer to depict elevations of consolidated bottom material. Low frequency accuracies may vary depending on channel conditions and fathometer settings.

US Army Corps of Engineers
District: CEMVN

Distribution Liability: The data represents the results of data collected by the U.S. Army Corps of Engineers activity and indicates the general existing condition. It is only valid for its intended use, content, time and accuracy of the data. The U.S. Army Corps of Engineers accepts no liability for any other use or application of the data for other than its intended purpose.

Data Constraints: Hydrographic survey data is subject to change due to environmental factors and human activity. The U.S. Army Corps of Engineers accepts no responsibility for changes in the data after the date of publication. This data is intended for U.S. Army Corps of Engineers' internal use. Private or commercial use is strictly prohibited.

DISCLAIMER
Access Constraints: The United States Government furnishes these data and the US Coast Guard uses them with the express understanding that they are intended for navigation purposes only, expressed or implied concerning the accuracy, completeness, reliability, or suitability of these data for any purpose. Navigation information and the data furnished. The United States shall be neither nor liability whatsoever to any person by reason of any use made thereof. Except for the sum paid, if any, by the recipient, the recipient fully agrees not to represent these data to anyone as other than a product of the United States Government. The recipient will make these data to others without also transferring this Disclaimer.

The information depicted on this map represents the results of a survey conducted on the date indicated and can only be considered as representing the general condition existing at that time.

U.S. ARMY CORPS OF ENGINEERS
NEW ORLEANS DISTRICT

Surveyed By:	SP, SR
Plotted By:	BD
Checked By:	AO
Submitted:	
Recommended:	Chief, Survey Section
Approved:	Chief, Waterways Maintenance Section

MERMENTAU RIVER
BAR CHANNEL
MM_01_BAR_20191120_CS
20 November 2019

Sheet Reference Number
1 **of** 25

Revison Number:
4.0-201907022