

#### **NOTES:**

Coordinate System:  
Datum of 1983 (NAD83), projected to the State Plane  
System (SPCS), Louisiana South Zone. Distance units in U.S. Survey Feet.

shown in feet and indicate depths below North American Vertical Datum of 1988

aviation aids are base on and provided by the

Photography data source: NAIP Louisiana

.A.A. Navigation Chart No. 11369.


ding per Quarter per Reach.

frequency (200 kHz) survey data represents the first signal return at a sounding and include suspended solids, known as "fluff", if present. Low frequency (20 kHz) usually penetrates through this "fluff" layer to depict elevations of consolidated bottom. Frequency accuracies may vary depending on channel conditions and fathometer

---



VICINITY MAP

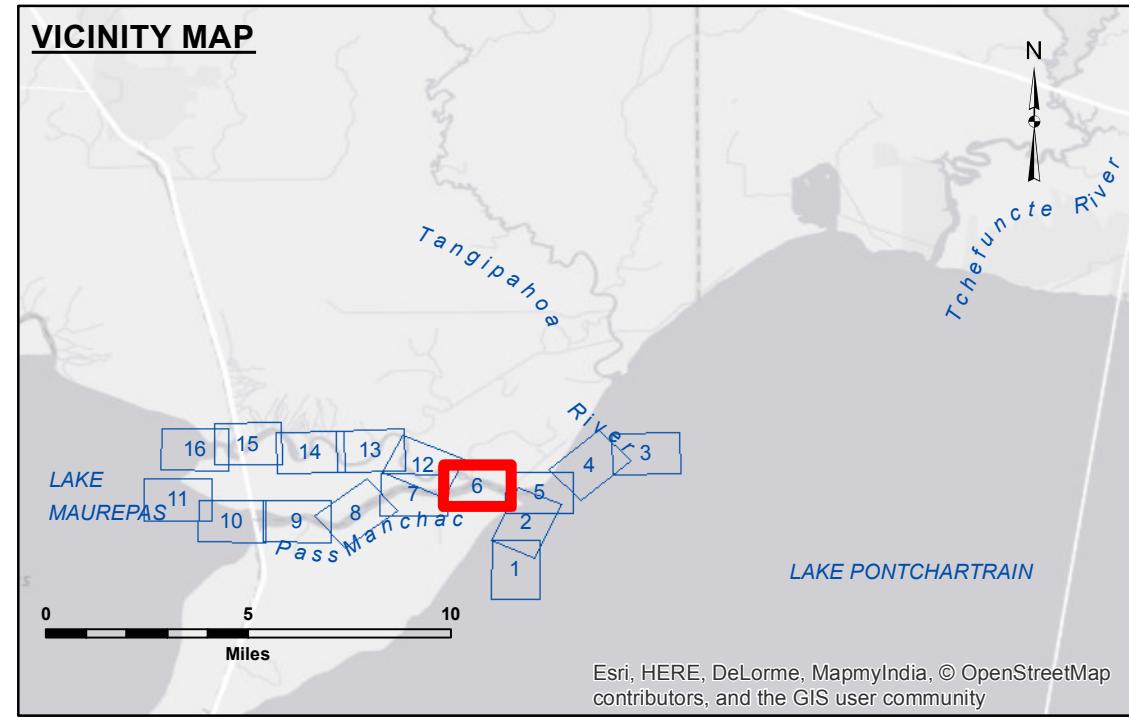

LEO

- Legend

— Federal Navigation Channel	○ ○	Cable Area	<span style="color: blue;">□</span> Borrow Area
— Federal Navigation Center Line	<span style="color: red;">□</span>	Placement Area	<span style="color: yellow;">●</span> Shoalest Sounding*
— As-built Pipeline/Cable	<span style="border: 1px dashed black;">□</span>	Anchorage Area	<span style="color: black;">★</span> Beacon, General
..... Unconfirmed Pipeline/Cable	<span style="color: gray;">⊗</span>	Obstruction Point	<span style="color: red;">◆</span> Red Navigation Buoy
— Project Depth Contour	<span style="color: black;">↗</span>	Wrecks-Submerged	<span style="color: green;">◆</span> Green Navigation Buoy

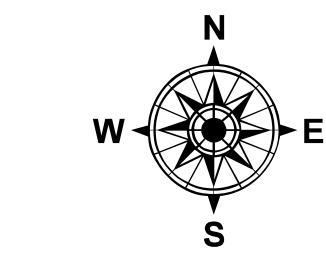


Gage Reading: PASS MANCHAC (85420): 1.5 NAVD  
Sea Conditions: CALM  
Vessel Name: OB-167  
Survey Type: CONDITION  
Sounding Frequency\*\*\*: LOW

Feet

0            500            1,000            1,500

She  
Refer  
Num  
6 of

Revision M

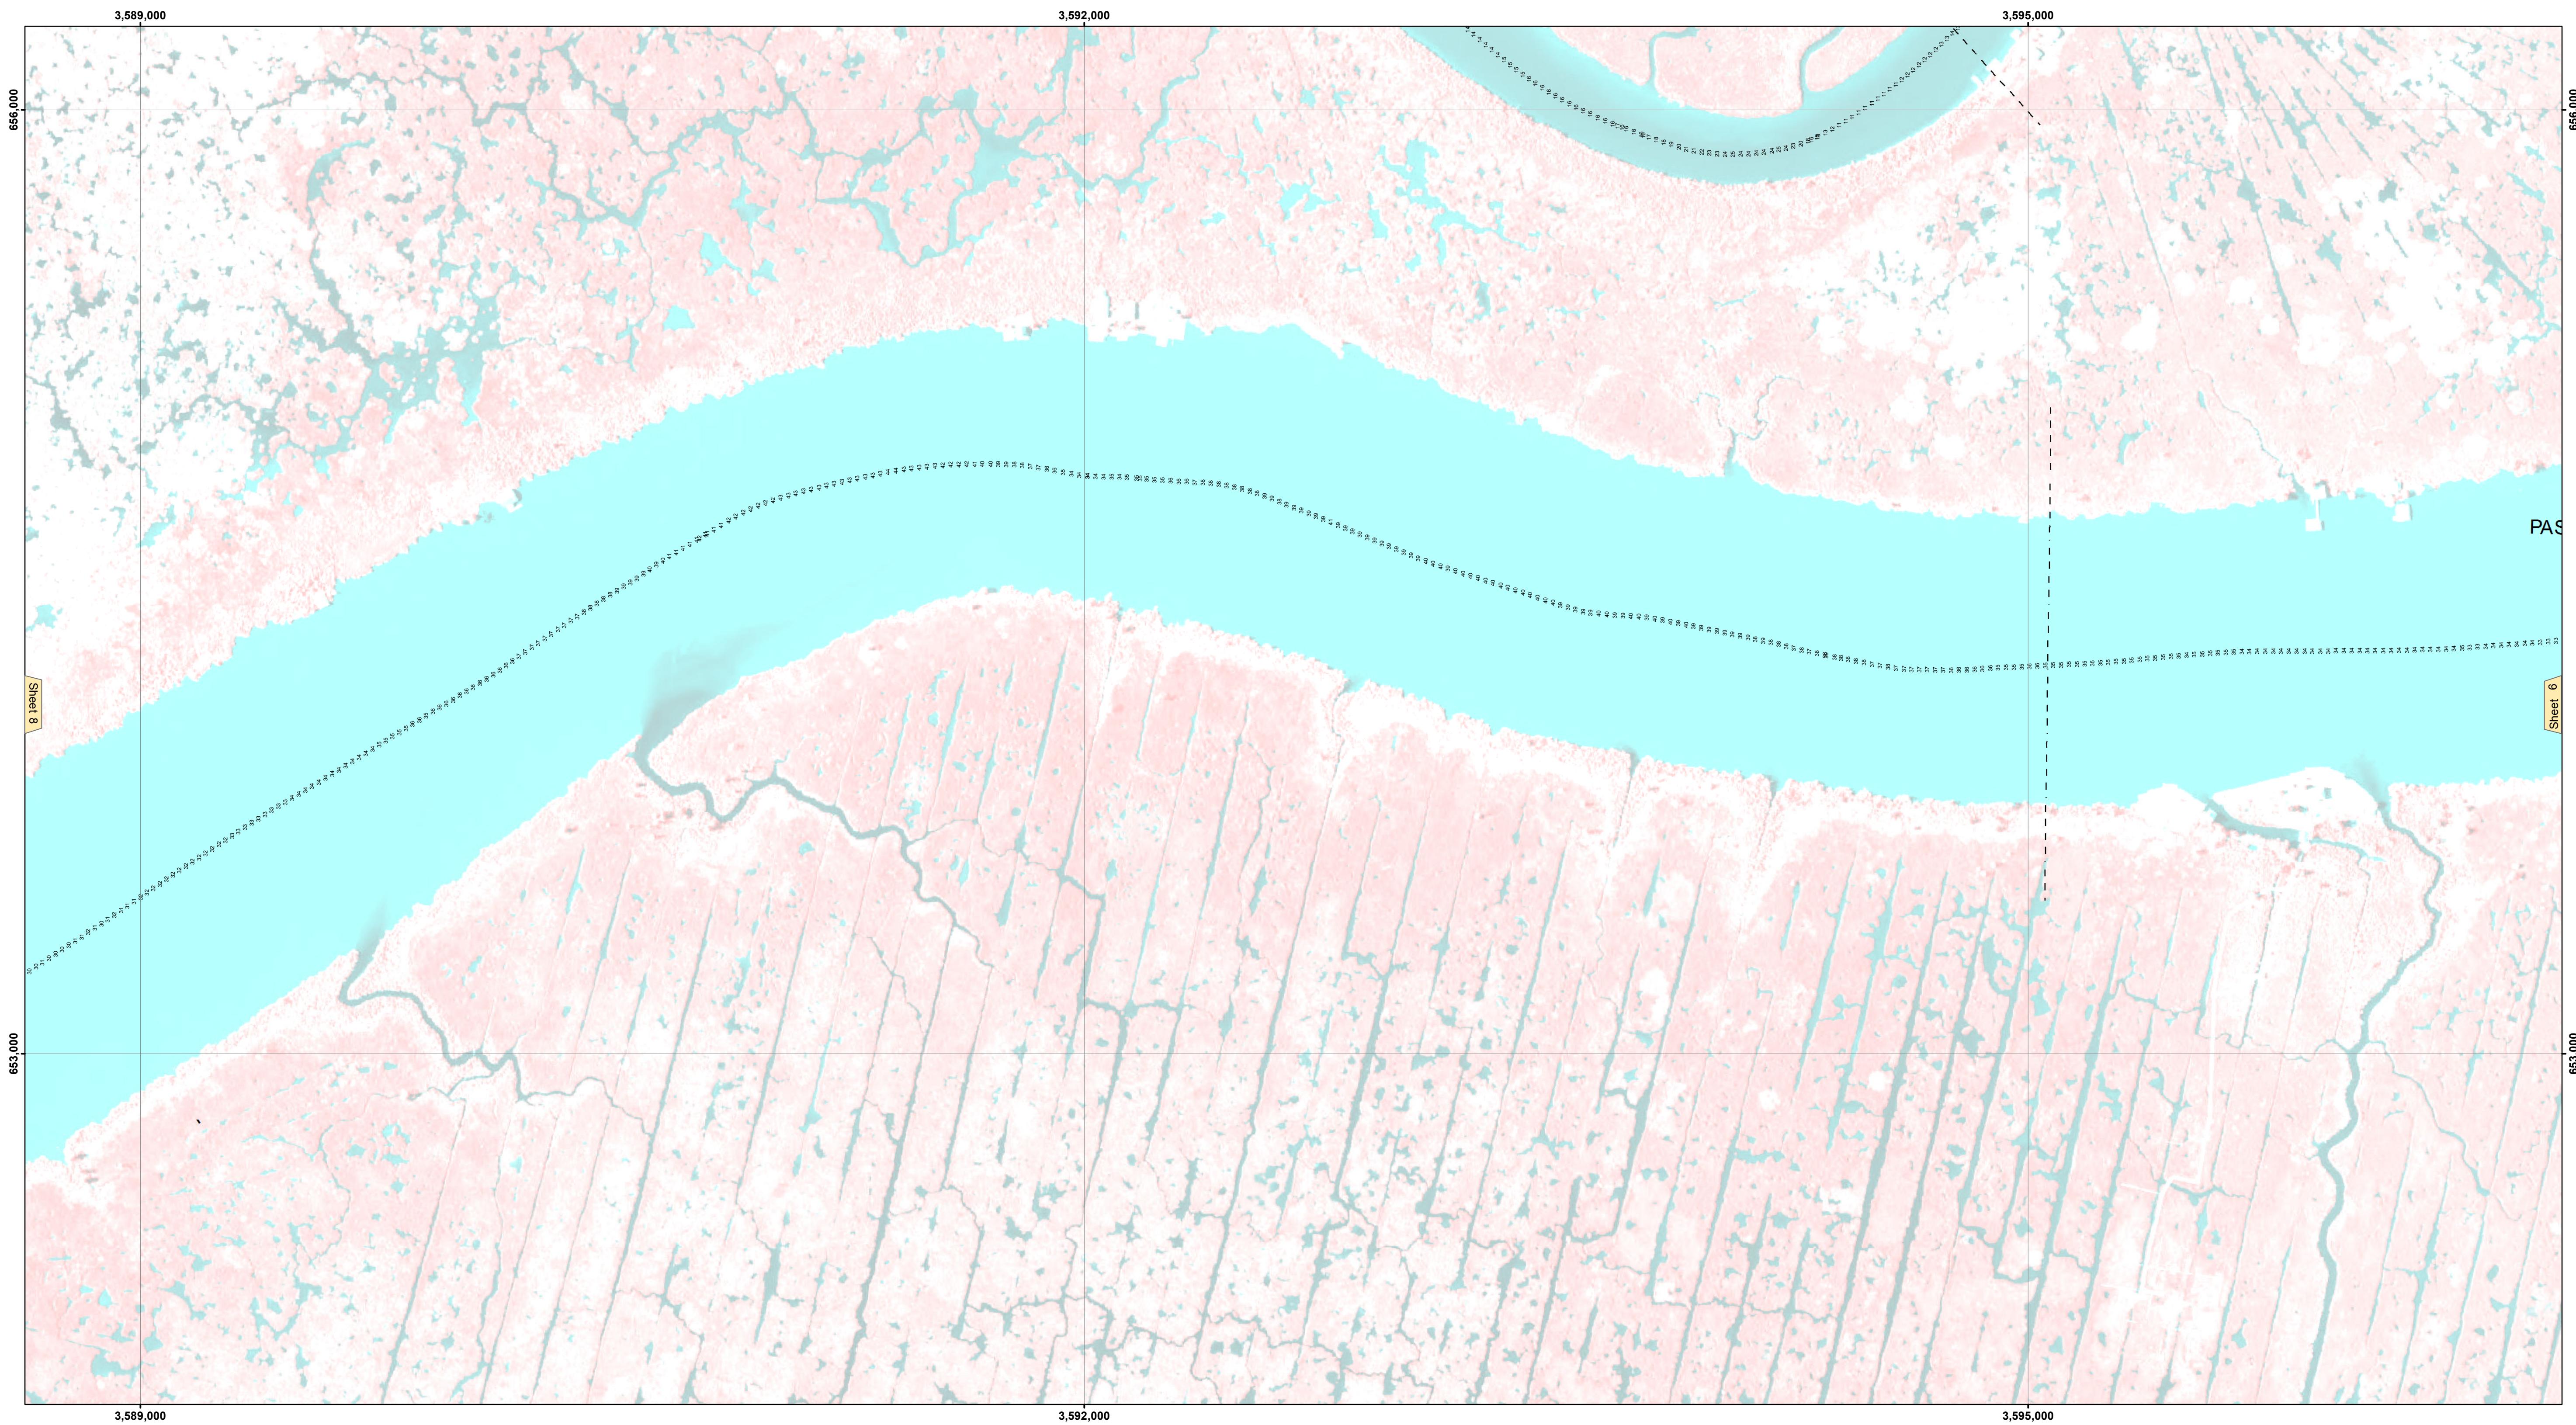

#### **OTES:**


State System:  
Datum of 1983 (NAD83), projected to the State Plane  
Coordinate System (SPCS) Louisiana South Zone. Distance units in U.S. Survey Feet

wn in feet and indicate depths below North American Vertical Datum of 1988

igation aids are base on and provided by the


(200 kHz) survey data represents the first signal return at a sounding  
clude suspended solids, known as "fluff", if present. Low frequency (20 kHz)  
ly penetrates through this "fluff" layer to depict elevations of consolidated bottom  
frequency accuracies may vary depending on channel conditions and fathometer

## VICINITY MAP

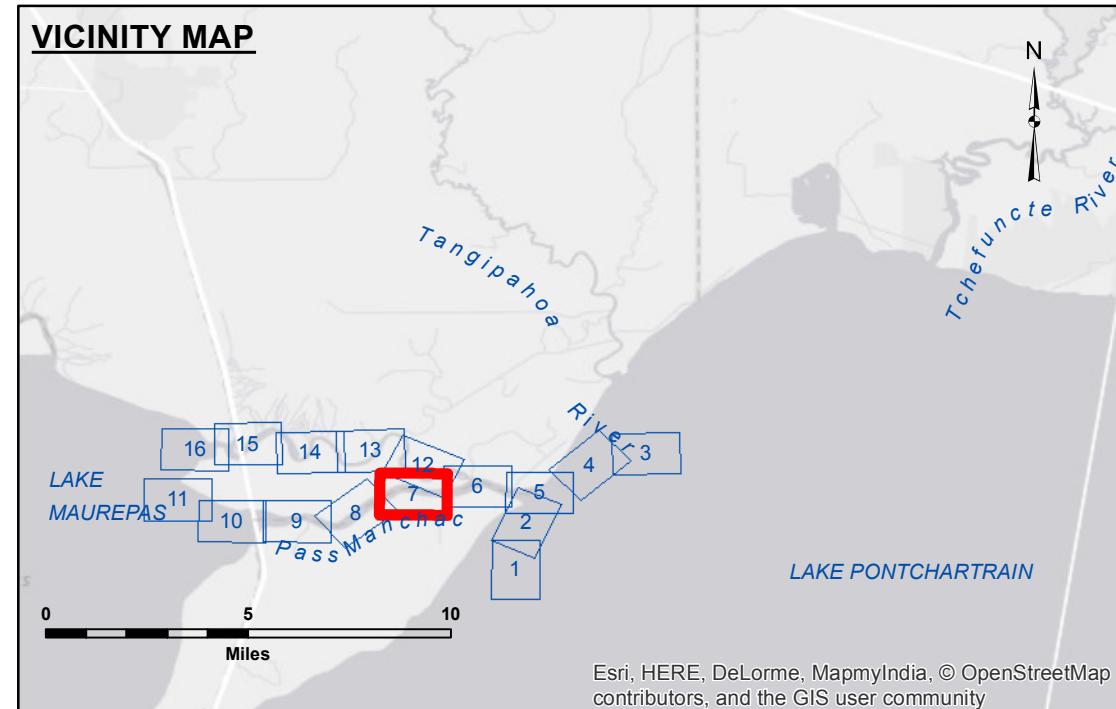


L

- Federal Navigation Channel
  - Federal Navigation Center Line
  - As-built Pipeline/Cable
  - ..... Unconfirmed Pipeline/Cable
  - Project Depth Contour
  - ○ Cable Area
  - Placement Area
  - Anchorage Area
  - ⊗ Obstruction Point
  - ↗ Wrecks-Submerged
  - Borrow Area
  - Shoalest Sounding\*\*
  - ★ Beacon, General
  - ◆ Red Navigation Buoy
  - ◆ Green Navigation Buoy

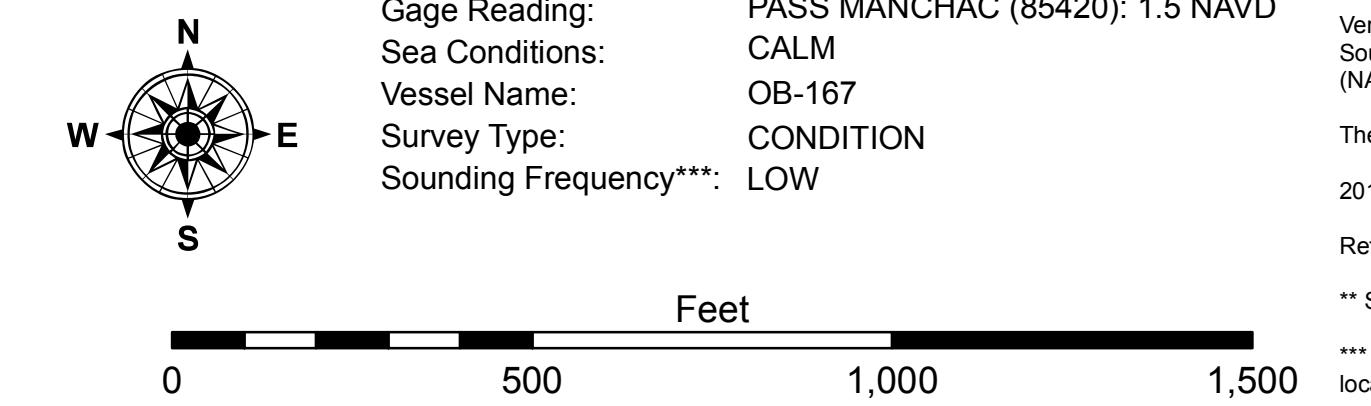

Gage Reading: PASS MANCHAC (85420): 1.5 NAVD  
Sea Conditions: CALM  
Vessel Name: OB-167  
Survey Type: CONDITION  
Sounding Frequency\*\*\*: LOW

Sheet  
Referen  
Numm  
7 of 1

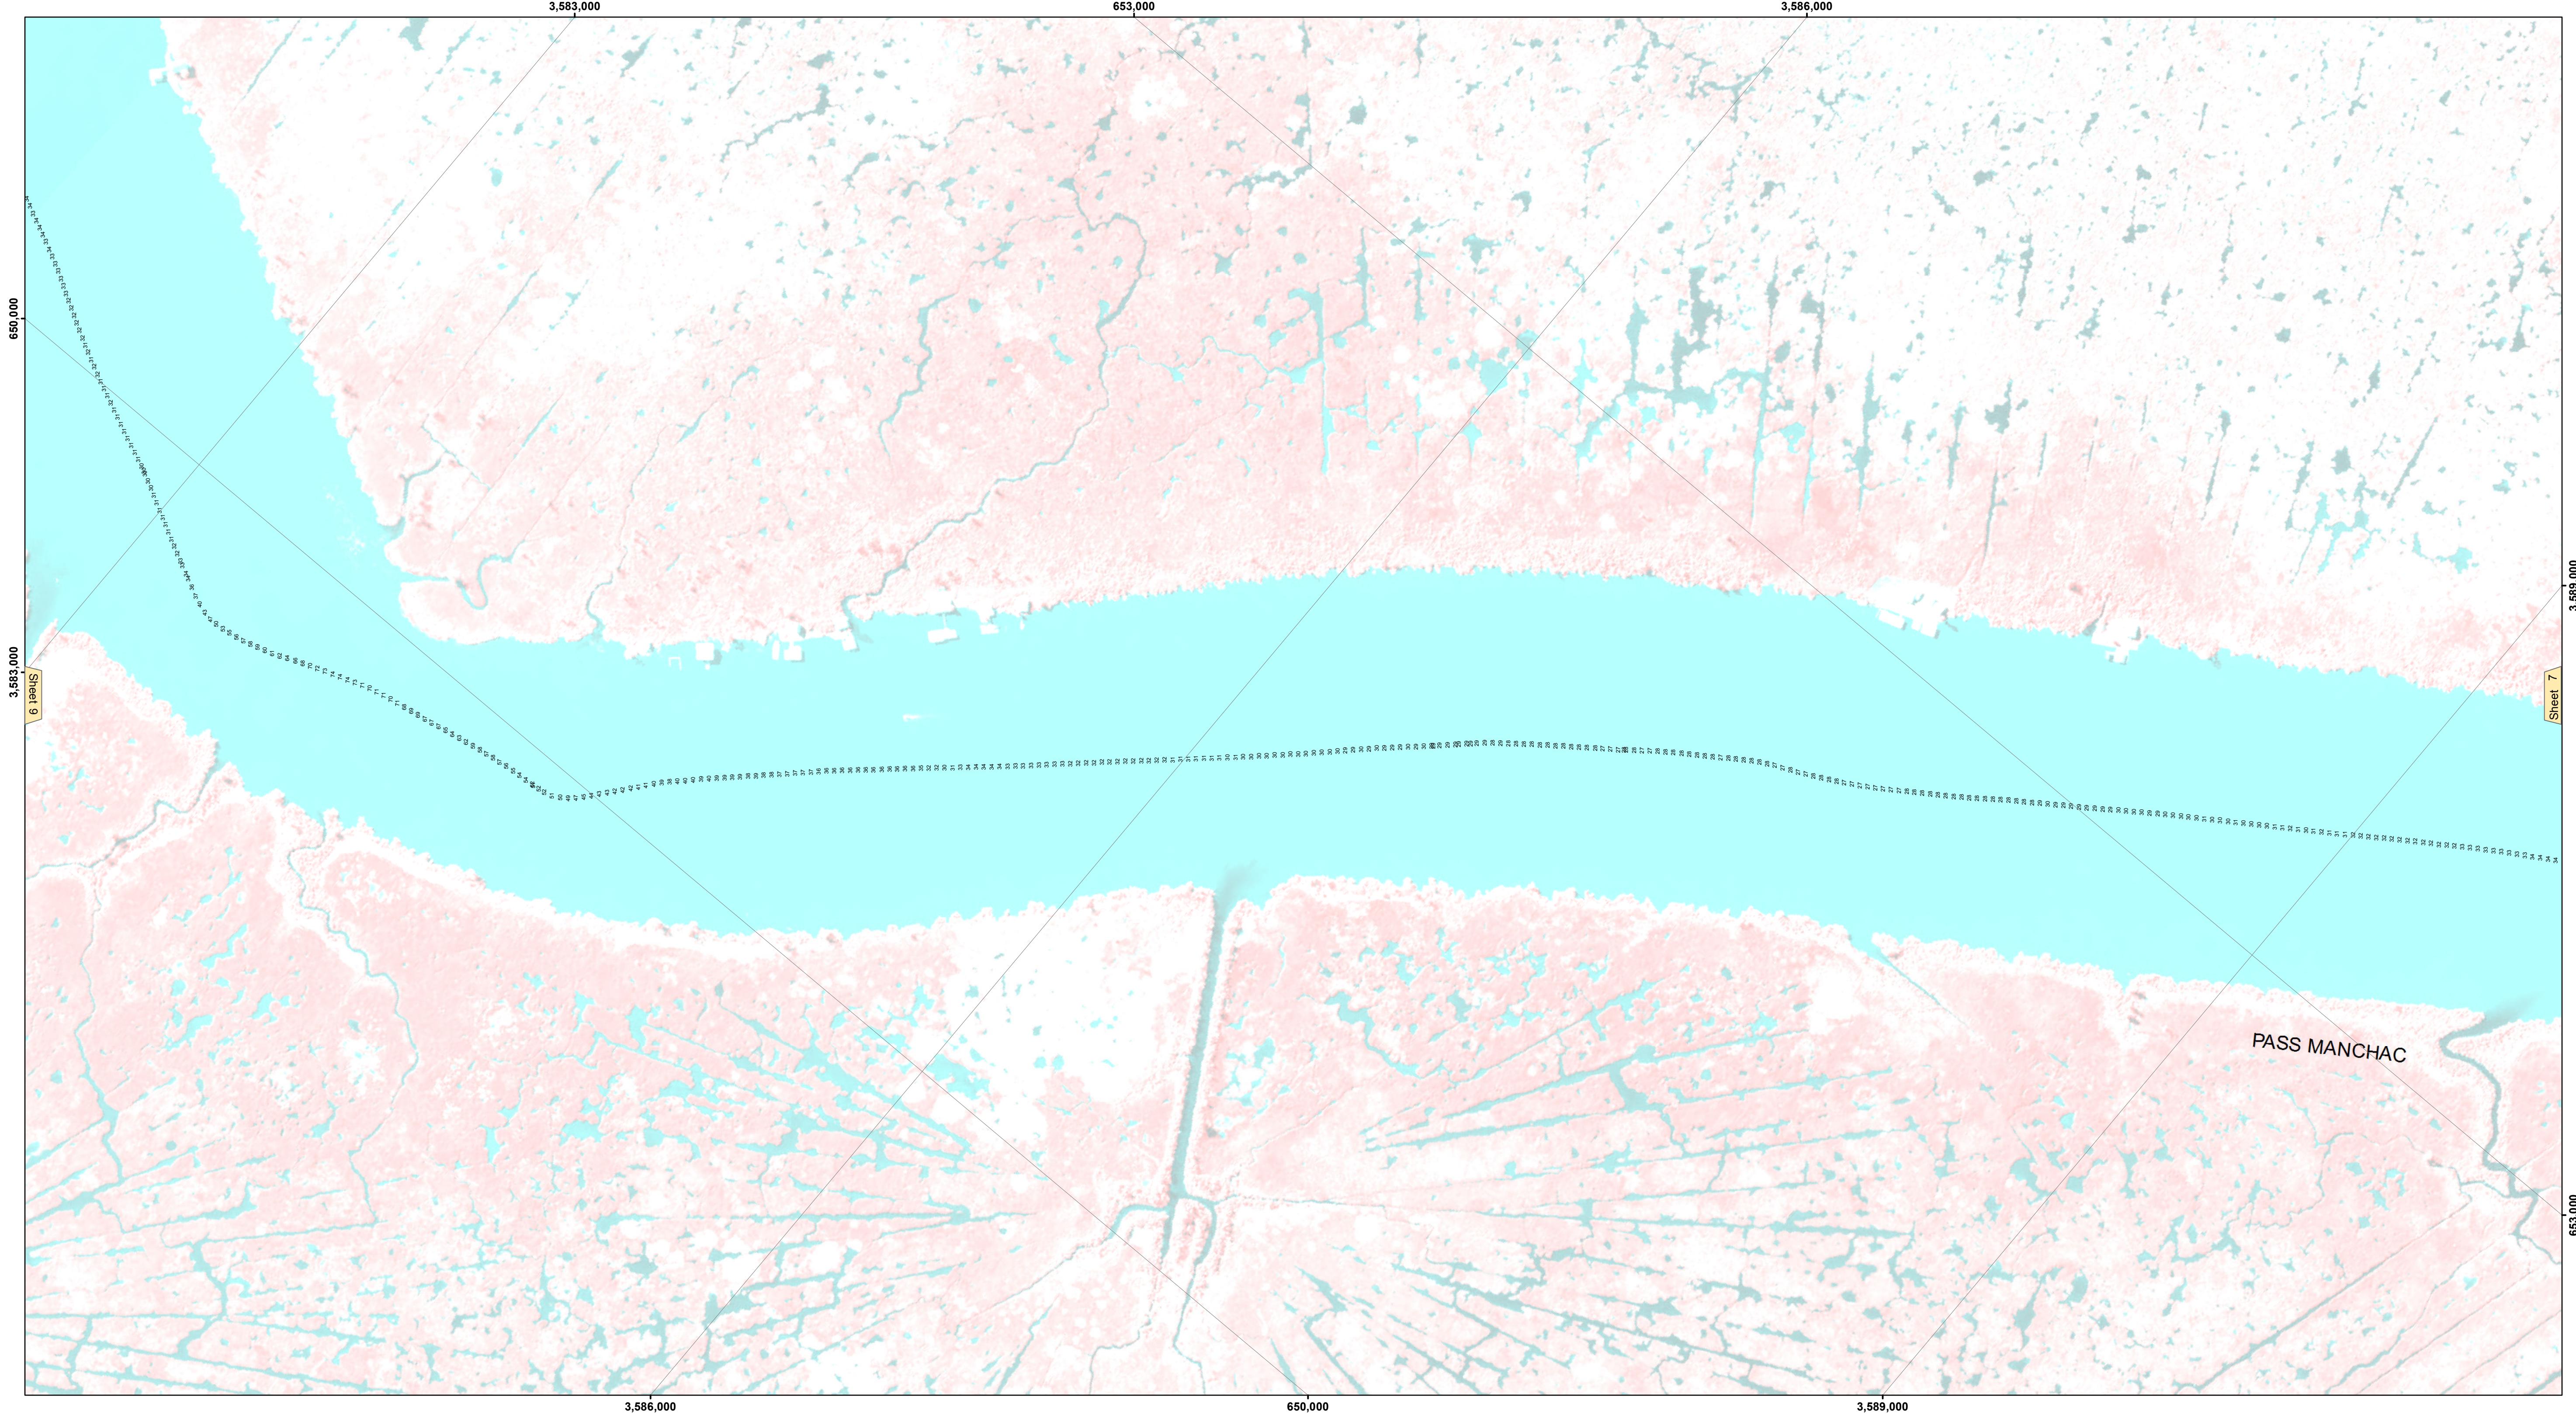

## NOTES:

Horizontal Coordinate System:  
North American Datum of 1983 (NAD83), projected to the State Plane  
Coordinate System (SPCS), Louisiana South Zone. Distance units in U.S. Survey Feet.

Vertical Datum:  
Elevations are shown in feet and indicate depths below North American Vertical Datum of 1988 (NAVD88).

The location of navigation aids are base on and provided by the

The location of navigation aids are base on and provided by the U.S. Coast Guard.

10 Aerial Photography data source: NAIP Louisiana.

ference is N.O.A.A. Navigation Chart No. 11369.

Shoalest Sounding per Quarter per Reach.

High frequency (200 kHz) survey data represents the first signal return at a sounding station and will include suspended solids, known as "fluff", if present. Low frequency (20 kHz) survey data normally penetrates through this "fluff" layer to depict elevations of consolidated bottom material. Low frequency accuracies may vary depending on channel conditions and fathometer settings.


**VICINITY MAP**

This map shows the Vicinity Map of the Lake Maurepas and Lake Pontchartrain area. The map includes the Tangipahoa River, Tchefuncte River, and Lake Pontchartrain. Numbered locations 1 through 16 are marked along the water bodies and river. A red box highlights location 8, which is labeled "Pass Manchac". A scale bar indicates distances up to 10 miles.


Scale: 0, 5, 10 Miles

Esri, HERE, DeLorme, MapmyIndia, © OpenStreetMap contributors, and the GIS user community

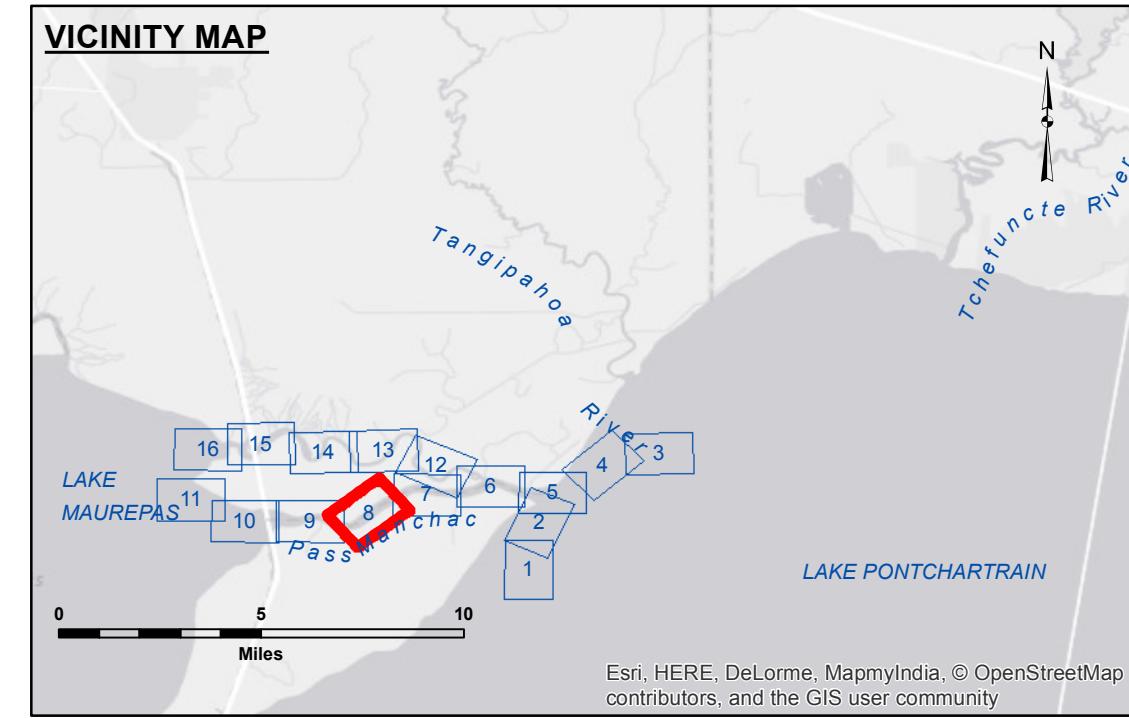


## **VICINITY MAP**

Esri, HERE, DeLorme, MapmyIndia, © OpenStreetMap contributors, and the GIS user community

LE

- |       |                                | <u>Legend</u> |                     |
|-------|--------------------------------|---------------|---------------------|
| ---   | Federal Navigation Channel     | ○ ○           | Cable Area          |
| —     | Federal Navigation Center Line | □             | Placement Area      |
| —     | As-built Pipeline/Cable        | □□            | Anchorage Area      |
| ..... | Unconfirmed Pipeline/Cable     | ⊗             | Obstruction Point   |
| —     | Project Depth Contour          | ★             | Wrecks-Submerged    |
|       |                                | □             | Borrow Area         |
|       |                                | ●             | Shoalest Sounding** |
|       |                                | ★             | Beacon, General     |
|       |                                | ◆             | Red Navigation Buoy |
|       |                                | ◆             | Green Navigation Bu |

  Gage Reading: PASS MANCHAC (85420): 1.5 NAVD  
Sea Conditions: CALM  
Vessel Name: OB-167  
Survey Type: CONDITION  
Sounding Frequency\*\*\*: LOW


\*\* See notes.

\*\*\*  
S 700 1,000 1,500


Sun  
ma

Sheet  
Referen  
Numm  
8 of 1

Revision Number  
3.8.0.2015020

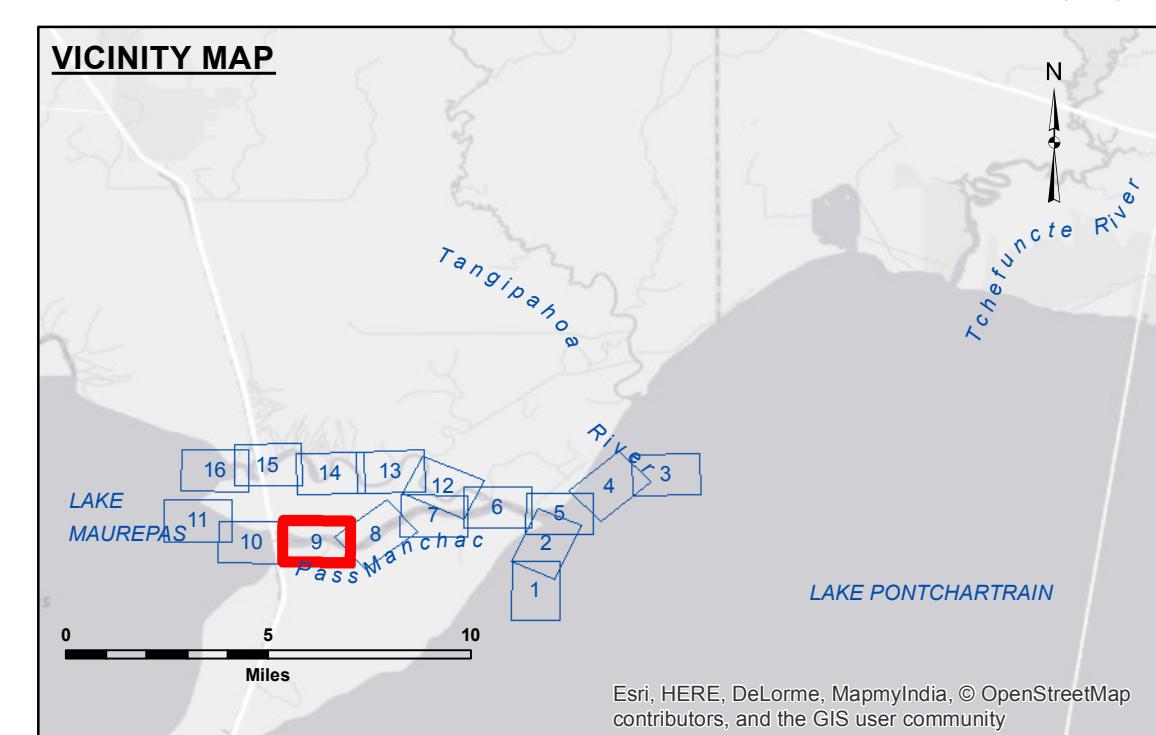

<b>LEGEND</b>	
— Federal Navigation Channel	○ Cable Area
— Federal Navigation Center Line	■ Placement Area
— As-built Pipeline/Cable	□ Anchorage Area
..... Unconfirmed Pipeline/Cable	⊗ Obstruction Point
— Project Depth Contour	★ Beacon, General
	◆ Red Navigation Buoy
	◆ Green Navigation Buoy
	✗ Wrecks-Submerged

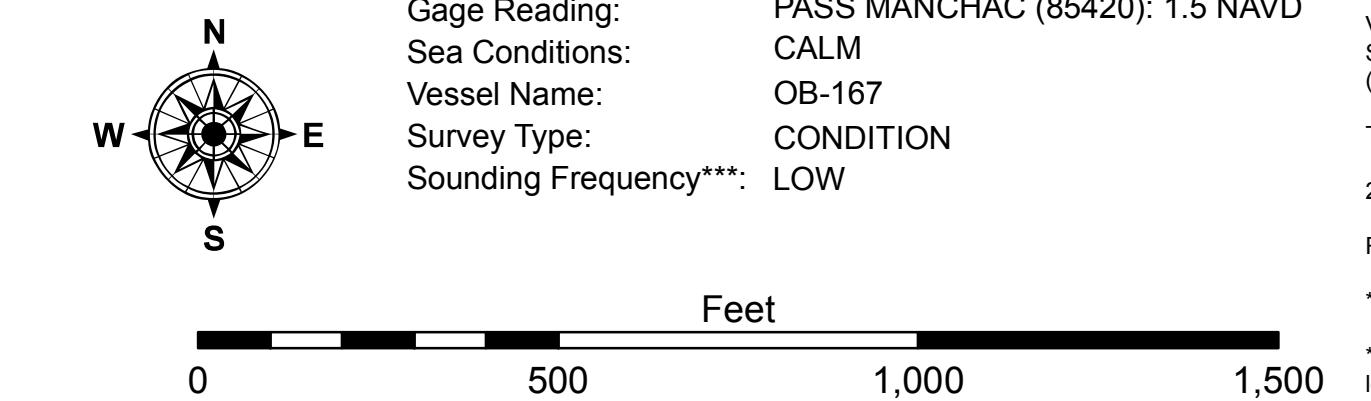

Gage Reading: PASS MANCHAC (85420): 1.5 NAVD  
Sea Conditions: CALM  
Vessel Name: OB-167  
Survey Type: CONDITION  
Sounding Frequency\*\*\*: LOW

**NOTES:**  
Horizontal Coordinate System:  
North American Datum of 1983 (NAD83), projected to the State Plane  
Coordinate System (SPCS), Louisiana South Zone. Distance units in U.S. Survey Feet.  
Vertical Datum:  
Soundings are shown in feet and indicate depths below North American Vertical Datum of 1988  
(NAVD88).

The location of navigation aids are base on and provided by the U.S. Coast Guard.  
2010 Aerial Photography data source: NAIP Louisiana.

Reference is N.O.A.A. Navigation Chart No. 11369.

\*\* Shoalest Sounding per Quarter per Reach.

\*\*\* High frequency (200 kHz) survey data represents the first signal return at a sounding  
location and will include suspended solids, known as "fuzz" if present. Low frequency (20 kHz)  
survey data normally penetrates through this "fuzz" layer to depict elevations of consolidated bottom  
material. Low frequency accuracies may vary depending on channel conditions and fathometer  
settings.

**Sheet  
Reference  
Number**  
**9 of 16**





Revision Number:  
3.8.0-20150202



**DISCLAIMER**  
Distribution liability: The data represents the results of data collection processing by a specific US Army Corps of Engineers activity and includes the general accuracy and uses them with the express understanding that the US Government makes no warranties, expressed or implied, concerning the data or its use. The data is provided "as is" without any guarantee of completeness, accuracy, reliability, usability or suitability for any particular purpose. The United States shall be liable only for damages resulting from the use of the data as a result of negligent acts or omissions on the part of the United States. The user is responsible for the results of any application of the data to other than its intended purpose.  
Data Constraints: Hydrographic survey data is subject to change rapidly due to several factors including but not limited to dredging operations, changes in river bed material, subsidence, and changes in the hydrographic conditions which develop after the date of publication. The user is responsible for keeping the data current. The Army Corps of Engineers does not assume responsibility for changes in the hydrographic conditions which develop after the date of publication. The data is intended for U.S. Army Corps of Engineers internal use and should not be used open to the general public or considered reliable unless the government condition existing at the time it was issued.

U.S. ARMY CORPS OF ENGINEERS NEW ORLEANS DISTRICT	
Surveyed By:	SPM
Submitted:	
Projected By:	AO
Recommended:	Chief Survey Section
Approved:	Chief Waterways Maintenance Section
Checked By:	RIN

**NORTHSORE WATERWAYS  
PASS MANCHAC / NORTH PASS  
NS\_07\_MAN\_20160414\_PM**  
14 April 2016

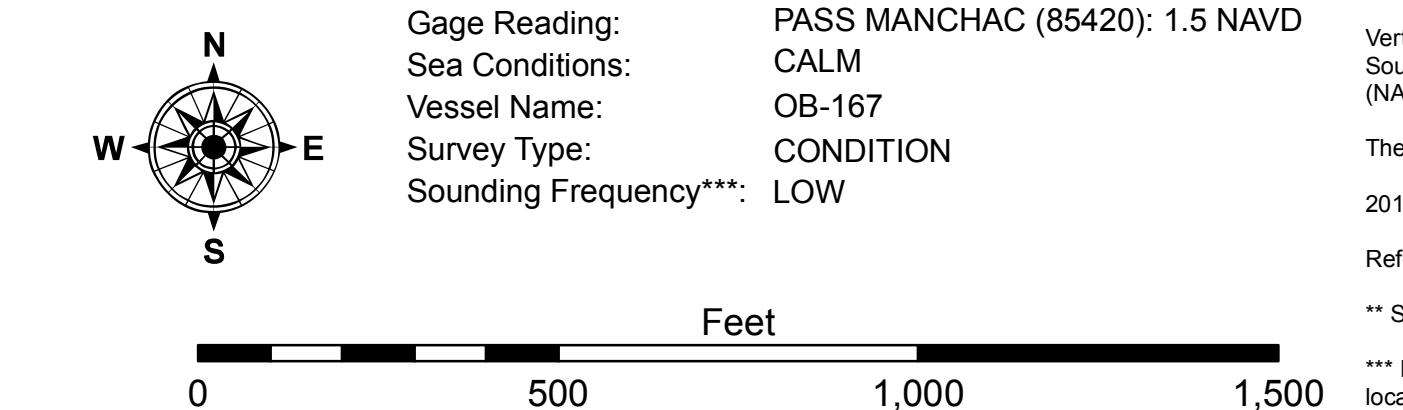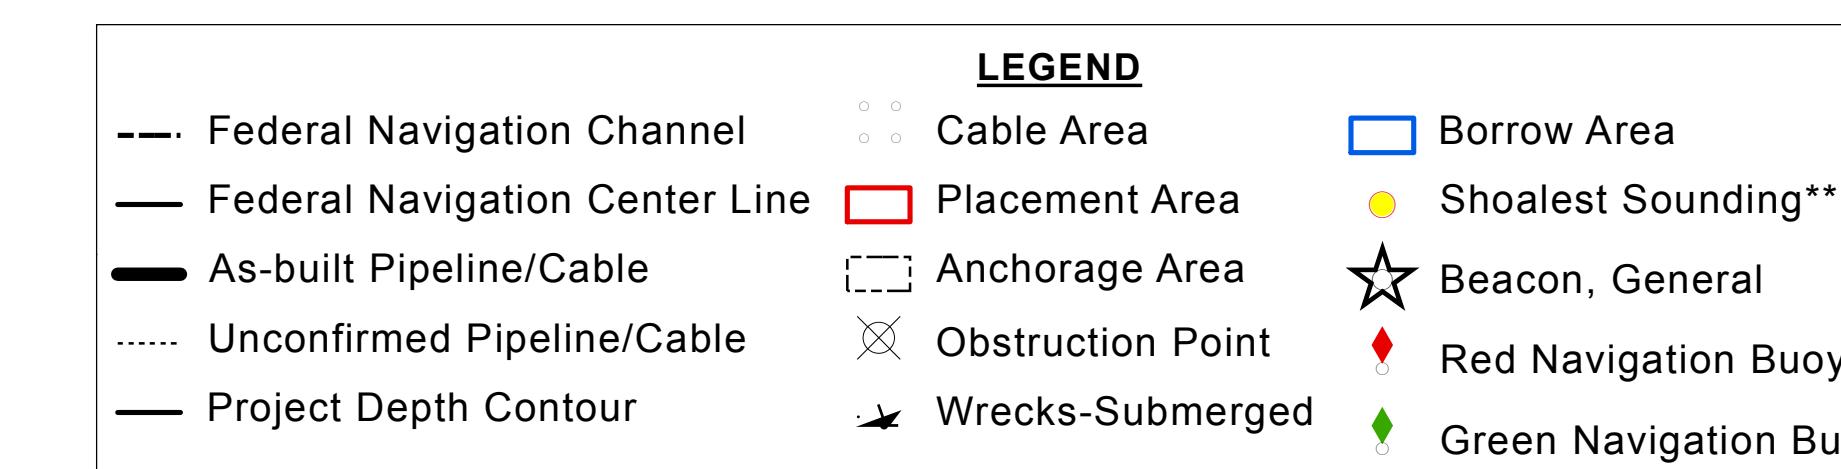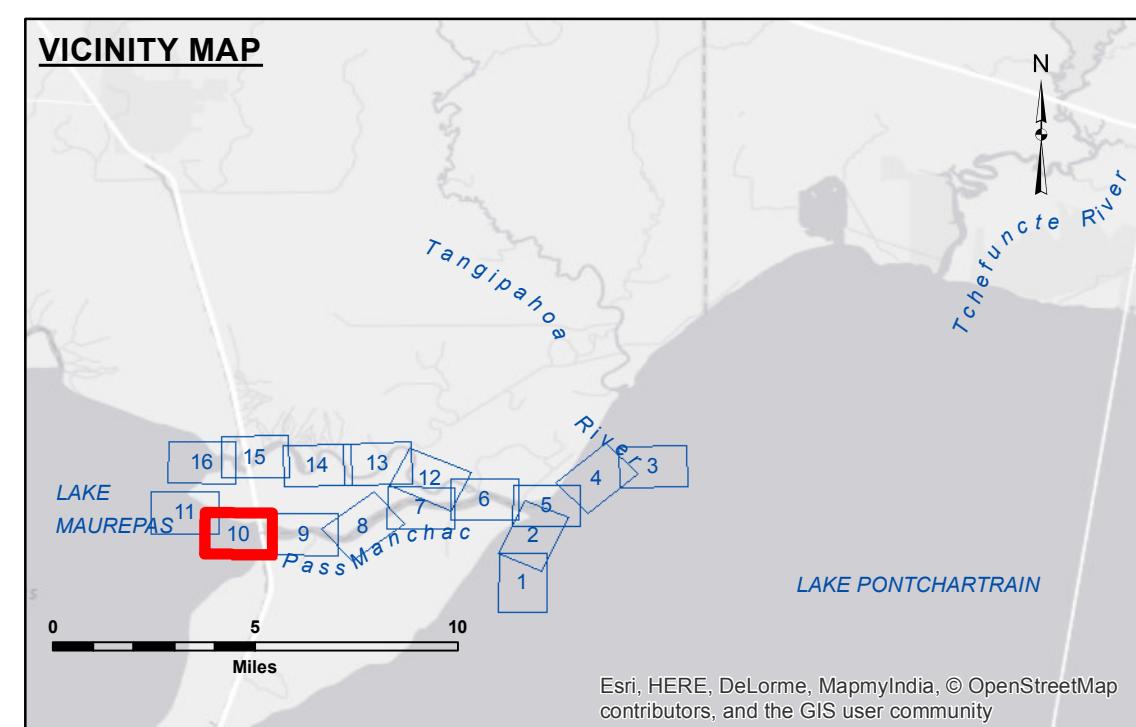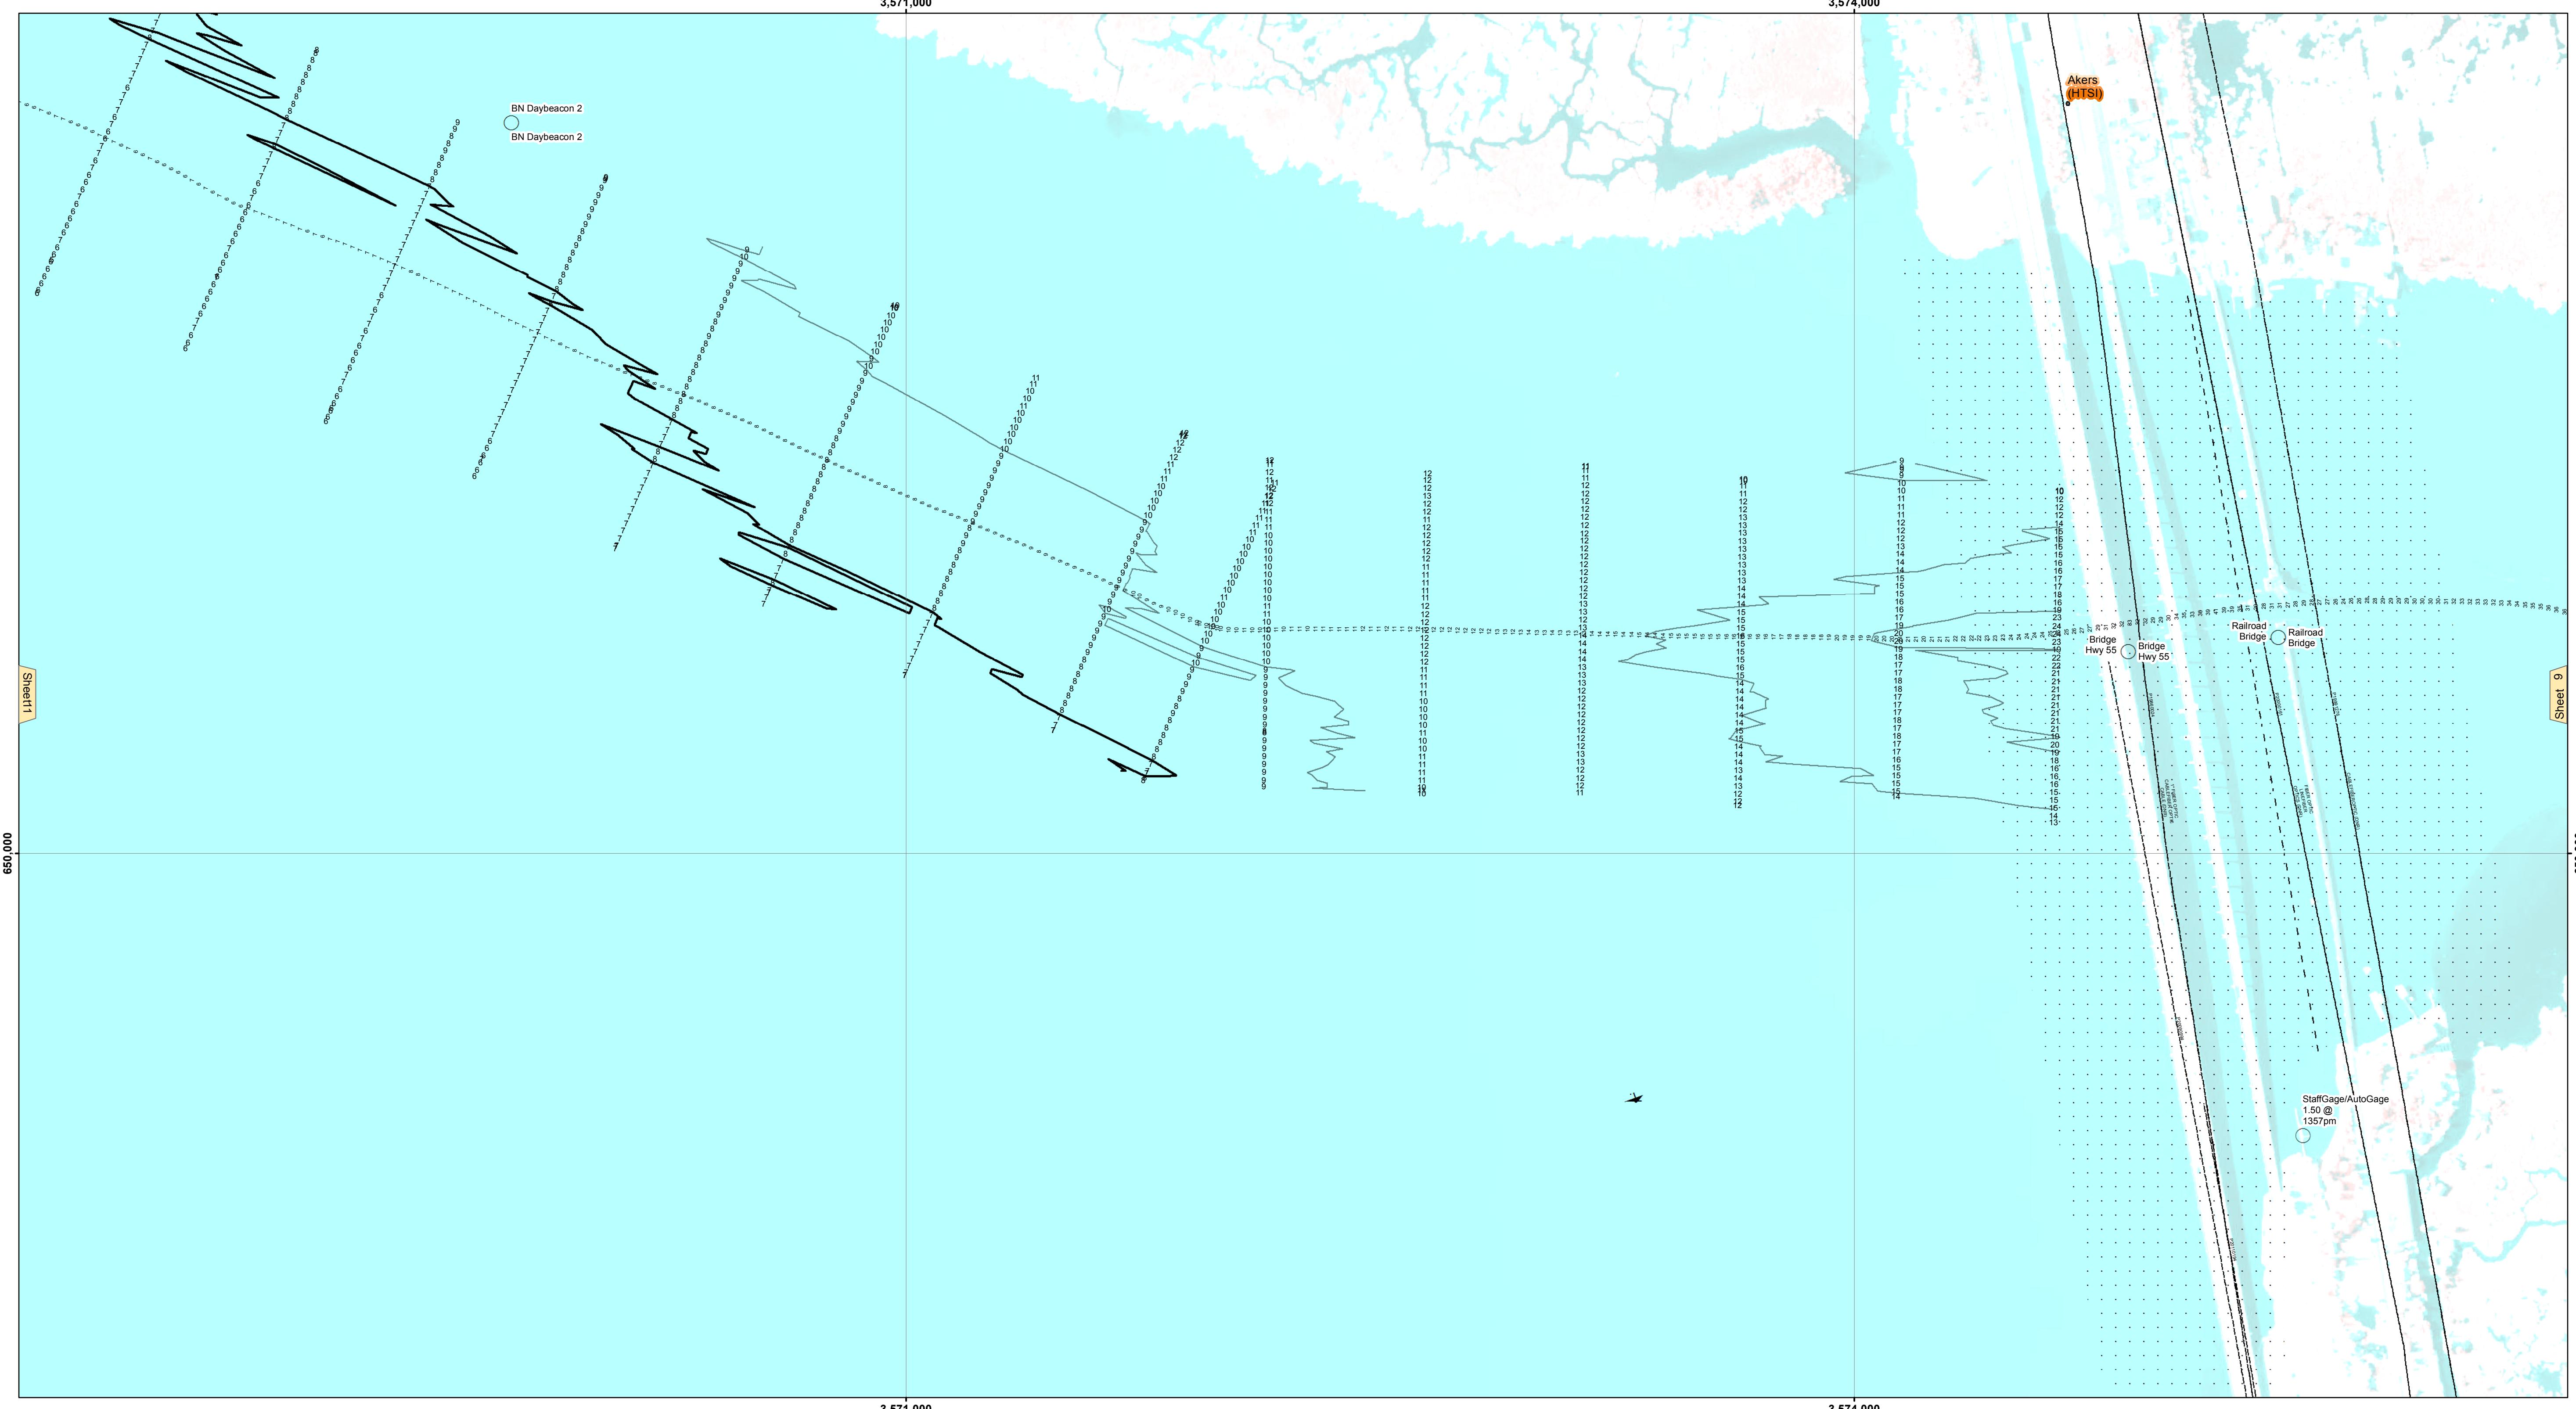

**NOTES:**  
Horizontal Coordinate System: North American Datum of 1983 (NAD83), projected to the State Plane Coordinate System (SPCS), Louisiana South Zone. Distance units in U.S. Survey Feet.  
Vertical Datum: Soundings are shown in feet and indicate depths below North American Vertical Datum of 1988 (NAVD88).  
The location of navigation aids are base on and provided by the U.S. Coast Guard.  
2010 Aerial Photography data source: NAIP Louisiana.  
Reference is N.O.A.A. Navigation Chart No. 11369.  
\*\* Shoal sounding per quarter per reach.  
\*\*\* High frequency (200 kHz) survey data represents the first signal return at a sounding location and will include suspended solids, known as "fuzz" if present. Low frequency (20 kHz) survey data normally penetrates through this "fuzz" layer to depict elevations of consolidated bottom material. Low frequency accuracies may vary depending on channel conditions and fathometer settings.

**Sheet Reference Number**  
**10 of 16**



Revision Number:  
3.8.0-20150202




**DISCLAIMER**  


U.S. ARMY CORPS OF ENGINEERS NEW ORLEANS DISTRICT	
Surveyed By: SPM	Submitted:
Plotted By: AO	Recommended: Chief Survey Section
Checked By: RN	Approved: Chief Waterways Maintenance Section

**NORTHSORE WATERWAYS  
PASS MANCHAC / NORTH PASS  
NS\_07\_MAN\_20160414\_PM  
14 April 2016**

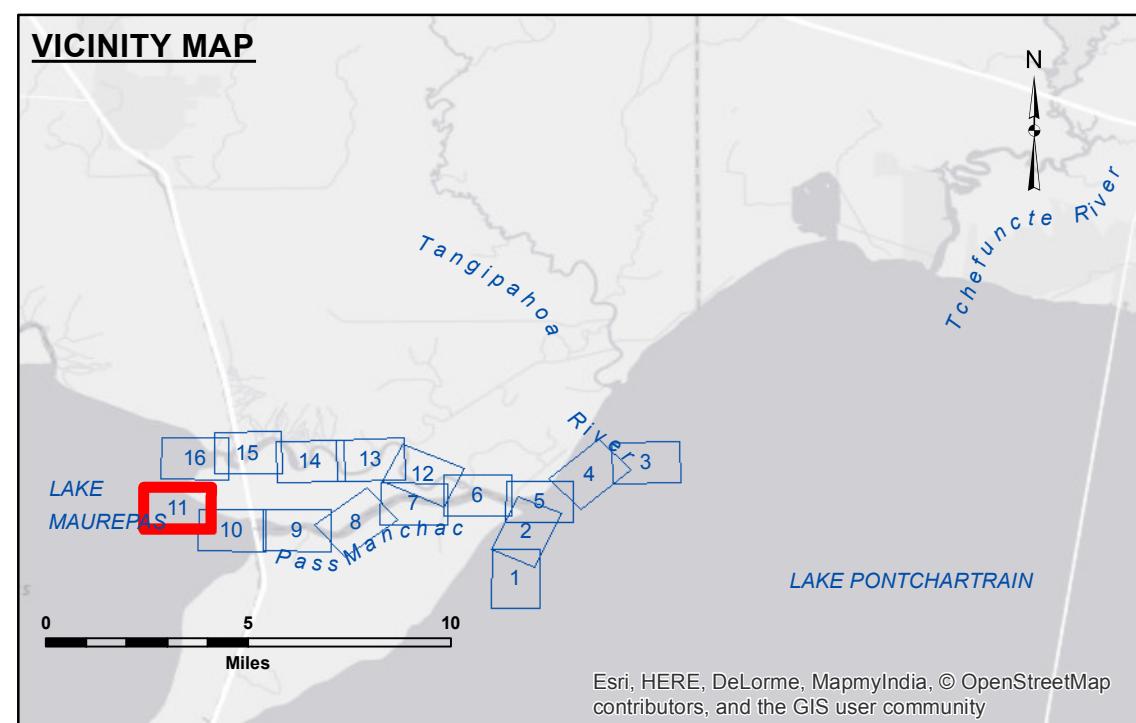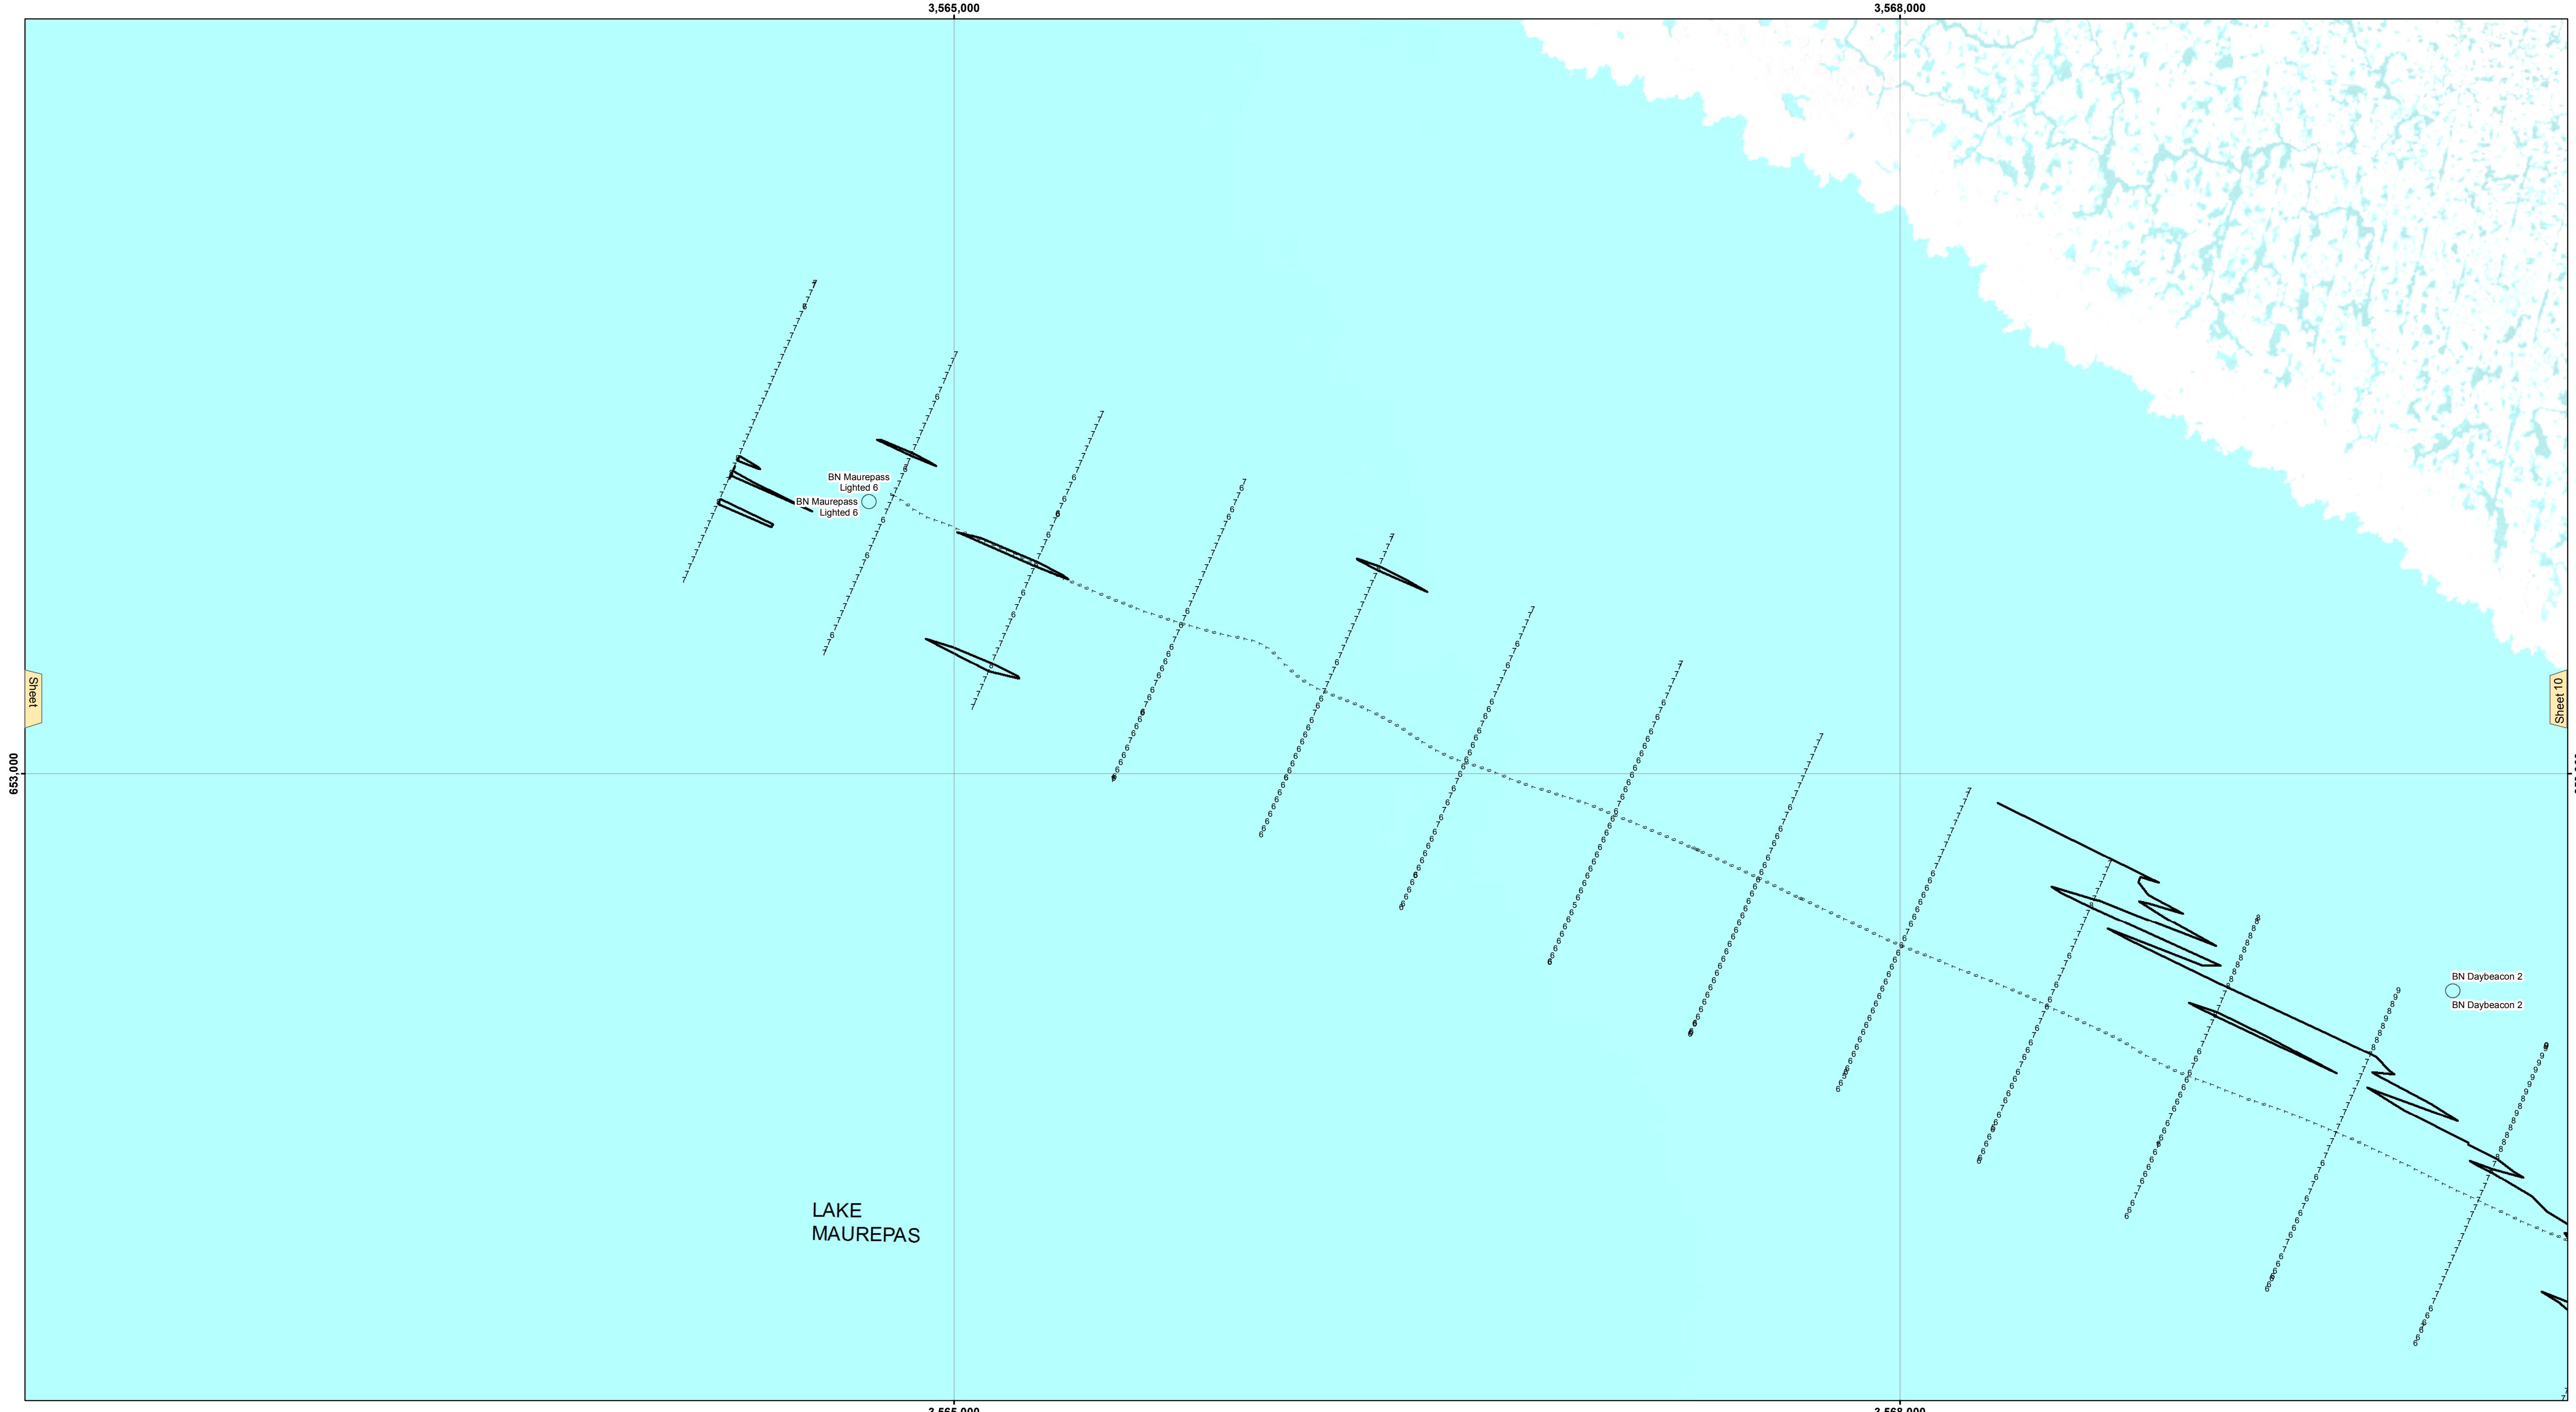

<u>LEGEND</u>	
— Federal Navigation Channel	○ Cable Area
— Federal Navigation Center Line	■ Placement Area
— As-built Pipeline/Cable	□ Anchorage Area
..... Unconfirmed Pipeline/Cable	⊗ Obstruction Point
— Project Depth Contour	♂ Wrecks-Submerged
	■ Borrow Area
	● Shoalest Sounding**
	★ Beacon, General
	◆ Red Navigation Buoy
	◆ Green Navigation Buoy

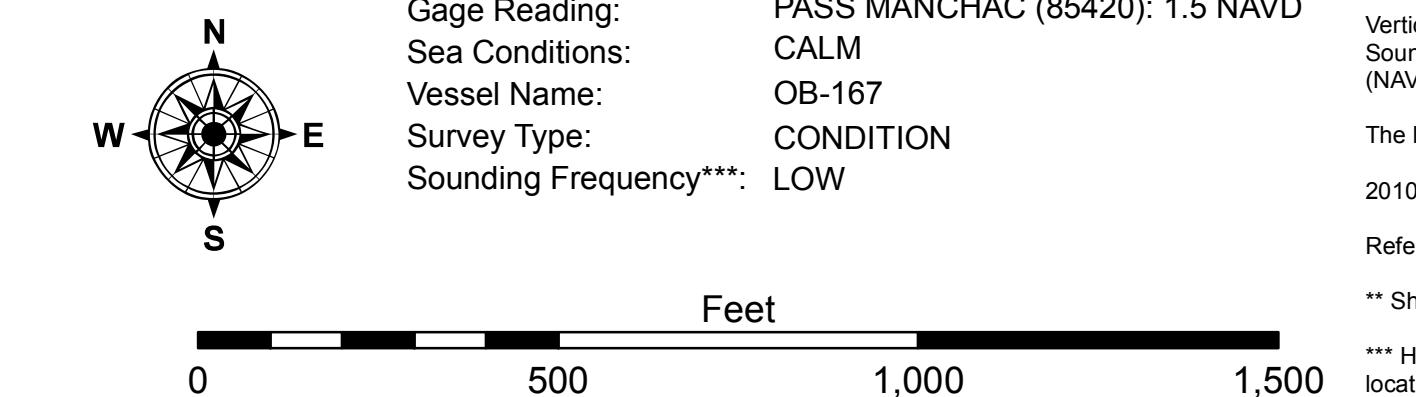

Gage Reading: PASS MANCHAC (85420): 1.5 NAVD  
Sea Conditions: CALM  
Vessel Name: OB-167  
Survey Type: CONDITION  
Sounding Frequency\*\*\*: LOW

**NOTES:**  
Horizontal Coordinate System: North American Datum of 1983 (NAD83), projected to the State Plane Coordinate System (SPCS), Louisiana South Zone. Distance units in U.S. Survey Feet.  
Vertical Datum: Soundings are shown in feet and indicate depths below North American Vertical Datum of 1988 (NAVD88).

The location of navigation aids are base on and provided by the U.S. Coast Guard.  
2010 Aerial Photography data source: NAIP Louisiana.

Reference is N.O.A.A. Navigation Chart No. 11369.

\*\* Shoalest Sounding per Quarter per Reach.

\*\*\* High frequency (200 kHz) survey data represents the first signal return at a sounding location and will include suspended solids, known as "fuzz" if present. Low frequency (20 kHz) survey data normally penetrates through this "fuzz" layer to depict elevations of consolidated bottom material. Low frequency accuracies may vary depending on channel conditions and fathometer settings.

**Sheet Reference Number**  
**11 of 16**

Revision Number:  
3.8.0-20150202



**DISCLAIMER**  
Access Constraints: The data represents the results of data collection processing of a specific US Army Corps of Engineers survey and does not represent the general existing conditions. As such, the data is not to be used for engineering or design purposes without understanding that the US Government makes no warranties, expressed or implied, concerning the data or its suitability for any particular purpose. The United States shall be responsible for any damages resulting from the use of the data. The user is responsible for the results of any application of the data to other than its intended purpose.

Data Constraints: Hydrographic survey data is subject to change rapidly due to several factors including but not limited to dredging operations, subsidence, and changes in water levels. The United States shall make no representations concerning the hydrographic conditions which develop after the date of publication. This data is intended for U.S. Army Corps of Engineers' internal use and shall not be considered reliable. The information depicted on this map represents the results of a survey conducted on the date indicated and can only be considered to represent the general condition existing at that time.

U.S. ARMY CORPS OF ENGINEERS	
NEW ORLEANS DISTRICT	
Submitted:	Surveyed By: SPM
Recommended:	Plotted By: AO
Approved:	Checked By: RN
Chief, Waterways Maintenance Section	

**NORTHSORE WATERWAYS**  
**PASS MANCHAC / NORTH PASS**  
**NS\_07\_MAN\_20160414\_PM**  
**14 April 2016**