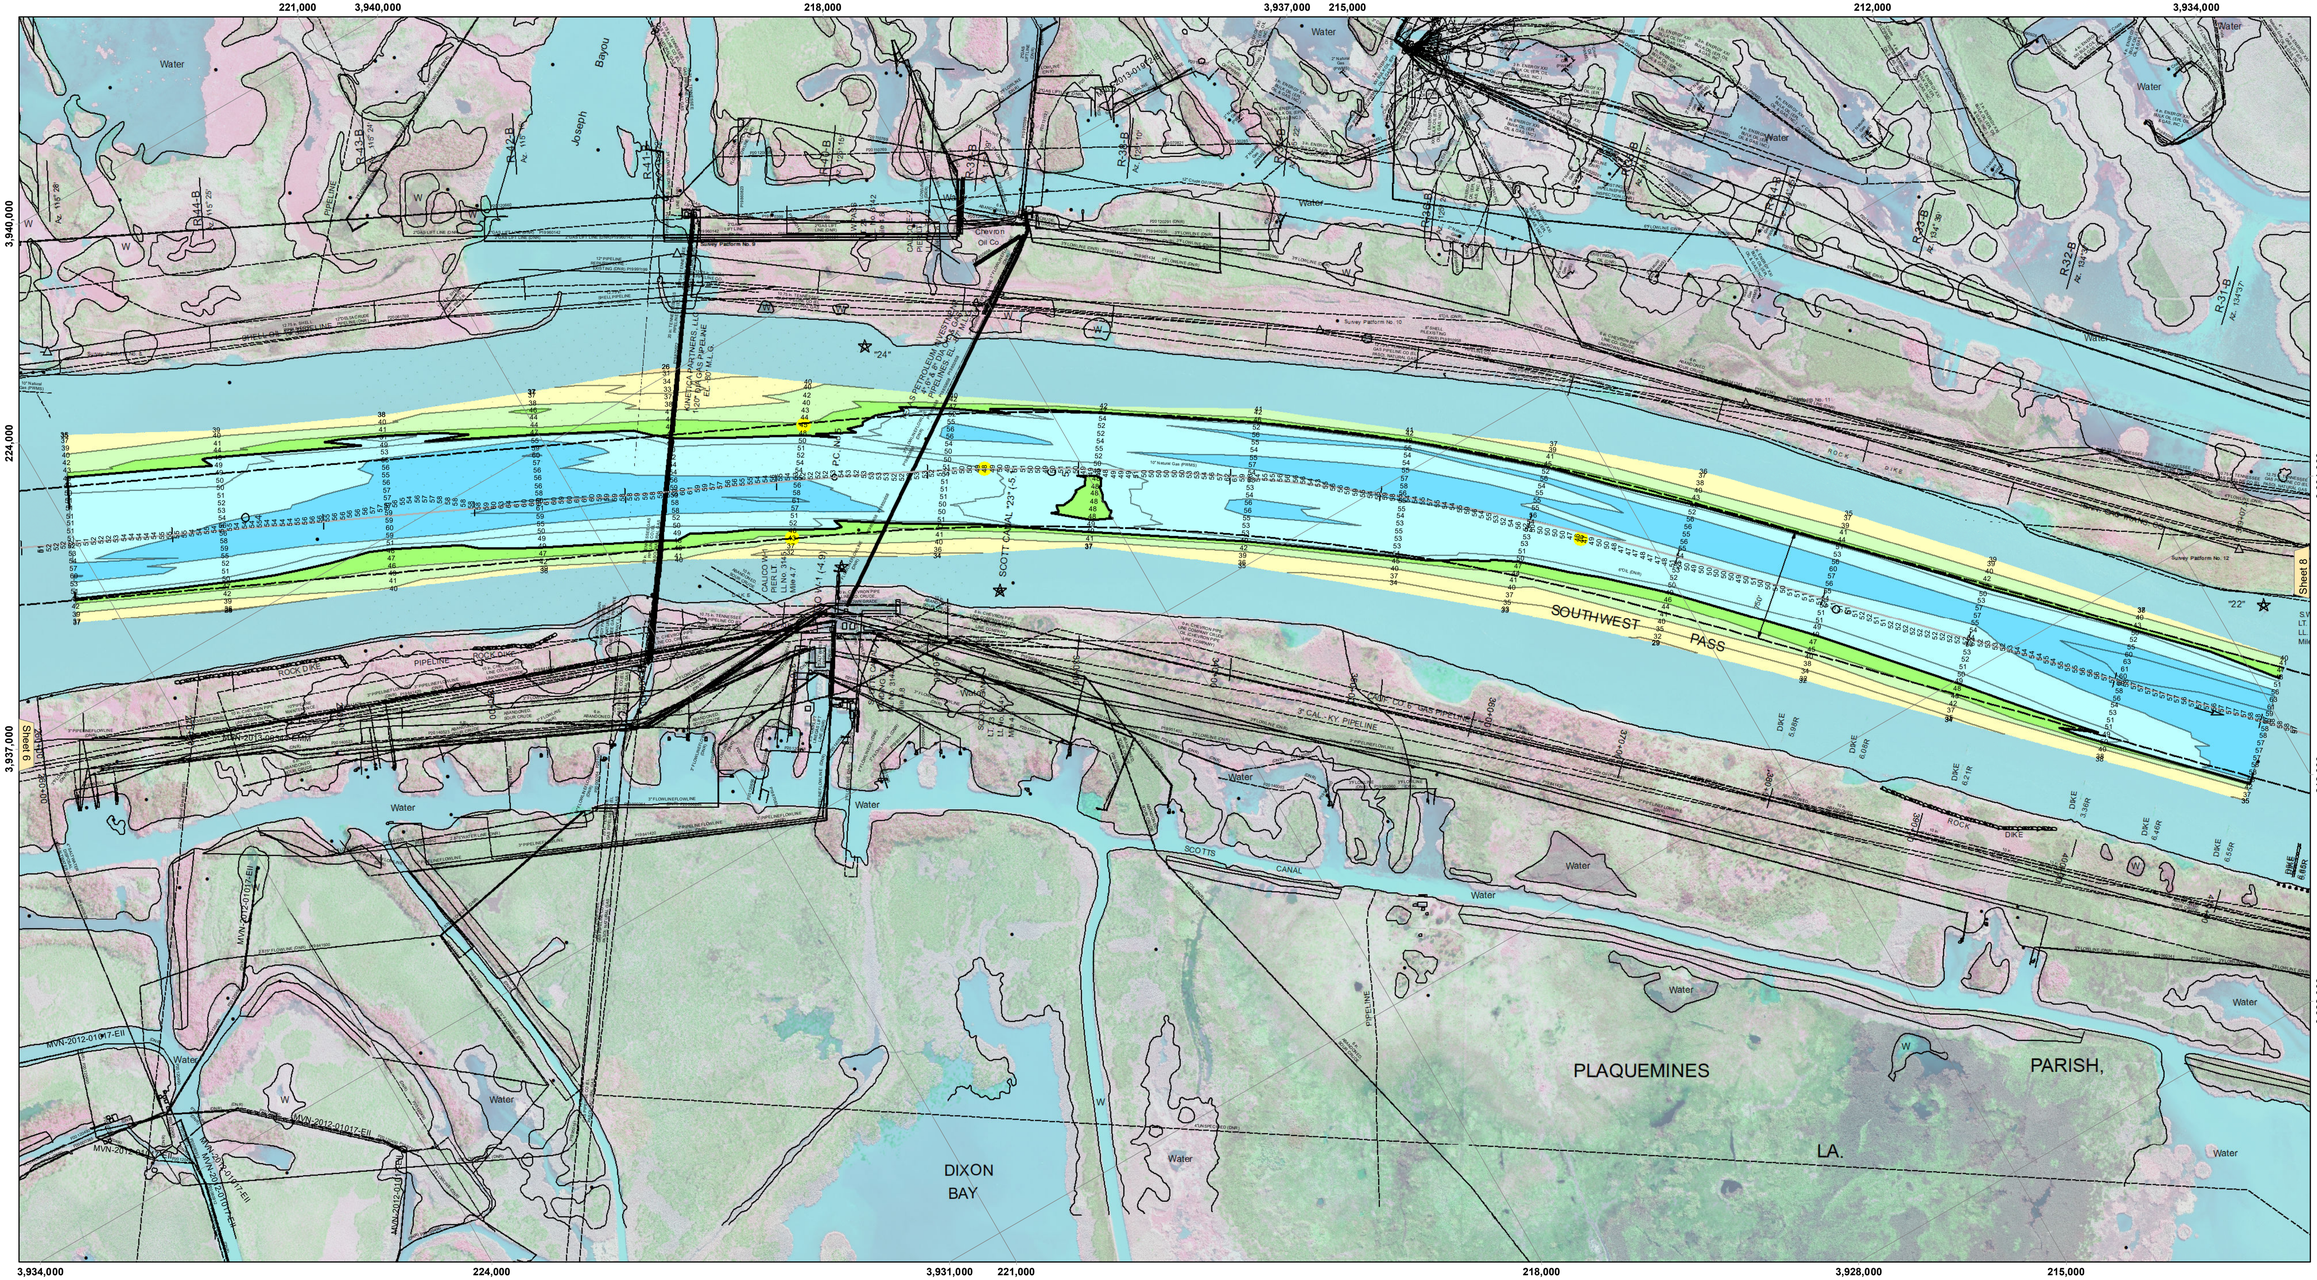


US Army Corps of Engineers
District: CEMVN

Distribution Liability: The data represents the results of data acquisition and processing efforts at the time of survey activity and indicates the general existing conditions. As such, it is only valid for its intended use; content, time and accuracy of the data may not be valid for any other use. The use of any of the application of the data for other than its intended purpose.

Data Constraints: Hydrographic survey data is subject to change due to environmental conditions including but not limited to activity and natural shoaling and scouring processes. The U. S. Army Corps of Engineers assumes no responsibility for changes in the hydrographical conditions which develop after the date of publication. This data is intended for U. S. Army Corps of Engineers' internal use. Reuse by external sources is done at its sole discretion.

DISCLAIMER
Access Constraints: The United States Government furnishes this map and the data contained therein to expedite access understanding that the US Government makes no warranties, expressed, or implied concerning the accuracy, completeness, reliability, or suitability of this information and the data furnished. The United States shall be under no liability whatsoever to any individual or group using the information and the data furnished. The United States shall be made thereof. These data belong to the Government. Therefore the recipient fully agrees not to represent these data to anyone as other than government data. Any liability arising from the use of these data to others without also transferring this Disclaimer.

The information depicted on this map represents the results of a survey conducted on the date indicated and can only be considered a representative general condition existing at that time.

U.S. ARMY CORPPS OF ENGINEERS
NEW ORLEANS DISTRICT

| | | |
|---|---|---|
| Submitted | Surveyed By: JTB & DBD | |
| | Plotted By: TSS | |
| Recommended: Chief, Survey Section | | |
| Approved: Chief, Waterways Maintenance Section | Checked By: IMSK | |

**MISSISSIPPI RIVER - B.R. TO GULF**
**SOUTHWEST PASS - SHEET 7**
**SW_07_SWP_20190507_CS**
**07 May 2019**

**Sheet Reference Number**
7 **of** 13

Revison Number:
3.12-20160811

**VICINITY MAP**




**LEGEND**

- Federal Navigation Channel
- Federal Navigation Center Line
- As-built Pipeline/Cable
- Unconfirmed Pipeline/Cable
- Project Depth Contour
- Cable Area
- Placement Area
- Anchorage Area
- Obstruction Point
- Wrecks-Submerged
- Borrow Area
- Shoalest Sounding**
- Beacon, General
- Red Navigation Buoy
- Green Navigation Buoy
- -10' and above
- -10' to -20'
- -20' to -30'
- -30' to -40'
- -40' to -45'
- -45' to -48.5'
- -48.5' to -55'
- -55' and below

| | |
|---|---|
| Gage Reading: | 2.8 MLLW @ HEAD OF PASSES @ 1050 |
| Sea Conditions: | CHOPPY |
| Vessel Name: | BLANCHARD |
| Survey Type: | CONDITION, SB |
| Sounding Frequency***: | LOW |

Feet
0 500 1,000 1,500 2,000 2,500

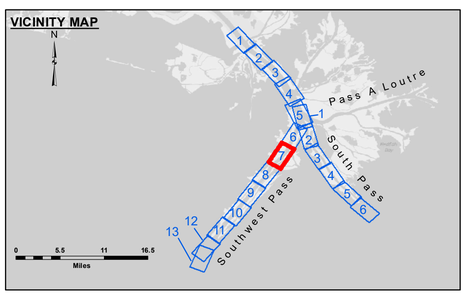**NOTES:**

Horizontal Coordinate System:
North American Datum of 1983 (NAD83), projected to the State Plane Coordinate System (SPCS), Louisiana South Zone. Distance units in U.S. Survey Feet.

Vertical Datum:
Soundings are shown in feet and indicate depths below Mean Lower Low Water (MLLW, 07-11).
Datum Relationships for gage 01545 as of July 2015:
0.0' NAVD88 = -0.18' MLLW = 3.32' MLG

Distances on the Mississippi River, above and below Head of Passes are shown at 1 mile intervals.

The location of navigation aids are base on and provided by the U.S. Coast Guard.

2016 Aerial Photography data source: Precision Aerial Reconnaissance, LLC (1998 DOQQ in green)

Reference is N.O.A.A. Navigation Chart No. 11361.

** Shoalest Sounding per Quarter per Reach.

*** High frequency (200 kHz) survey data represents the first signal return at a sounding location and will include suspended solids, known as "fluff", if present. Low frequency (24 kHz) survey data normally penetrates through this "fluff" layer to depict elevations of consolidated bottom material. Low frequency accuracies may vary depending on channel conditions and fathometer settings.