

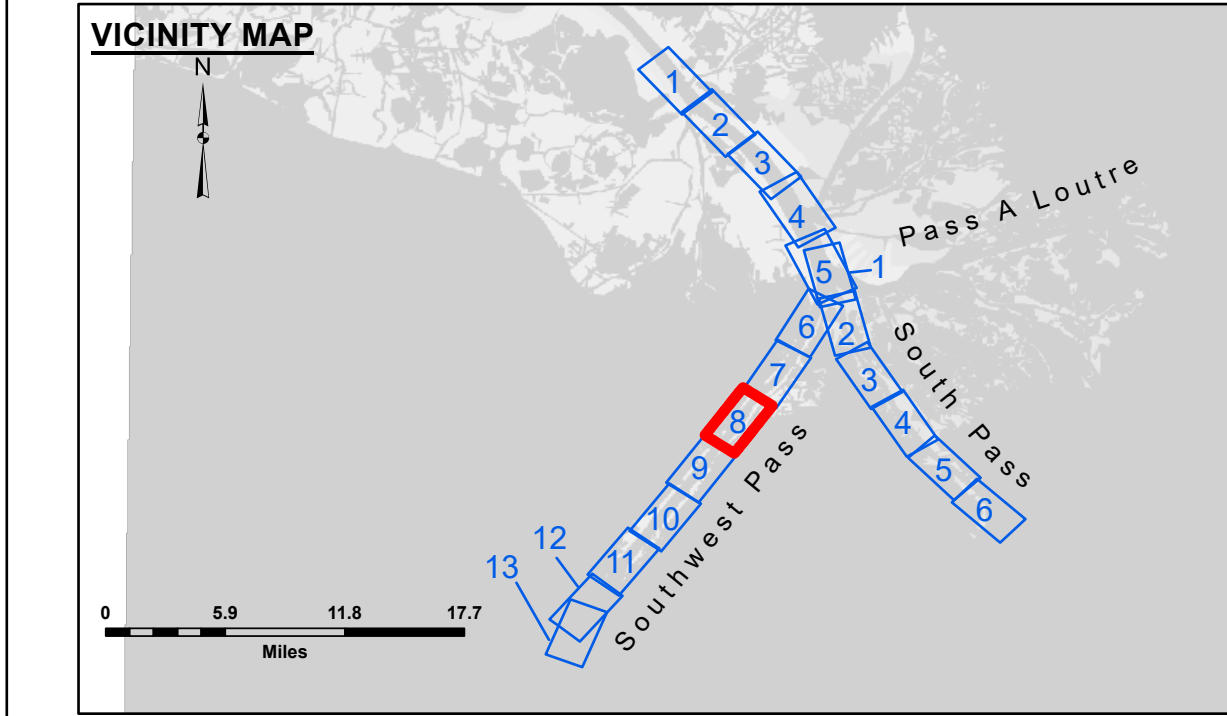


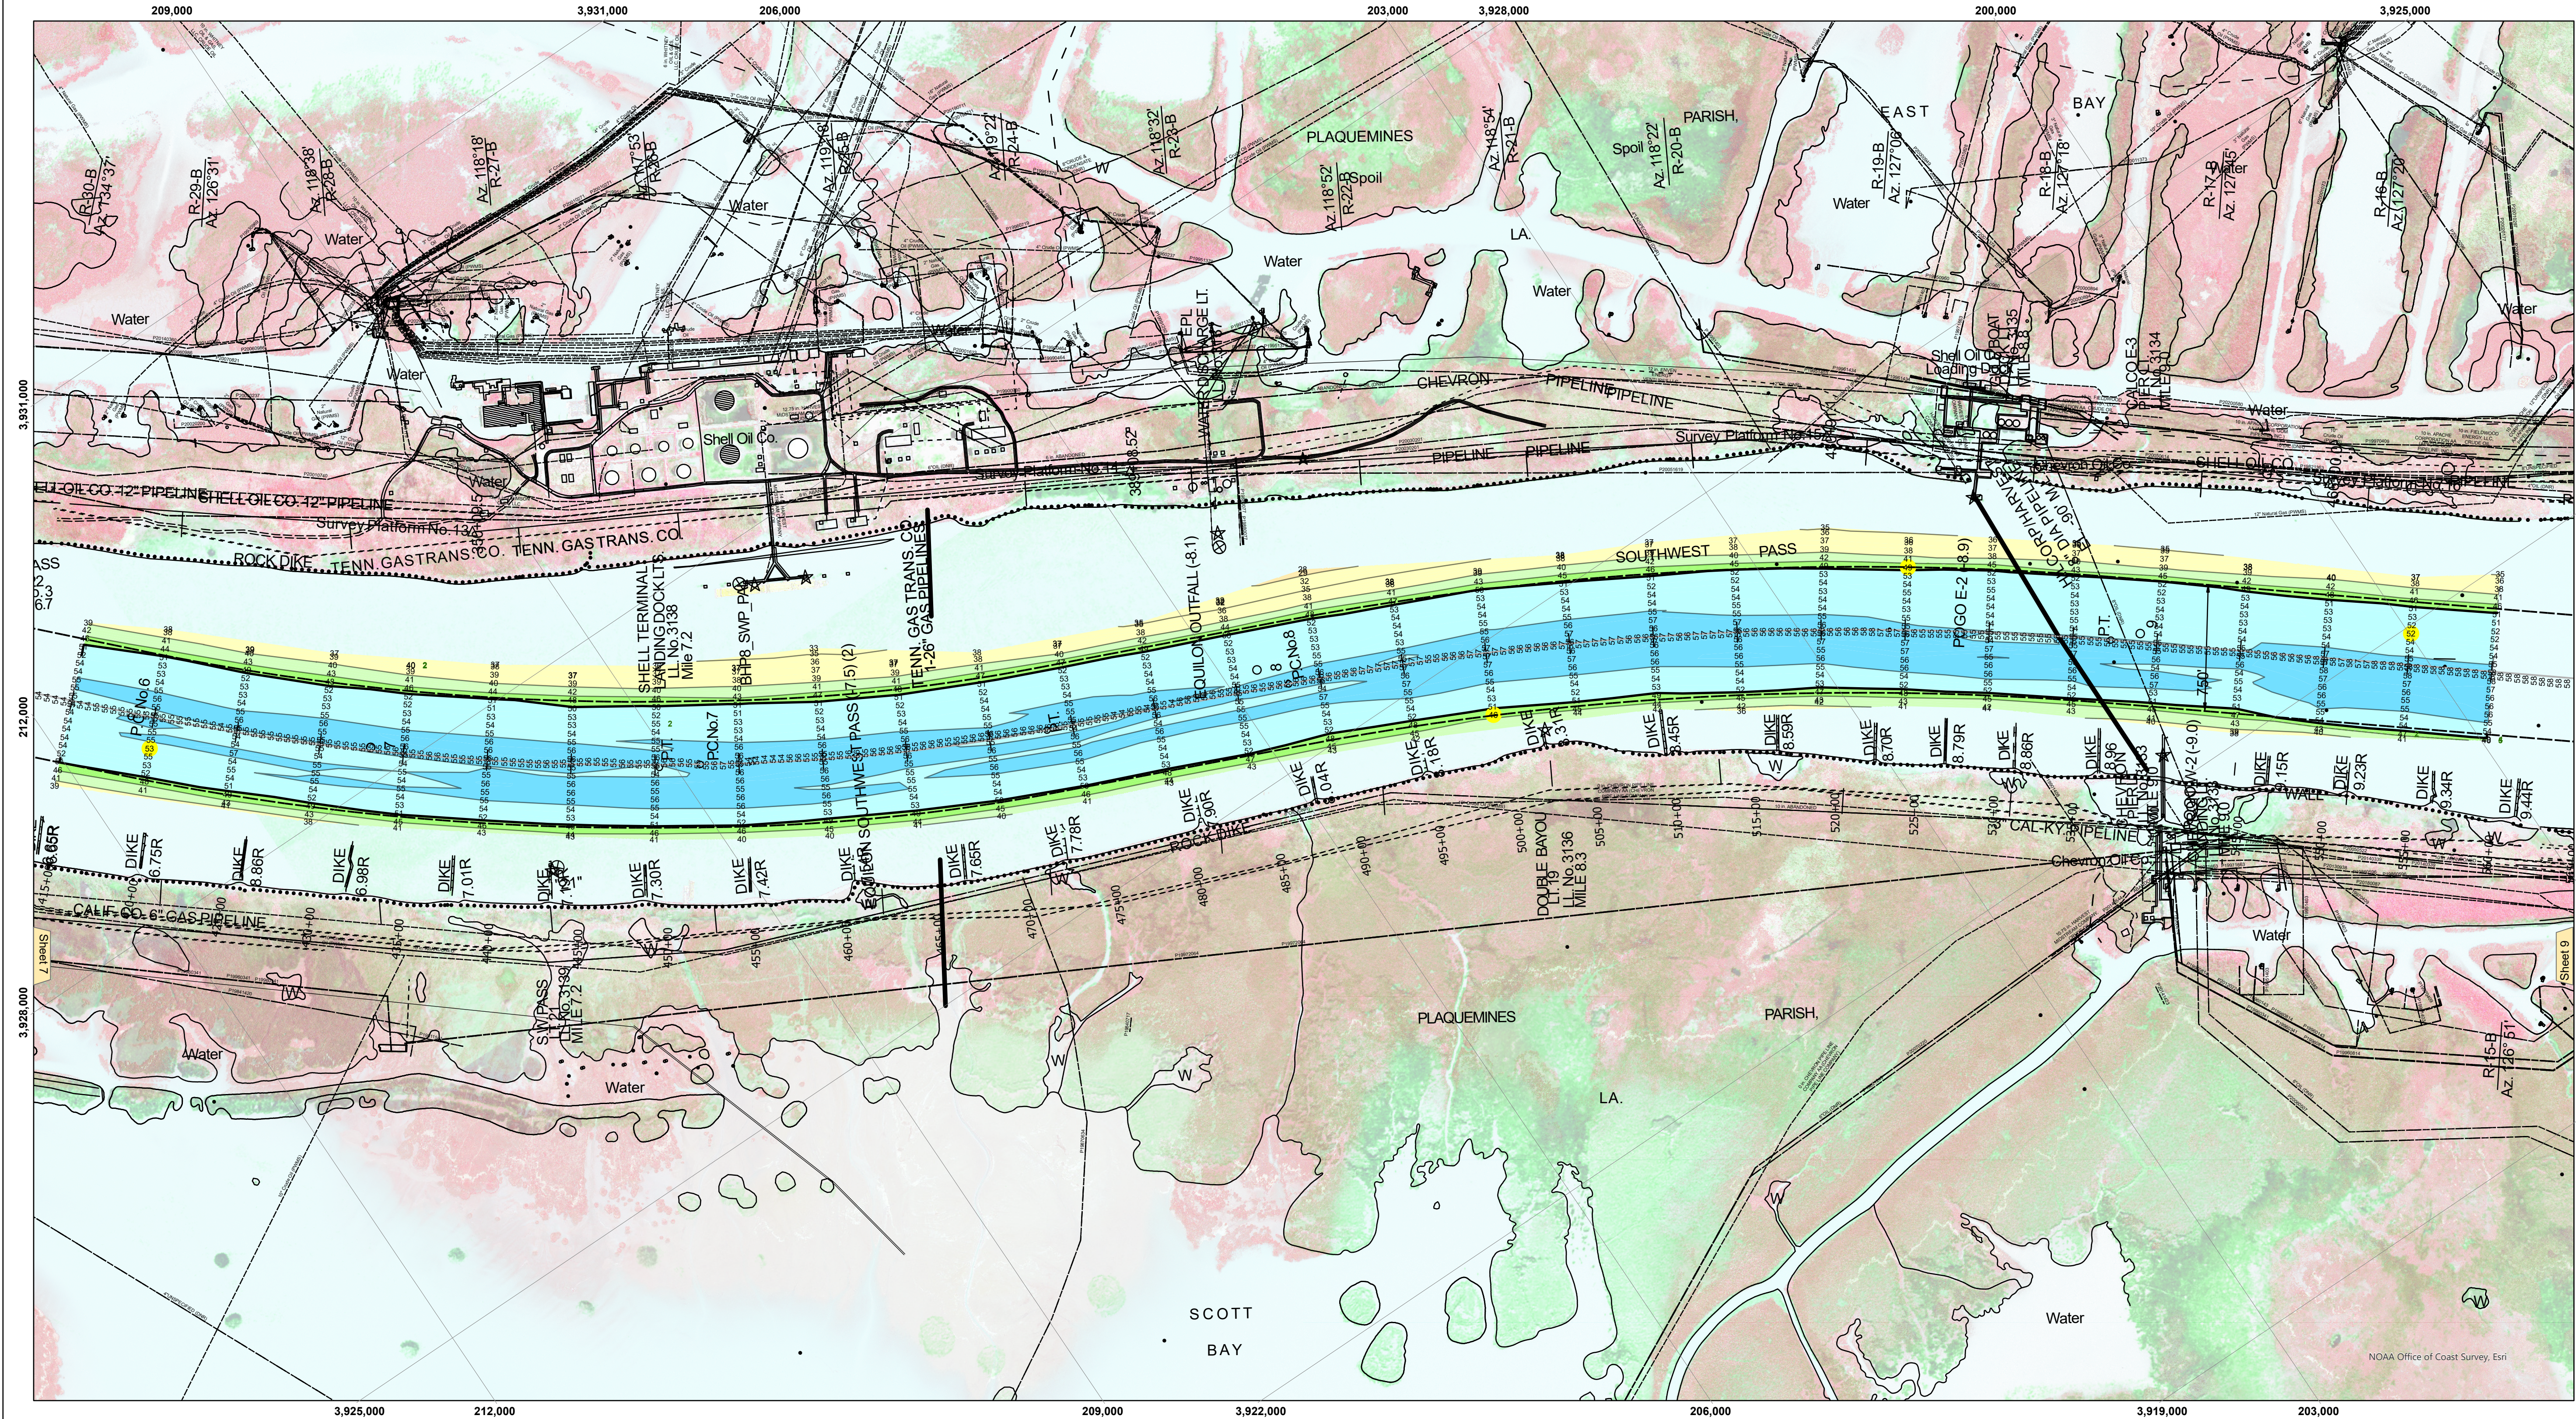

LEGEND

- Federal Navigation Channel
- Federal Navigation Center Line
- As-built Pipeline/Cable
- Unconfirmed Pipeline/Cable
- Project Depth Contour
- Cable Area
- Placement Area
- Anchorage Area
- ⊗ Obstruction Point
- ★ Wrecks-Submerged
- 3 Fluff Thickness (feet)*
- Borrow Area
- Shoalest Sounding**
- ★ Beacon, General
- ◆ Red Navigation Buoy
- ◆ Green Navigation Buoy
- -10' and above
- -10' to -20'
- -20' to -30'
- -30' to -40'
- -40' to -45'
- -45' to -50'
- -50' to -55'
- -55' and below

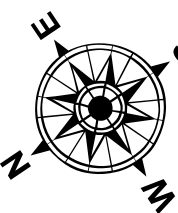

Gage Reading:
Sea Conditions:
Vessel Name:
Survey Type:
Sounding Frequency***:

0.0 MLLW @ MM 7.5 LT-21 (01575) @ 1040
CALM
BLANCHARD
CONDITION, SB
LOW

Vertical Datum:
SOUNDINGS
Datum Relationships for gage 01575 as of February 2021:
0.0' NAVD88, 2009.55 = 0.10' MLLW = 3.60' MLG

Distances on the Mississippi River, above and below Head of Passes are shown at 1 mile intervals.

The location of navigation aids are base on and provided by the U.S. Coast Guard.

2024 Aerial Photography data source: Optimal GEO (1998 DOQQ in green)

Reference is N.O.A.A. Navigation Chart No. 11361.

** Shoalest Sounding per Quarter per Reach.

*** High frequency (200 kHz) survey data represents the first signal return at a sounding location and will include suspended solids, known as "fluff", if present. Low frequency (24 kHz) survey data normally penetrates through this "fluff" layer to depict elevations of consolidated bottom material. Low frequency accuracies may vary depending on channel conditions and fathometer settings.

Feet

0 500 1,000 1,500 2,000 2,500

NOTES:

Horizontal Coordinate System:
North American Datum of 1983 (NAD83), projected to the State Plane
Coordinate System (SPCS), Louisiana South Zone. Distance units in U.S. Survey Feet.








U.S. ARMY CORPS OF ENGINEERS NEW ORLEANS DISTRICT			
Submitted:	Surveyed By: RCB & DBD	Plotted By: PLOTED_BY	Checked By: MSK
Recommended:	Chief, Survey Section		Chief, Waterways Maintenance Section
Approved:			

MISSISSIPPI RIVER - B.R. TO GULF
SOUTHWEST PASS - SHEET 8
SW_08_SWPX_20251209_CS
09 December 2025

Sheet
Reference
Number
8 of 13

Revision Number:
5.23.12.3-5.23.12.3

US Army Corps of Engineers
District: CEMVN

DISCLAIMER
The data represented by this map is the result of data collected for a specific US Army Corps of Engineers activity and indicates the general existing conditions. As such, the data is not intended for use in any other application. The user is responsible for the results of any application of the data for other than its intended purpose. The data is not intended for use in any other application. The user is responsible for the results of any application of the data for other than its intended purpose.

