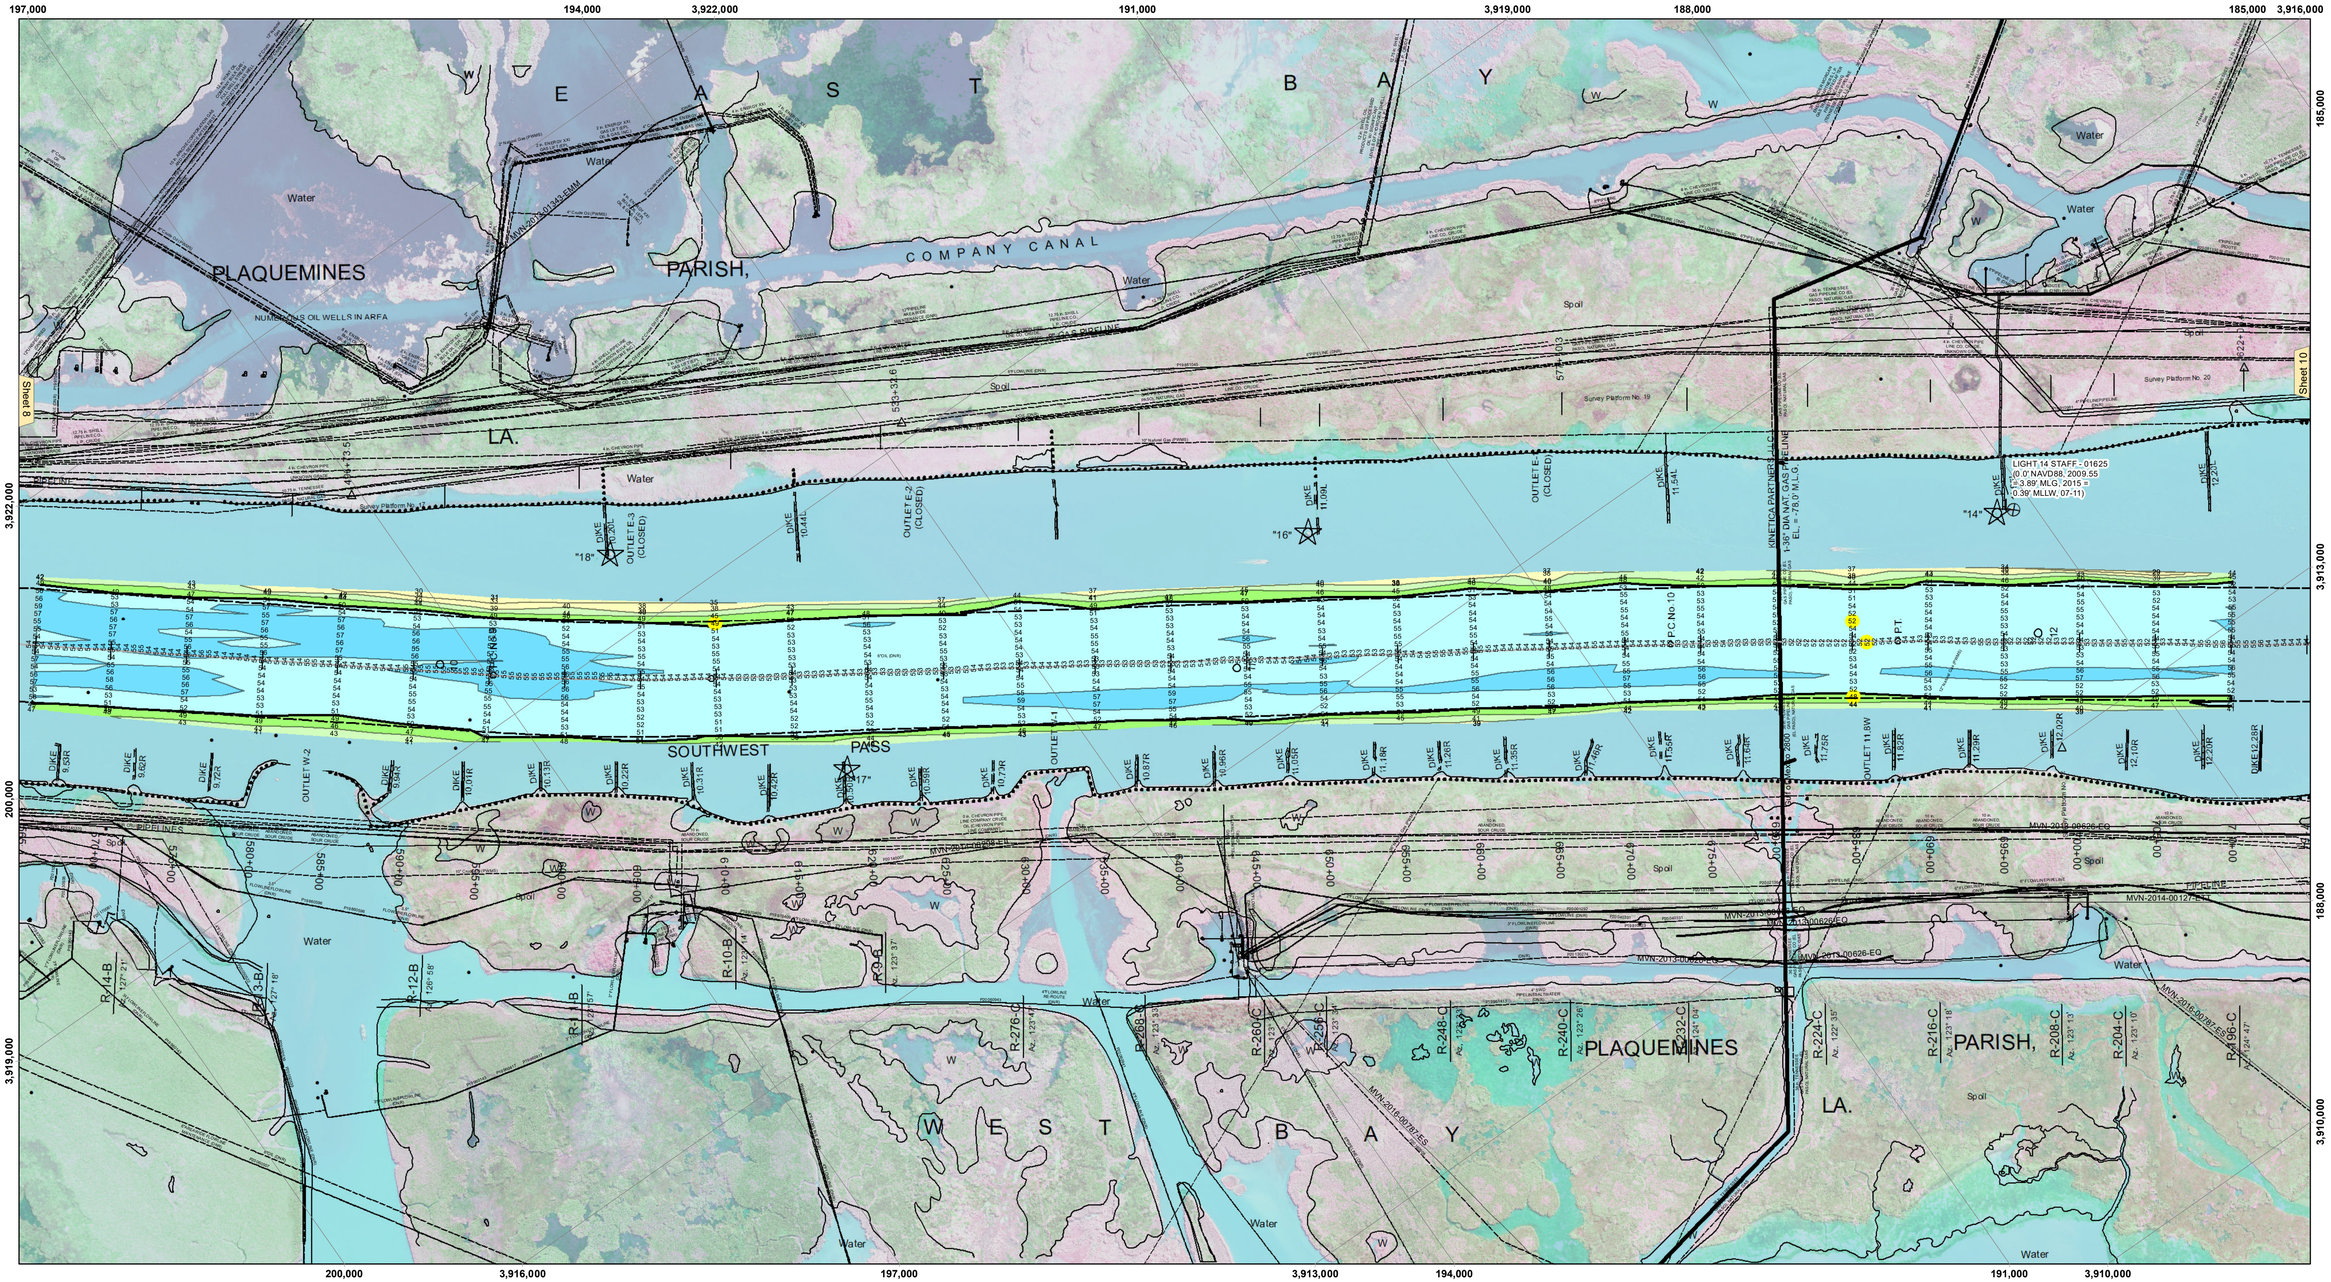

US Army Corps of Engineers
District: CEMVN

Distribution Liability: The data represents the results of data collection and analysis at the time and under the conditions activity and indicates the general existing conditions. As such, it is only valid for its intended use, content, time and accuracy and is not to be used for any purpose other than that stated. Use of any of the application of the data for other than its intended purpose.

Data Constraints: Hydrographic survey data is subject to change over time due to environmental processes such as shoaling activity and natural shoaling and scouring processes. The U. S. Government makes no warranties, expressed or implied, concerning the accuracy, completeness, reliability, or suitability of the information and the data furnished. The United States shall be held harmless from any liability arising from any inaccuracies in the data made thereof. These data belong to the Government. Therefore the recipient fully agrees not to represent these data to anyone as other than data furnished by the Government and to indemnify the Government from any and all claims arising from the redistribution of these data to others without also transferring this Disclaimer.

DISCLAIMER
Access Constraints: The United States Government furnishes this map and the data contained therein to the user/purchaser's understanding that the US Government makes no warranties, expressed, or implied concerning the accuracy, completeness, reliability, or suitability of the information and the data furnished. The United States shall be held harmless from any liability arising from any inaccuracies in the data made thereof. These data belong to the Government. Therefore the recipient fully agrees not to represent these data to anyone as other than data furnished by the Government and to indemnify the Government from any and all claims arising from the redistribution of these data to others without also transferring this Disclaimer.

The information depicted on this map represents the results of a survey conducted on the date indicated and can only be considered to represent the general conditions existing at that time.

U.S. ARMY CORPS OF ENGINEERS
NEW ORLEANS DISTRICT

Surveyed By: JTB & DBD	Plotted By: TSS	Checked By: MSK

Submitted:
Recommended: Chief, Survey Section
Approved: Chief, Waterways Maintenance Section

MISSISSIPPI RIVER - B.R. TO GULF
SOUTHWEST PASS - SHEET 9
SW_09_SWP_20210601_CS
01 June 2021

Sheet Reference Number
9 **of** 13

Revison Number:
4.1-20191105

VICINITY MAP

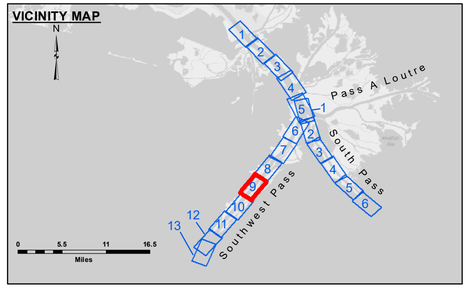

LEGEND

- Federal Navigation Channel
- Federal Navigation Center Line
- As-built Pipeline/Cable
- Unconfirmed Pipeline/Cable
- Project Depth Contour
- Cable Area
- Placement Area
- Anchorage Area
- Obstruction Point
- Wrecks-Submerged
- Borrow Area
- Shoalest Sounding**
- Beacon, General
- Red Navigation Buoy
- Green Navigation Buoy
- -10' and above
- -10' to -20'
- -20' to -30'
- -30' to -40'
- -40' to -45'
- -45' to -50'
- -50' to -55'
- -55' and below

Gage Reading:	1.5 MLLW @ LIGHT 14 @ 1145
Sea Conditions:	CHOPPY
Vessel Name:	BEAUVAIS
Survey Type:	CONDITION, SB
Sounding Frequency***:	LOW

Feet
0 500 1,000 1,500 2,000 2,500

NOTES:

Horizontal Coordinate System:
North American Datum of 1983 (NAD83), projected to the State Plane Coordinate System (SPCS), Louisiana South Zone. Distance units in U.S. Survey Feet.

Vertical Datum:
Soundings are shown in feet and indicate depths below Mean Lower Low Water (MLLW, 12-16).
Datum Relationships for gage 01625 as of March 2020:
0.0' NAVD88, 2009.55 = 0.40' MLLW = 3.90' MLG

Distances on the Mississippi River, above and below Head of Passes are shown at 1 mile intervals.

The location of navigation aids are base on and provided by the U.S. Coast Guard.

2016 Aerial Photography data source: Precision Aerial Reconnaissance, LLC (1998 DOQQ in green)

Reference is N.O.A.A. Navigation Chart No. 11361.

** Shoalest Sounding per Quarter per Reach.

*** High frequency (200 kHz) survey data represents the first signal return at a sounding location and will include suspended solids, known as "fluff", if present. Low frequency (24 kHz) survey data normally penetrates through this "fluff" layer to depict elevations of consolidated bottom material. Low frequency accuracies may vary depending on channel conditions and fathometer settings.